


LOCATION PLAN  
SCALE 1:5000

| LEGEND |                      |
|--------|----------------------|
|        | STREET LIGHT         |
|        | TREE                 |
|        | SUMP                 |
|        | SOAK PIT             |
|        | FENCE                |
|        | GATE                 |
|        | TOBY / WATER LATERAL |
|        | SEWER LATERAL        |

**SURVEY ORIGIN DATA**  
VERTICAL ELEVATIONS ARE IN TERMS OF LYTTTELTON VERTICAL DATUM 1937.  
THE ORIGIN OF LEVELS IS ACE5 RL 57.679m.

HORIZONTAL COORDINATES ARE IN TERMS OF NZ GEODETIC DATUM 2000, MOUNT PLEASANT 2000 CIRCUIT.  
ORIGIN OF SURVEY : IS 1 DP361539  
(798707.47mN 370018.15mE)

THE BOUNDARIES ON THIS PLAN SHOULD NOT BE RELIED UPON BY THEMSELVES, BUT MUST BE VERIFIED AGAINST THE LEGAL SURVEY PLAN BOUNDARIES TO CONFIRM THEIR ACCURACY.

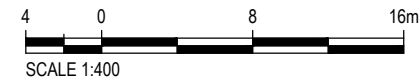

| CLIENT | REV | DATE       | REVISION DETAILS             | APPROVED | DRAWN<br>R. DAWSON   | DESIGNED<br>M.CROWE | PROJECT                   |  | PRELIMINARY<br>NOT FOR CONSTRUCTION |  |
|--------|-----|------------|------------------------------|----------|----------------------|---------------------|---------------------------|--|-------------------------------------|--|
|        |     |            |                              |          | CHECKED<br>K ASHBY   |                     | STONEBROOK ROLLESTON      |  | PROJECT No.                         |  |
|        |     |            |                              |          | APPROVED             |                     |                           |  | 224926                              |  |
|        |     |            |                              |          |                      |                     |                           |  | SCALE                               |  |
|        |     |            |                              |          | B TOMS<br><br>B.TOMS |                     | TITLE                     |  | SIZE                                |  |
|        |     |            |                              |          |                      |                     | SITE LEVELS<br>LOTS 20-23 |  | 1:400                               |  |
|        |     |            |                              |          |                      |                     |                           |  | DRAWING No.                         |  |
|        | B   | 21/01/2019 | AS-BUILT SEWER & WATER ADDED | B TOMS   |                      |                     |                           |  | DW-SU-SP-005                        |  |
|        | A   | 29/10/18   | ISSUE FOR INFORMATION        | B TOMS   |                      |                     |                           |  | REV                                 |  |
|        |     |            |                              |          |                      |                     |                           |  | B                                   |  |