


LOTS 24 & 25

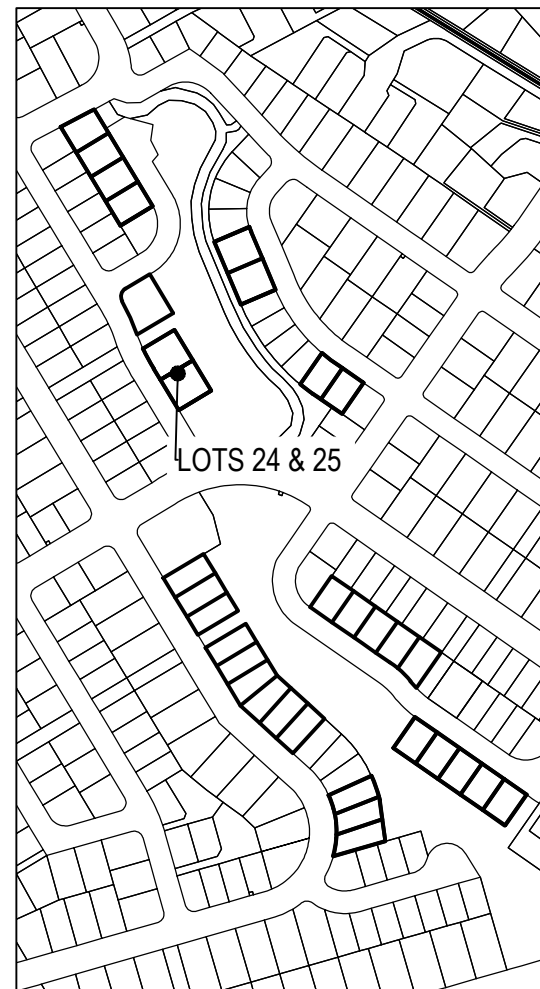

LOCATION PLAN  
SCALE 1:5000

LEGEND	
	STREET LIGHT
	TREE
	SUMP
	SOAK PIT
	FENCE
	GATE
	TOBY / WATER LATERAL
	SEWER LATERAL

**SURVEY ORIGIN DATA**  
 VERTICAL ELEVATIONS ARE IN TERMS OF LYTTELTON VERTICAL DATUM 1937.  
 THE ORIGIN OF LEVELS IS ACE5 RL 57.679m.

HORIZONTAL COORDINATES ARE IN TERMS OF NZ GEODETIC DATUM 2000, MOUNT PLEASANT 2000 CIRCUIT.  
 ORIGIN OF SURVEY : IS 1 DP361539  
 (798707.47mN 370018.15mE)

THE BOUNDARIES ON THIS PLAN SHOULD NOT BE RELIED UPON BY THEMSELVES, BUT MUST BE VERIFIED AGAINST THE LEGAL SURVEY PLAN BOUNDARIES TO CONFIRM THEIR ACCURACY.



000000



CLIENT		REV	DATE	REVISION DETAILS	APPROVED	DRAWN	DESIGNED	PROJECT	PRELIMINARY NOT FOR CONSTRUCTION
						R. DAWSON	M. CROWE	STONEBROOK ROLLESTON	PROJECT No. 224926
						CHECKED K. ASHBY		TITLE	SCALE 1:400
						APPROVED		SITE LEVELS LOTS 24 & 25	SIZE A3
						B. TOMS	DATE 29/10/2018		DRAWING No. DW-SU-SP-006
B	21/01/2019	AS-BUILT SEWER & WATER ADDED		B TOMS		B. TOMS			REV B
A	29/10/18	ISSUE FOR INFORMATION		B TOMS					