

LEGEND

- ▬ SUB-STAGE R1 BOUNDARY
- ▬ STORMWATER TO STREET
- ▬▬▬ DOUBLE SUMP
- ▬ SINGLE SUMP
- ▬ CORNER SUMP
- ▬ SEWER LATERAL TO MAINS
- ▬ WATER SUBMAIN



CLIENT




REV	DATE	REVISION DETAILS	APPROVED
A	04/03/19	ISSUE FOR INFORMATION	K ASHBY

PROJECT
PRESTONS PARK

TITLE
**AS-BUILT SEWER AND STORMWATER
SUBSTAGE R1
STAGE 2**

DRAWN	DESIGNED	INFORMATION	
R DAWSON	C DOHERTY	CHECKED	PROJECT No.
D ROBINSON		APPROVED	235361
		DATE	SCALE
			1:500
		DRAWING No.	SIZE
		AB-PS-S2-SP-08	A1
			REV
			A

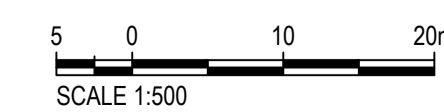

000000