

LEGEND

- SUB-STAGE X BOUNDARY
- STORMWATER TO STREET
- ▬▬▬ DOUBLE SUMP
- SINGLE SUMP
- CORNER SUMP
- SEWER LATERAL TO MAINS
- WATER SUBMAIN

aurecon
www.aurecongroup.com

CLIENT




REV	DATE	REVISION DETAILS	APPROVED
A	17/10/18	ISSUE FOR INFORMATION	K ASHBY

PROJECT
PRESTONS PARK

TITLE
**AS BUILT SEWER & STORMWATER
SUBSTAGE U1
STAGE 2**

DRAWN A GRAY	DESIGNED C DOHERTY	PRELIMINARY NOT FOR CONSTRUCTION
CHECKED M CROWE	APPROVED	PROJECT No. 235361
APPROVED K ASHBY	DATE	SCALE 1:500
		SIZE A1
		DRAWING No. AB-PS-S2-SP-07
		REV A

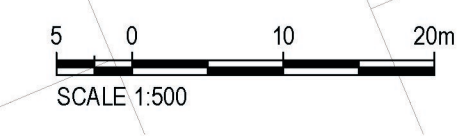

000000