


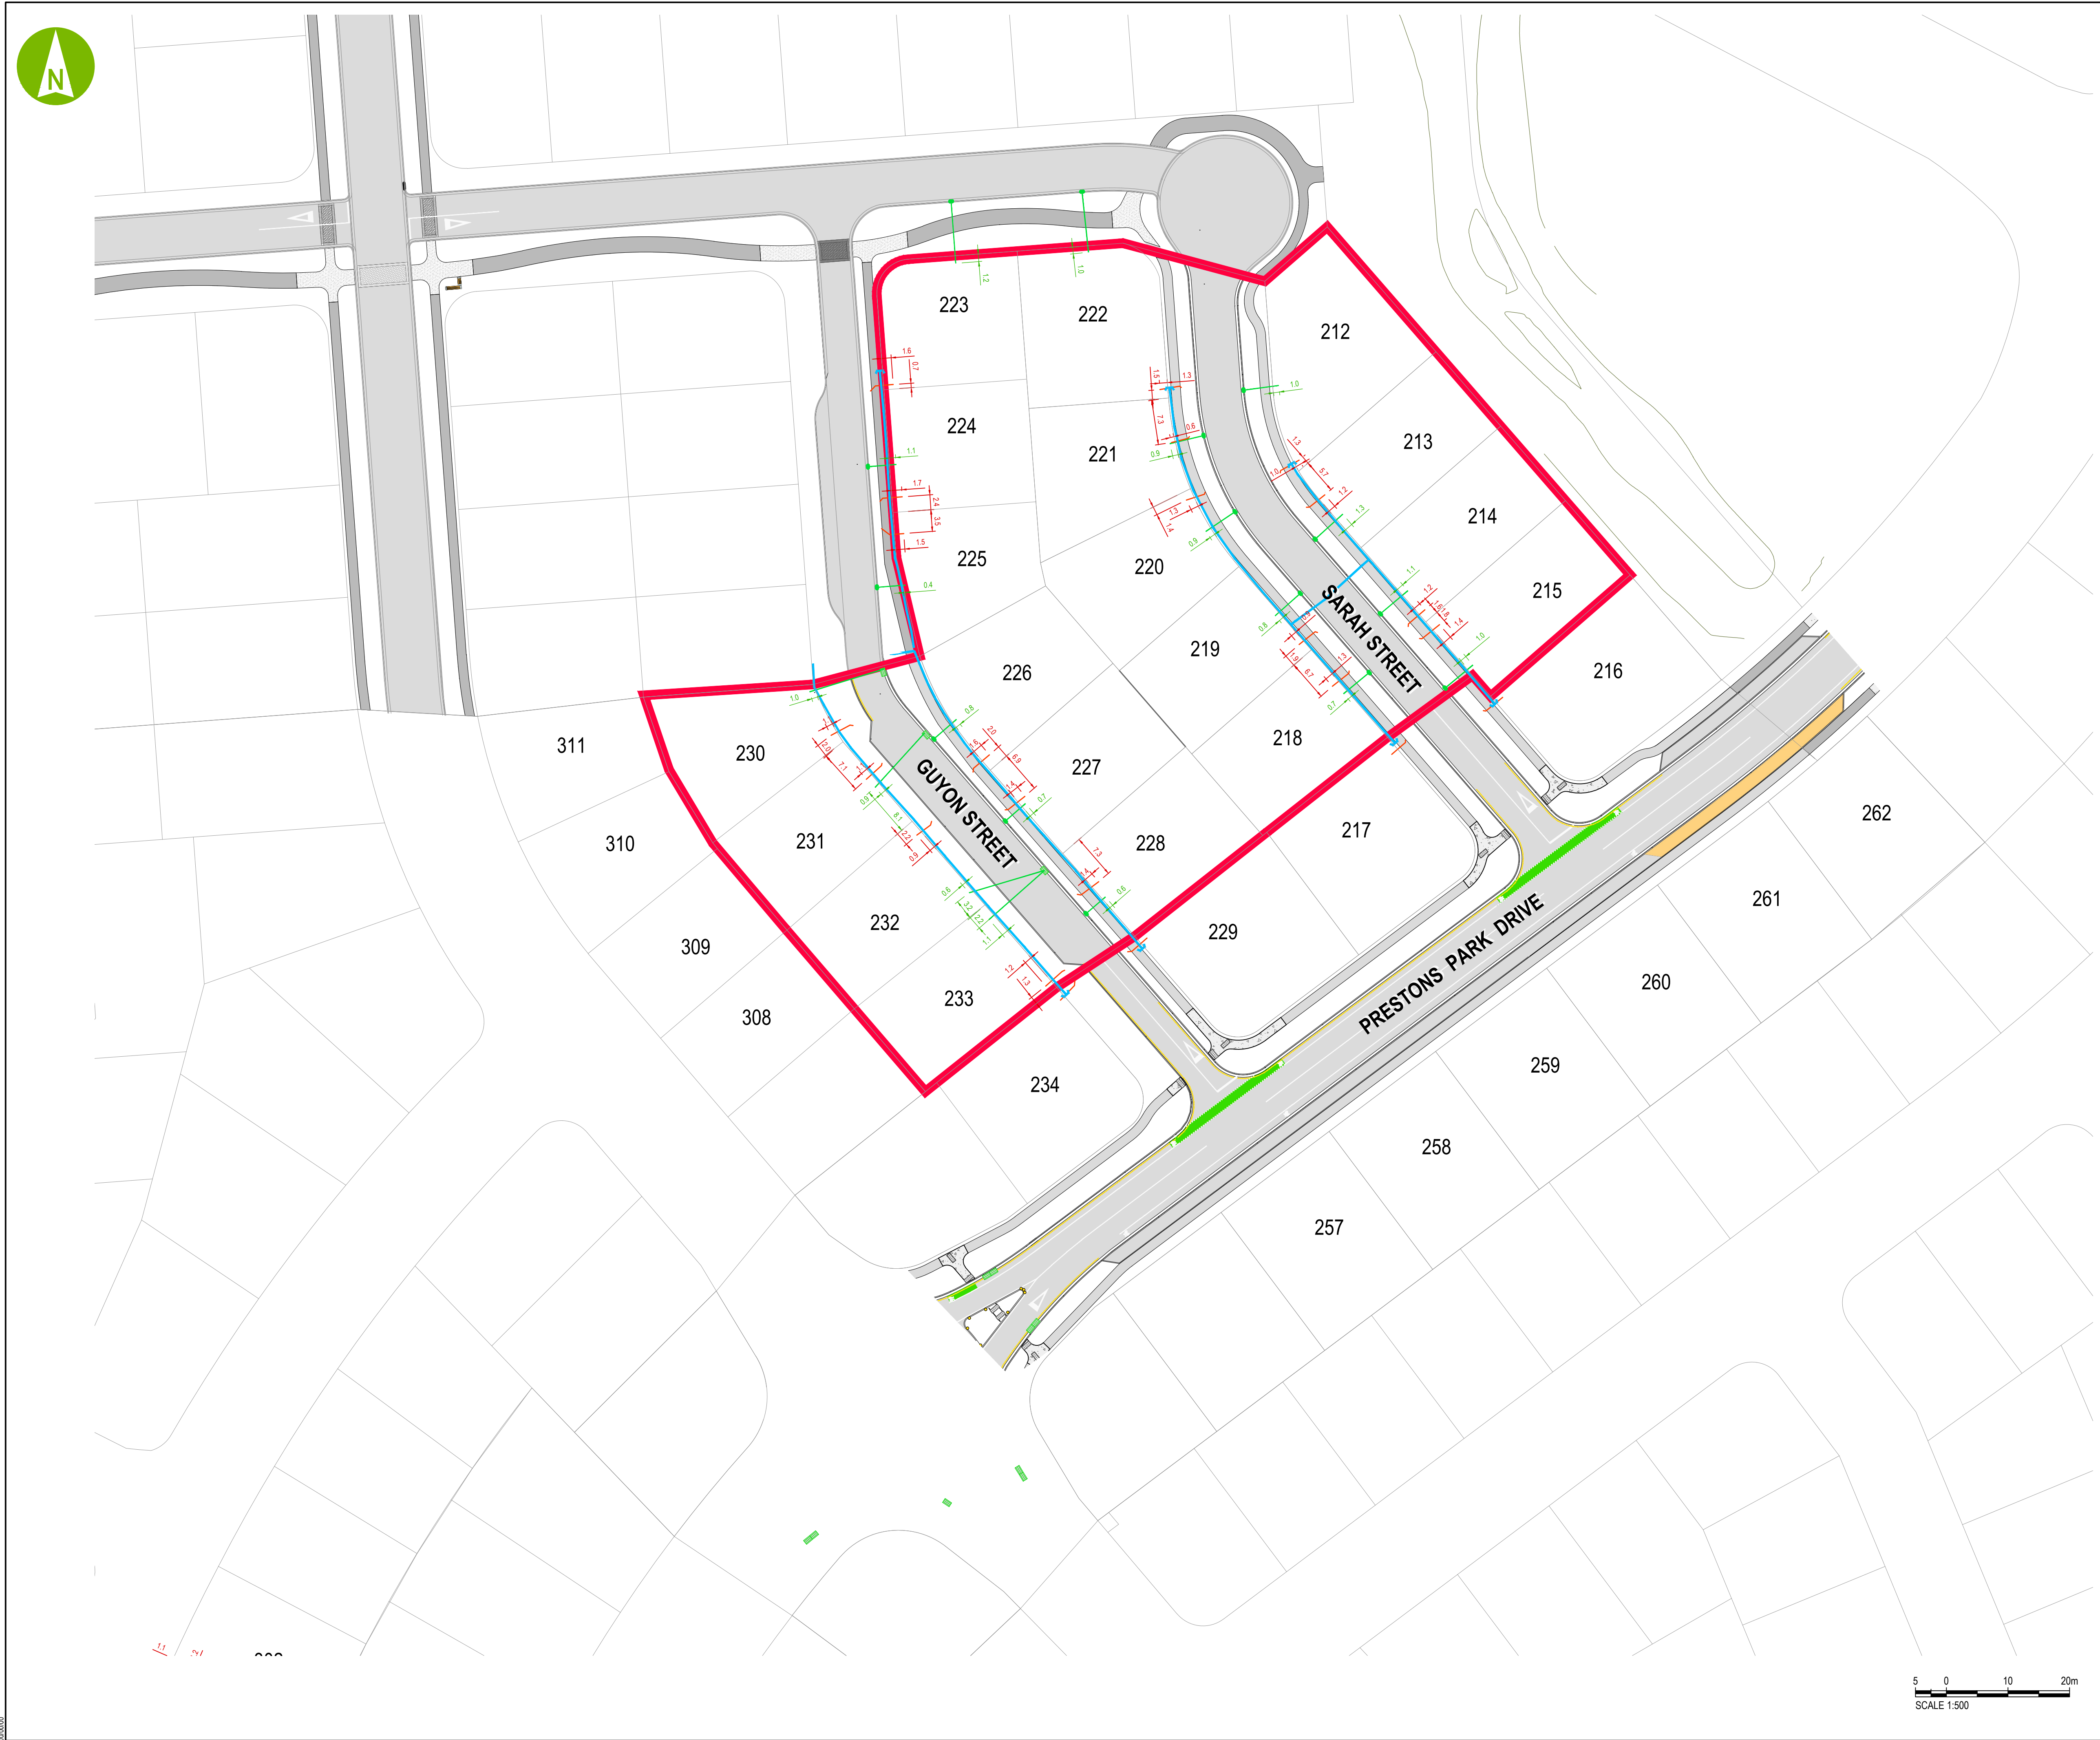

LEGEND

SUB-STAGE R1 BOUNDARY

STORMWATER TO STREET

DOUBLE SUMP

SINGLE SUMP

CORNER SUMP

SEWER LATERAL TO MAINS

WATER SUBMAIN


www.aurecongroup.com

CLIENT


CDL LAND
NEW ZEALAND LIMITED

REV	DATE	REVISION DETAILS	APPROVED
A	18/03/19	ISSUE FOR INFORMATION	K ASHBY

PROJECT

PRESTONS PARK

TITLE

AS-BUILT SEWER AND STORMWATER
SUBSTAGES Q2 & Q3
STAGE 2

DRAWN	DESIGNED	INFORMATION	
R DAWSON	C DOHERTY	PROJECT No.	
CHECKED		235361	
D ROBINSON		SCALE	SIZE
APPROVED		1:500	A1
DATE		DRAWING No.	REV
K ASHBY		AB-PS-S2-SP-09	A



000000