

**LEGEND**

- SUB-STAGE BOUNDARY
- STORMWATER TO STREET
- ▭ DOUBLE SUMP
- ▭ SINGLE SUMP
- ▭ CORNER SUMP
- SEWER LATERAL TO MAINS
- WATER SUBMAIN



CLIENT




REV	DATE	REVISION DETAILS	APPROVED
A		ISSUE FOR INFORMATION	K ASHBY

PROJECT  
**PRESTONS PARK**

TITLE  
**AS-BUILT SEWER AND STORMWATER  
SUBSTAGE Q1  
STAGE 2**

DRAWN	DESIGNED	INFORMATION	
R DAWSON	C DOHERTY	PROJECT No.	
CHECKED		235361	
M CROWE		SCALE	SIZE
APPROVED		1:500	A1
	DATE	DRAWING No.	REV
K ASHBY		AB-PS-S2-SP-10	A

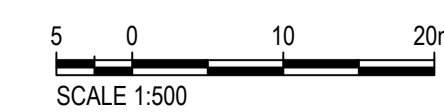

000000