


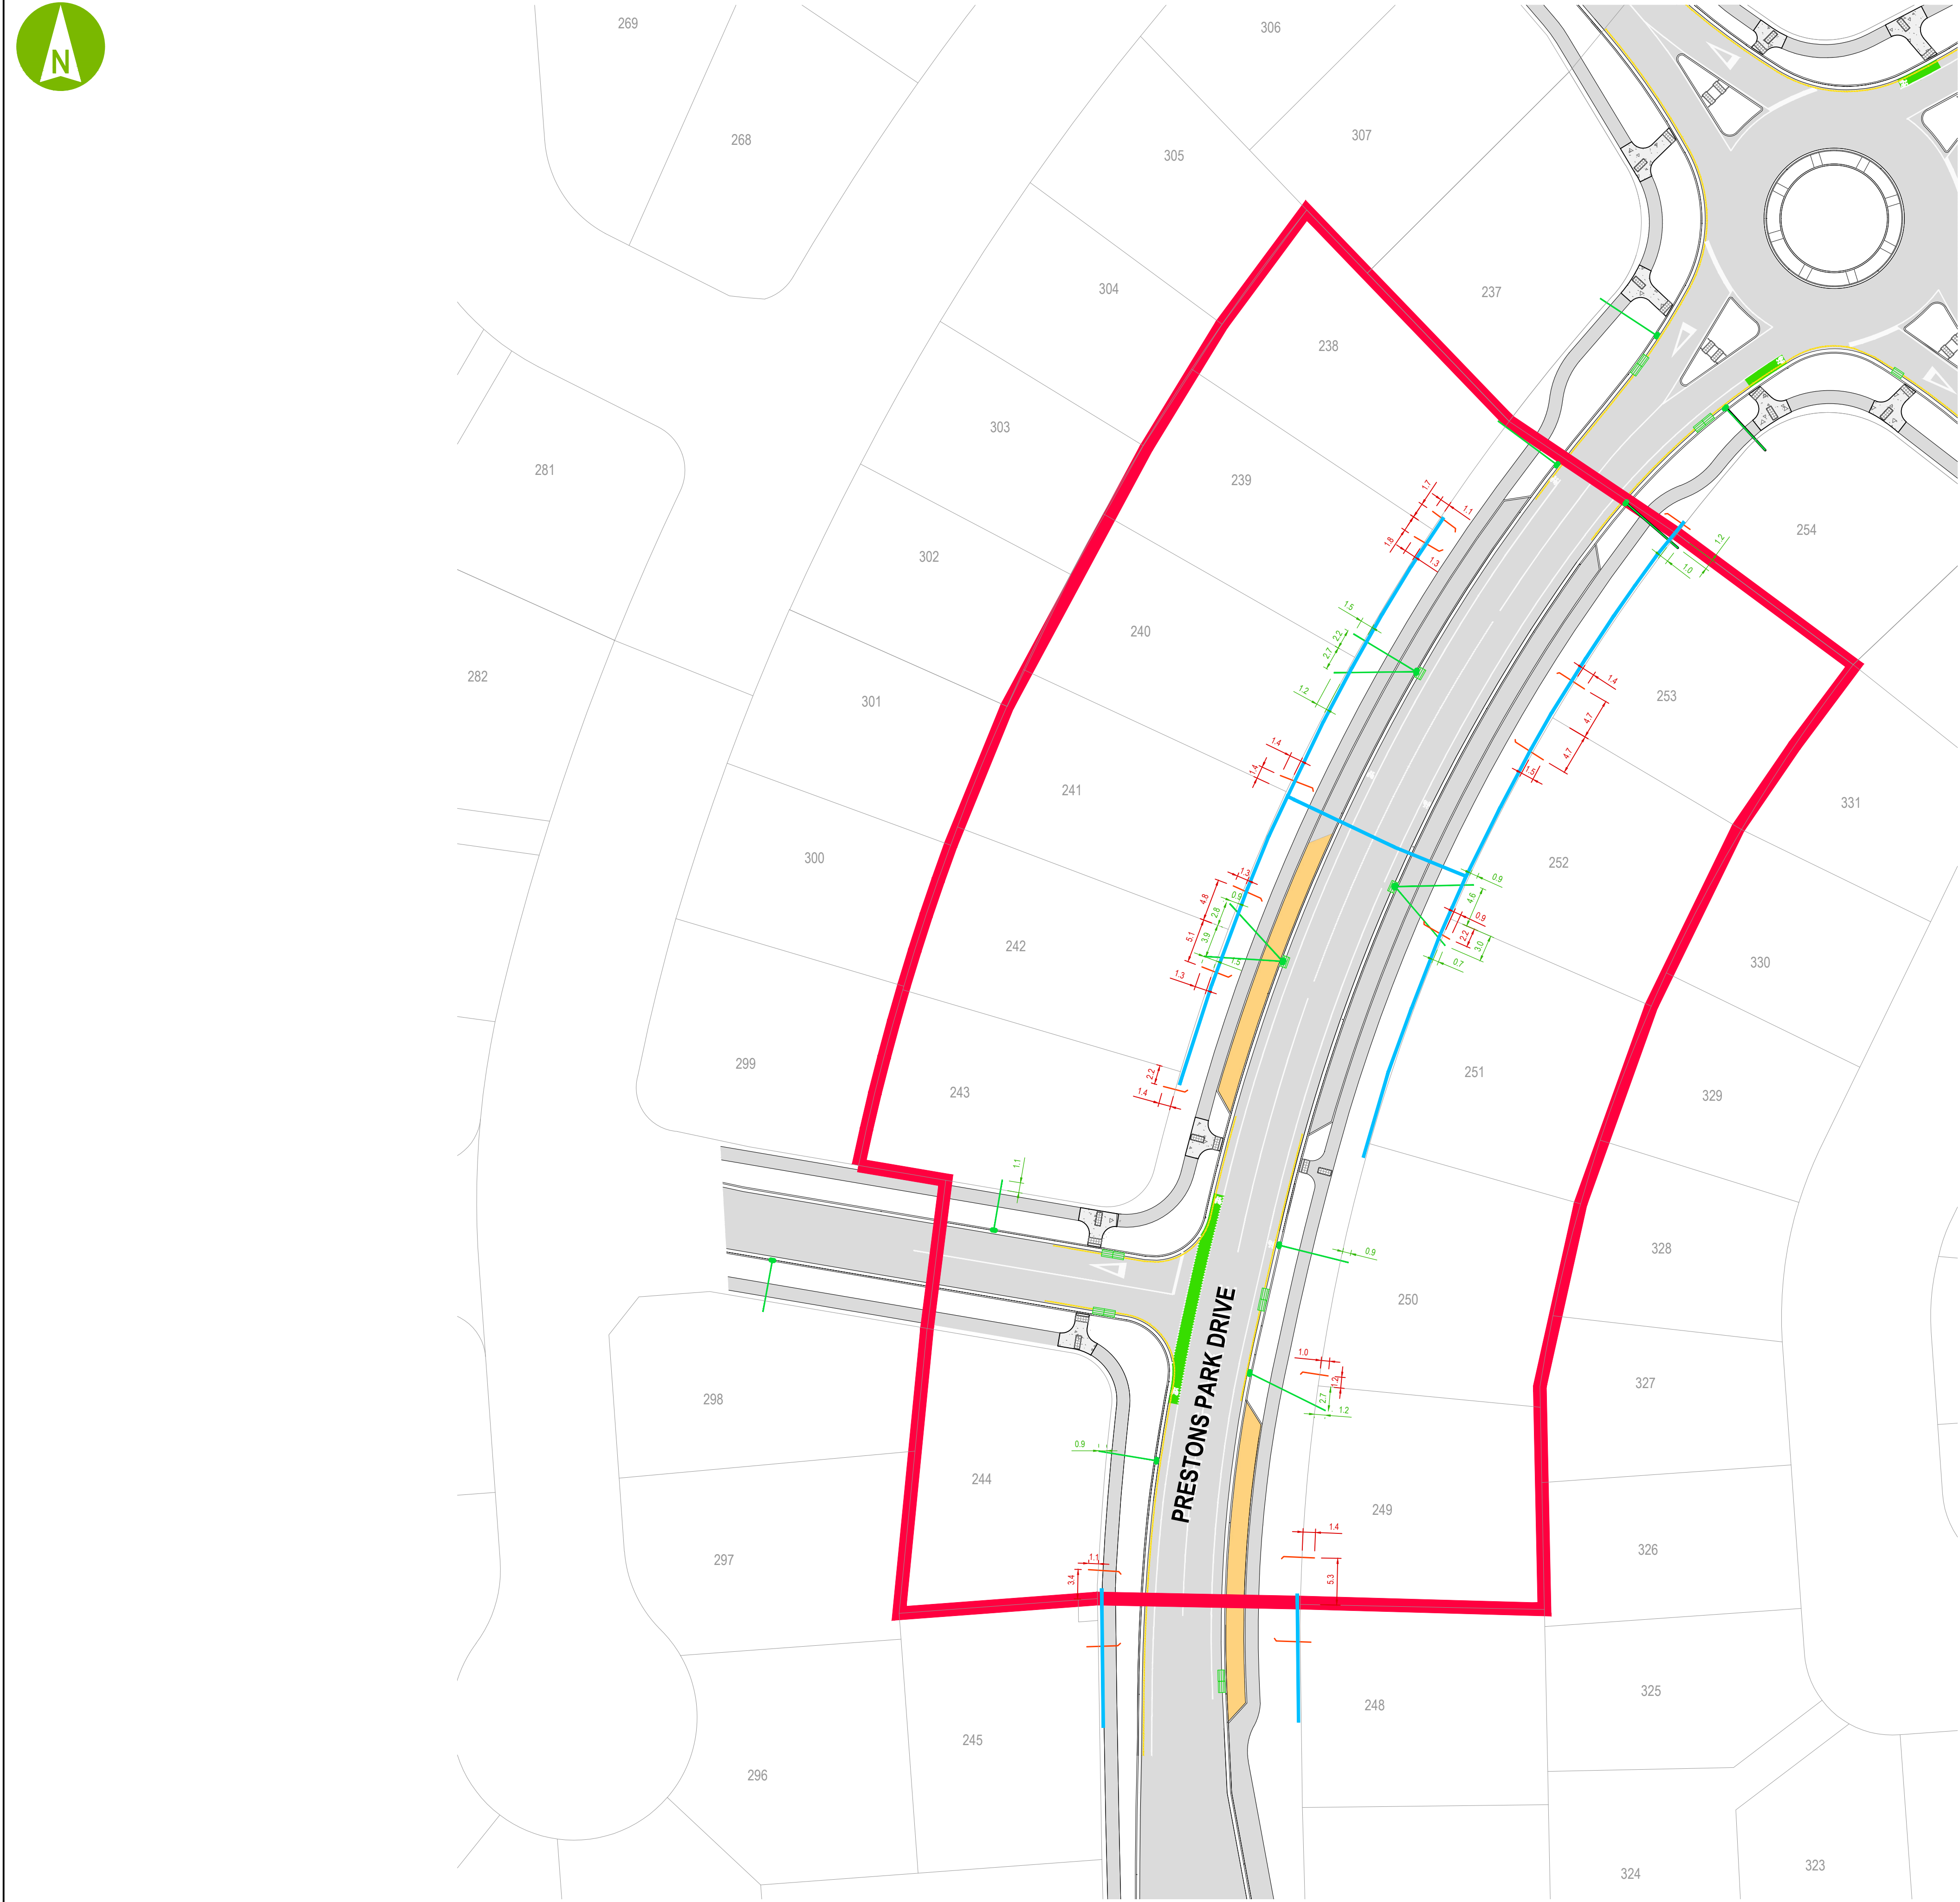

LEGEND

- SUB-STAGE BOUNDARY
- STORMWATER TO STREET
- DOUBLE SUMP
- SINGLE SUMP
- CORNER SUMP
- SEWER LATERAL TO MAINS
- WATER SUBMAIN



CLIENT



REV	DATE	REVISION DETAILS	APPROVED
A		ISSUE FOR INFORMATION	K ASHBY

PROJECT

PRESTONS PARK

TITLE

AS-BUILT SEWER AND STORMWATER
SUBSTAGE Q4
STAGE 2

DRAWN	DESIGNED	INFORMATION	
R DAWSON	C DOHERTY	PROJECT No.	
CHECKED		235361	
D ROBINSON		SCALE	SIZE
APPROVED	DATE	1:400	A1
		DRAWING No.	REV
K ASHBY		AB-PS-S2-SP-12	A