


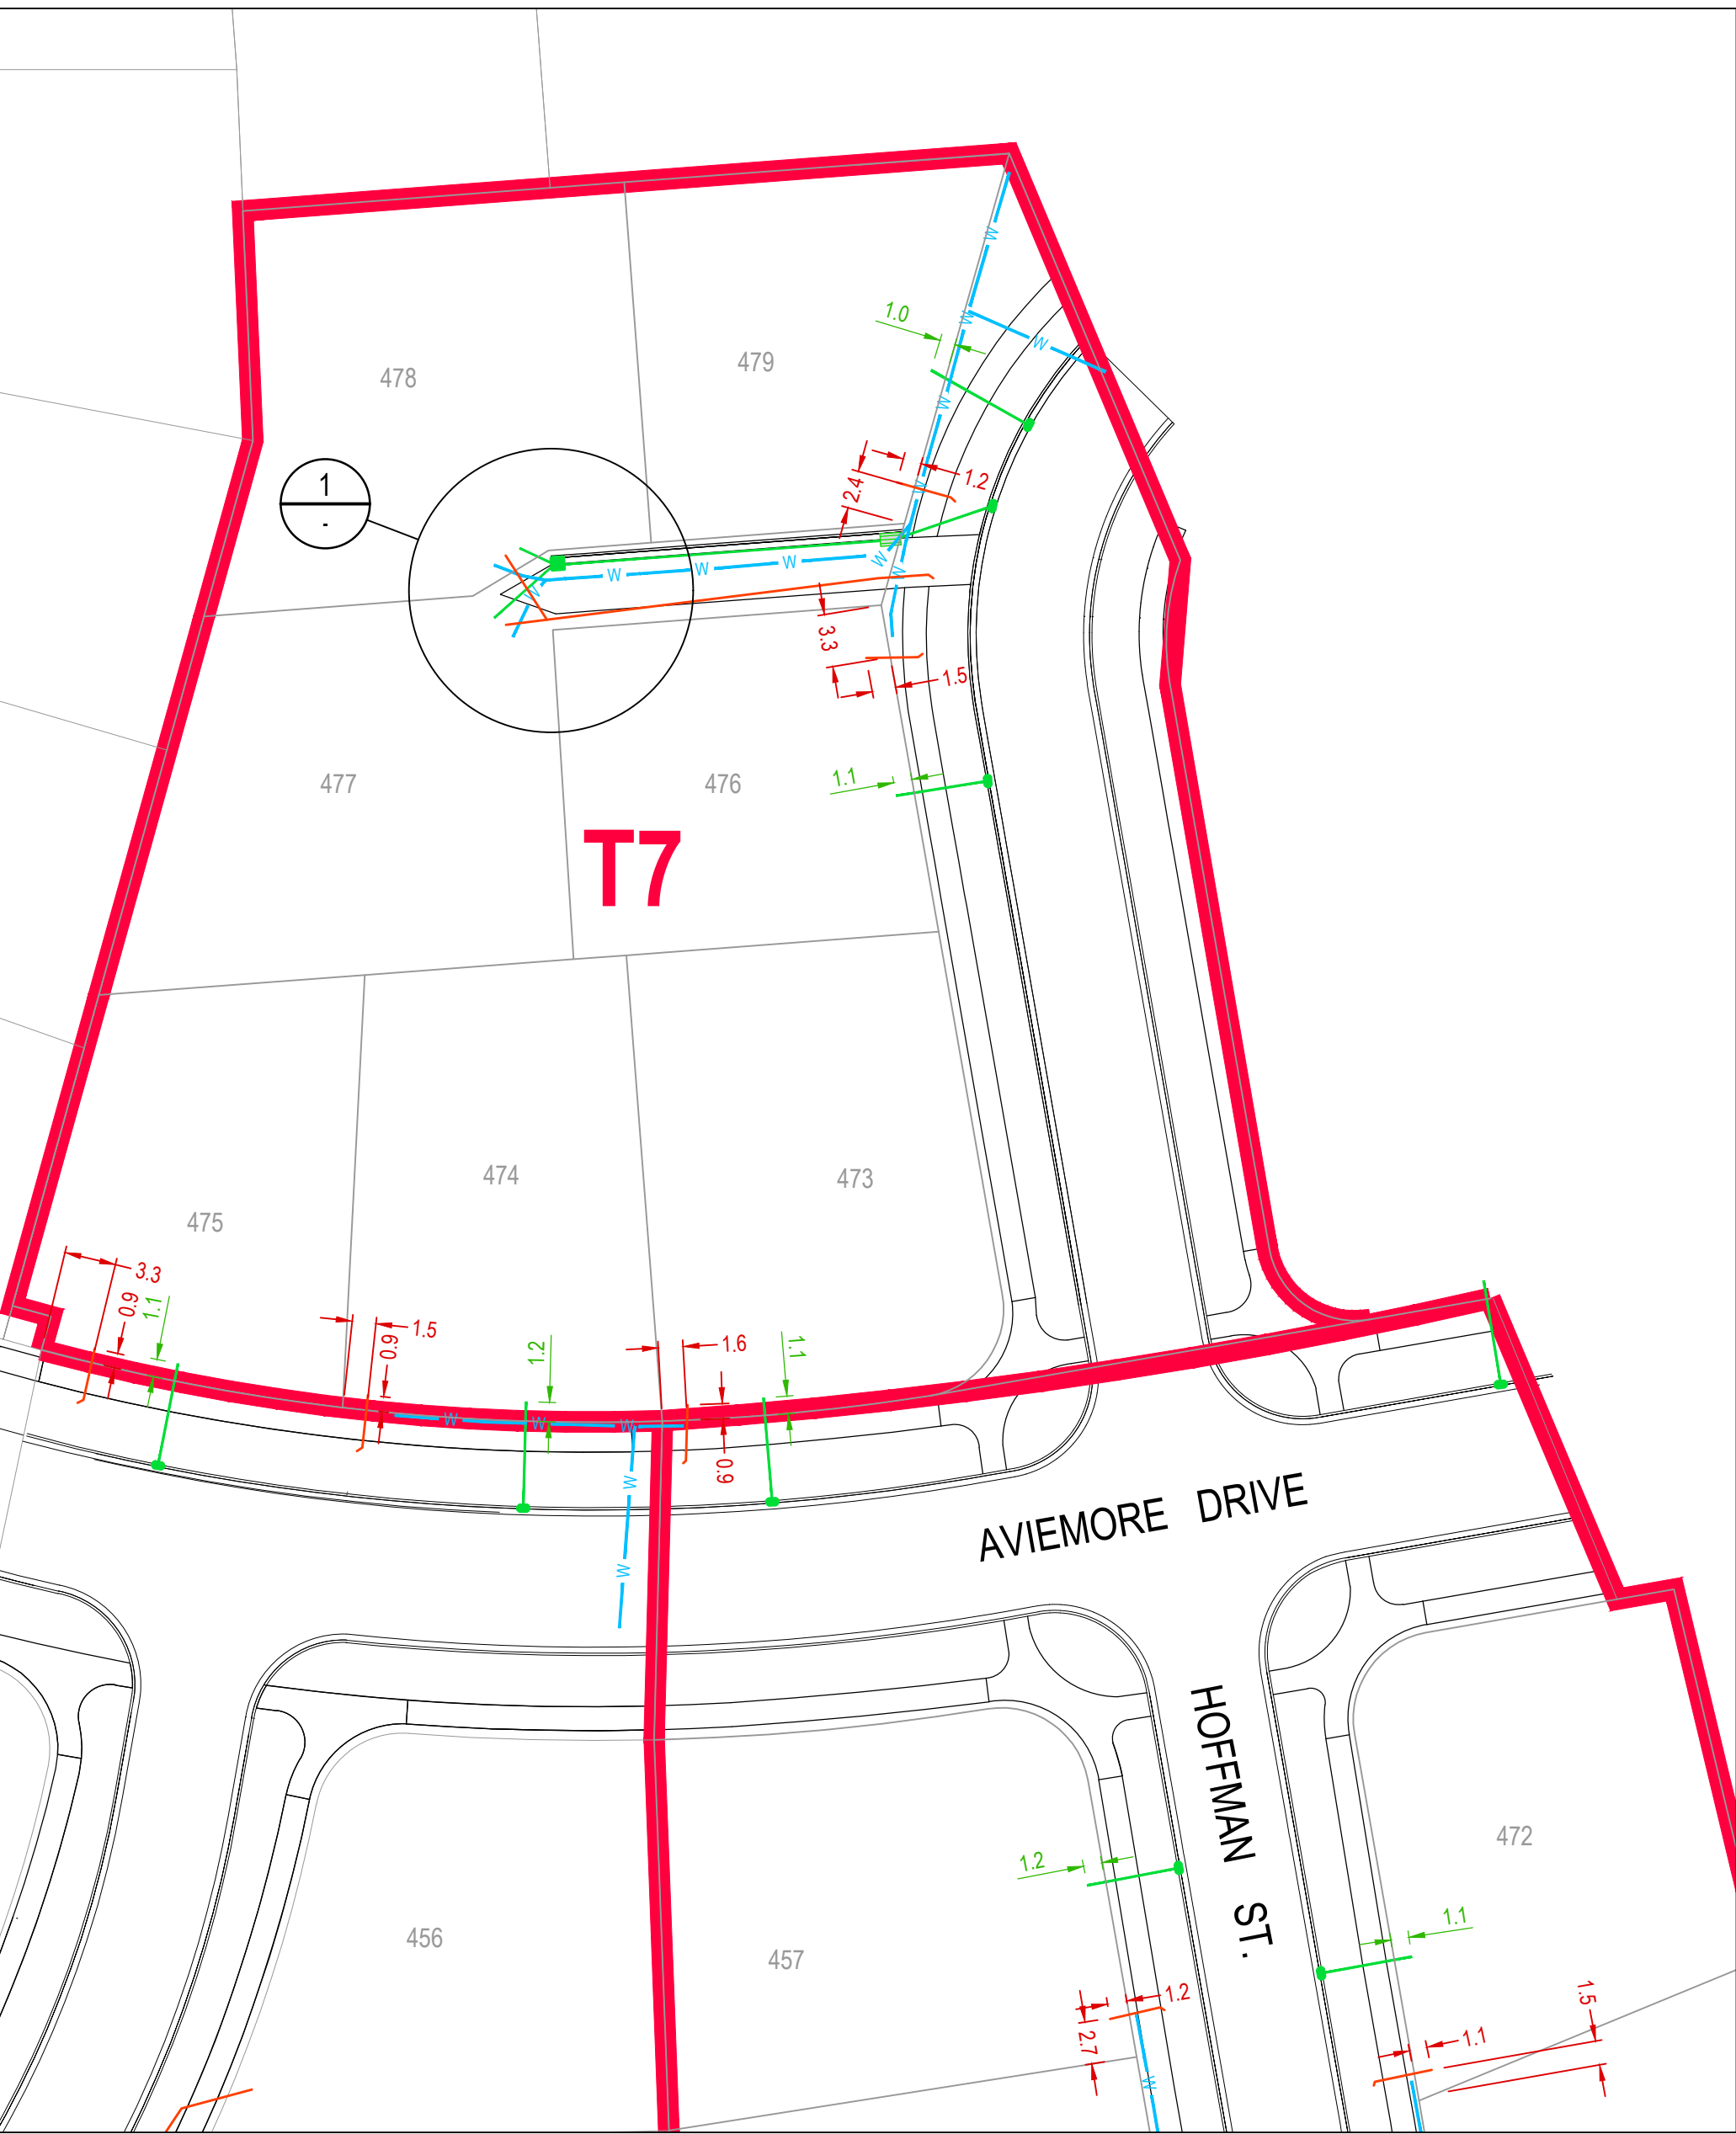


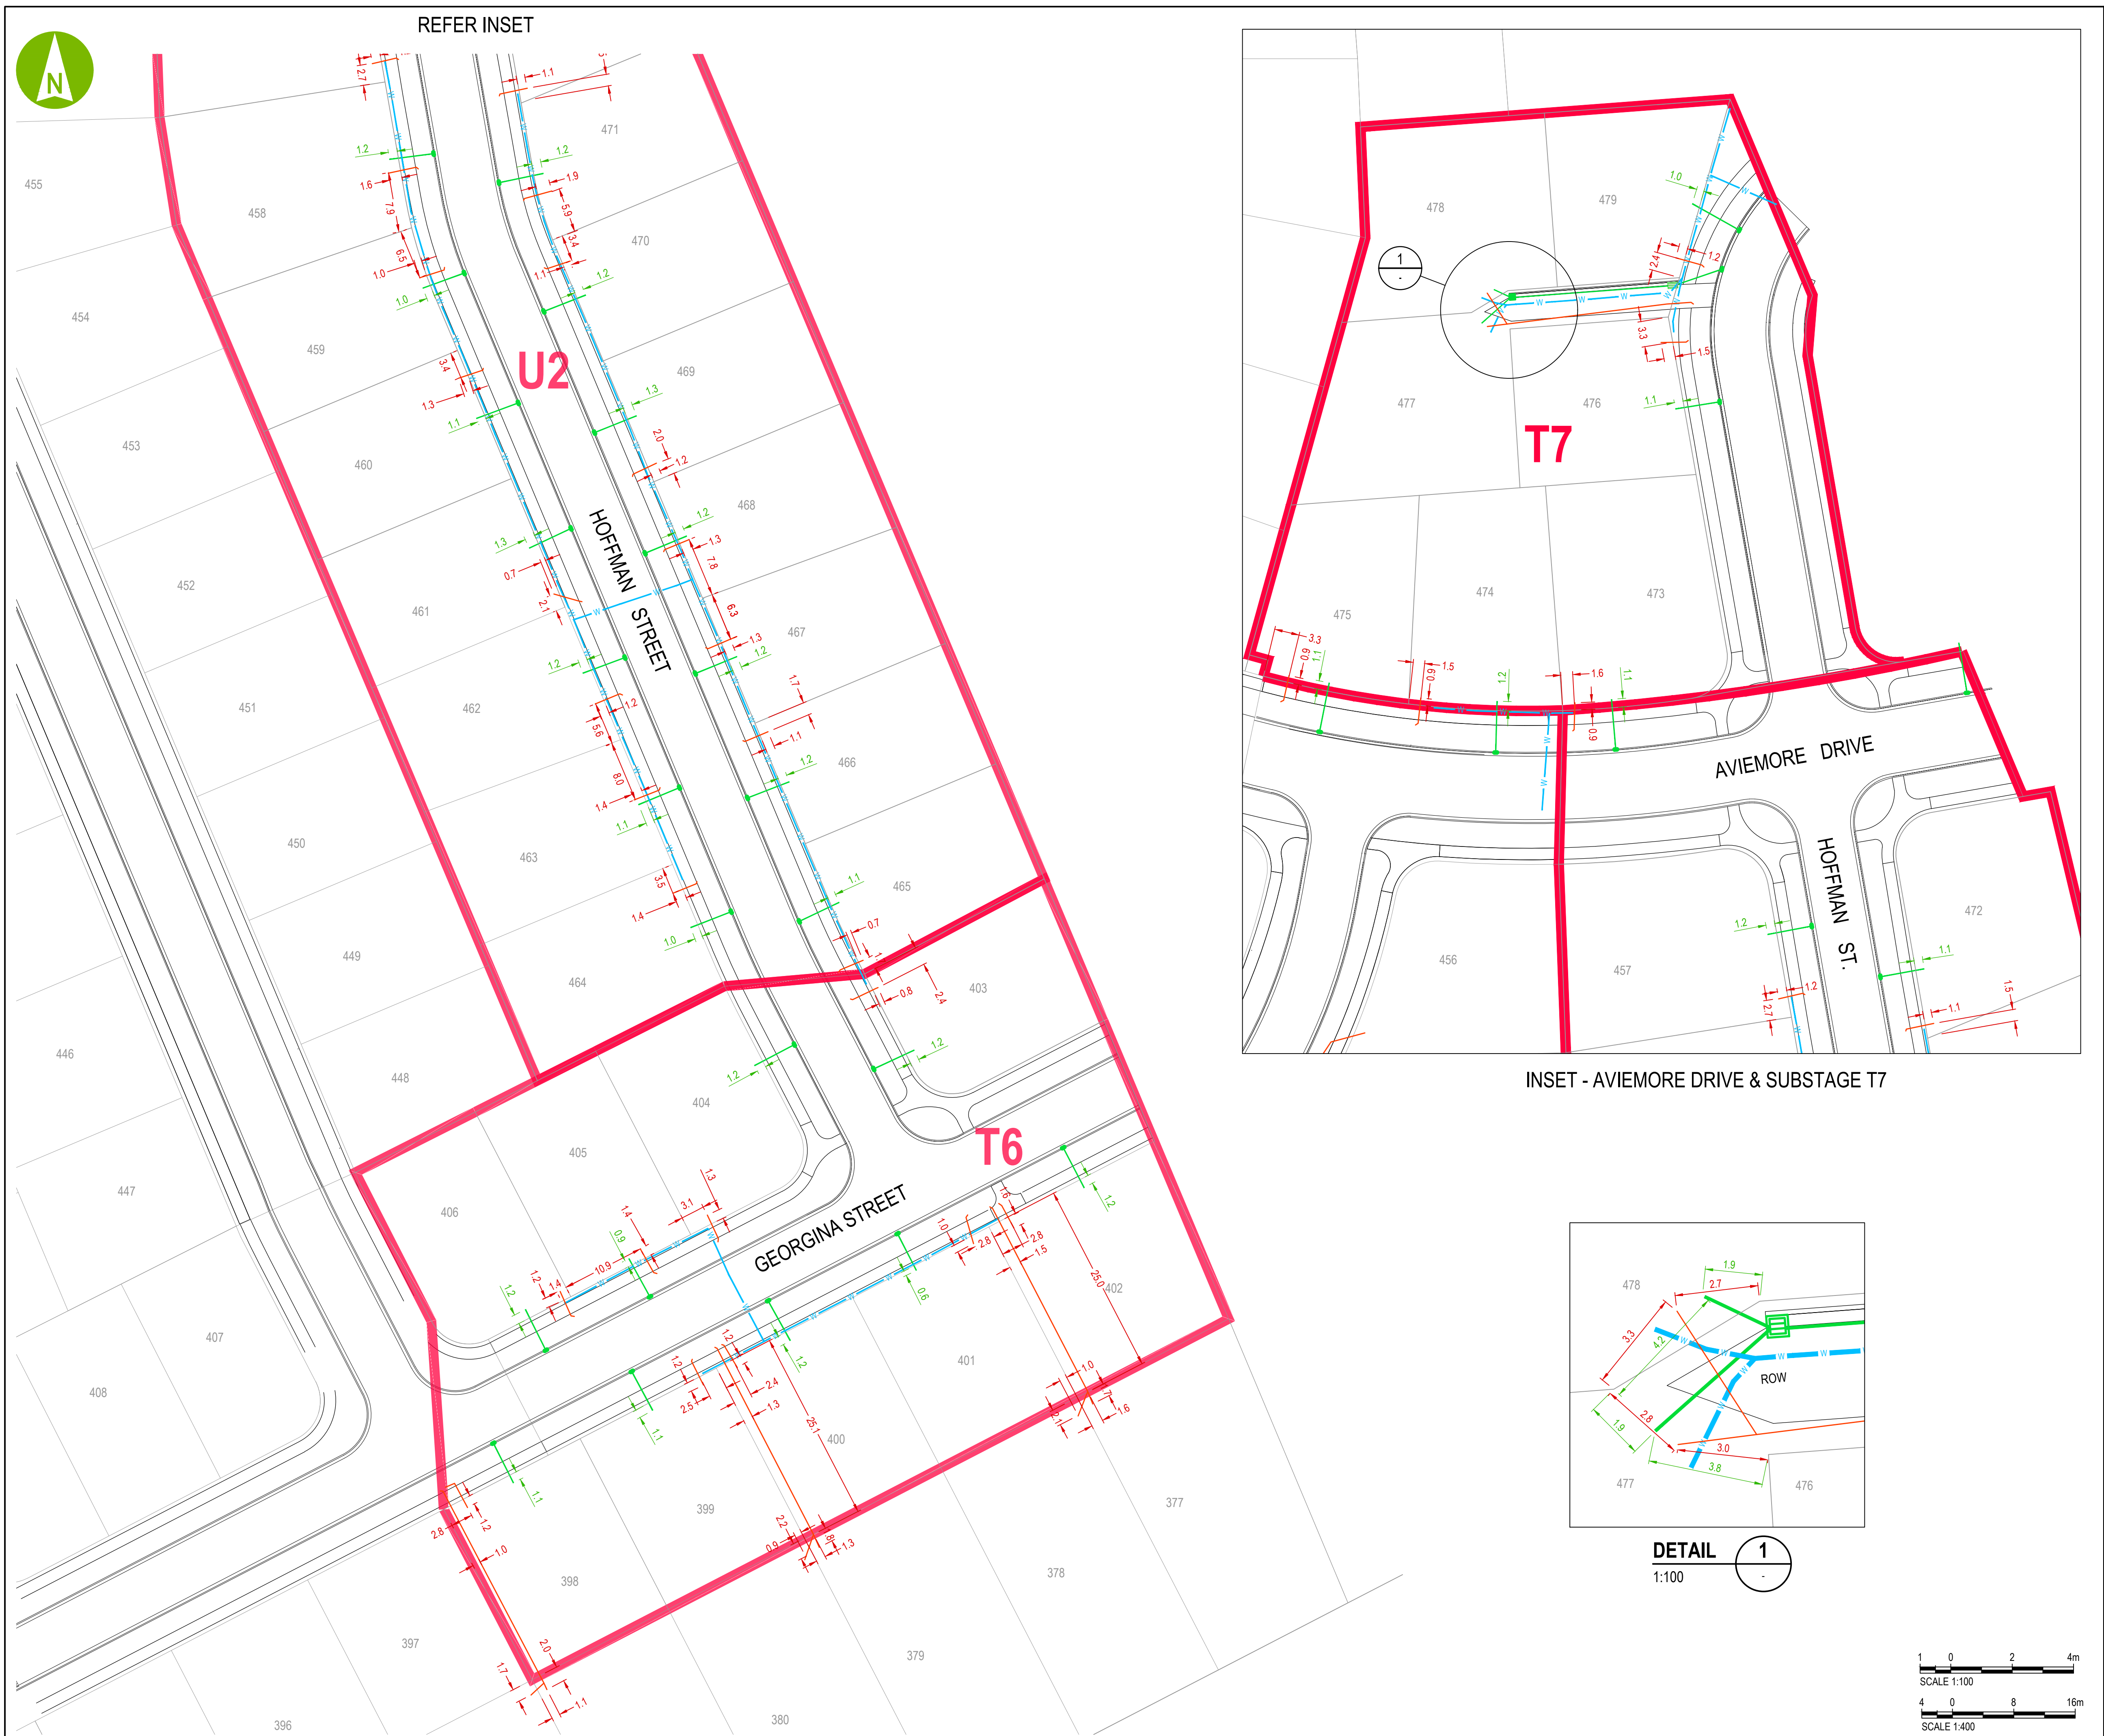

INSET - AVIEMORE DRIVE & SUBSTAGE T7

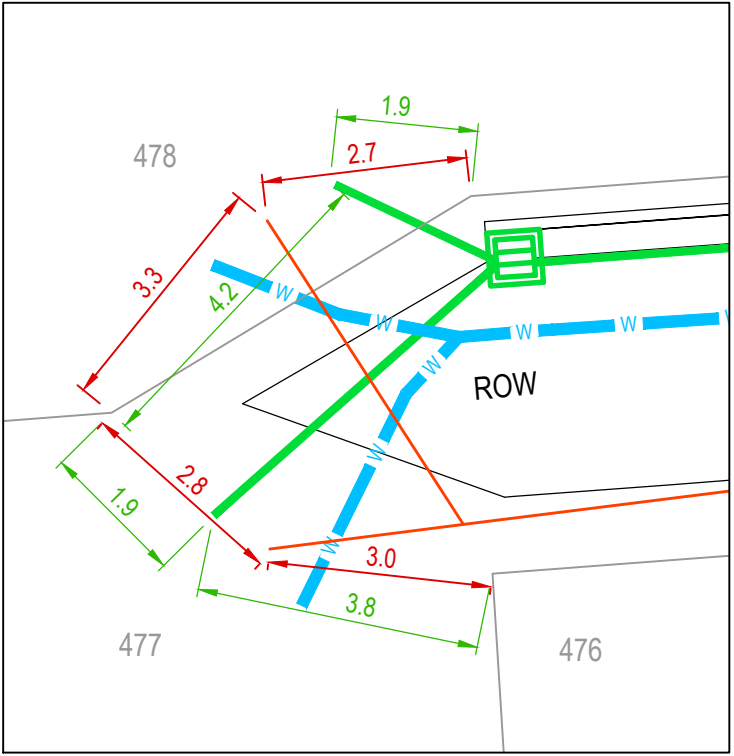

DETAIL 1
1:100

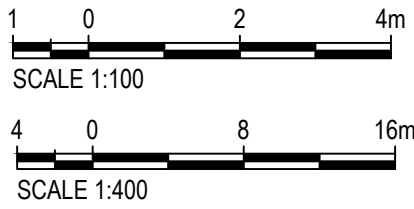

LEGEND

- SUB-STAGE BOUNDARY
- STORMWATER TO STREET
- SEWER LATERAL TO MAINS
- WATER SUBMAIN

aurecon
www.aurecongroup.com

CLIENT

CDL LAND
NEW ZEALAND LIMITED

REV	DATE	REVISION DETAILS	APPROVED
A	24/08/20	ISSUE FOR INFORMATION	K ASHBY

PROJECT

PRESTONS PARK

TITLE
AS-BUILT SEWER AND STORMWATER
SUBSTAGES T6, T7 & U2
STAGE 2

DRAWN	DESIGNED	INFORMATION	
M KORAKO	M CROWE	PROJECT No.	235361
CHECKED	D ROBINSON	SCALE	1:400
APPROVED	K ASHBY	SIZE	A1
DATE	K ASHBY	DRAWING No.	AB-PS-S2-SP-18
		REV	A