


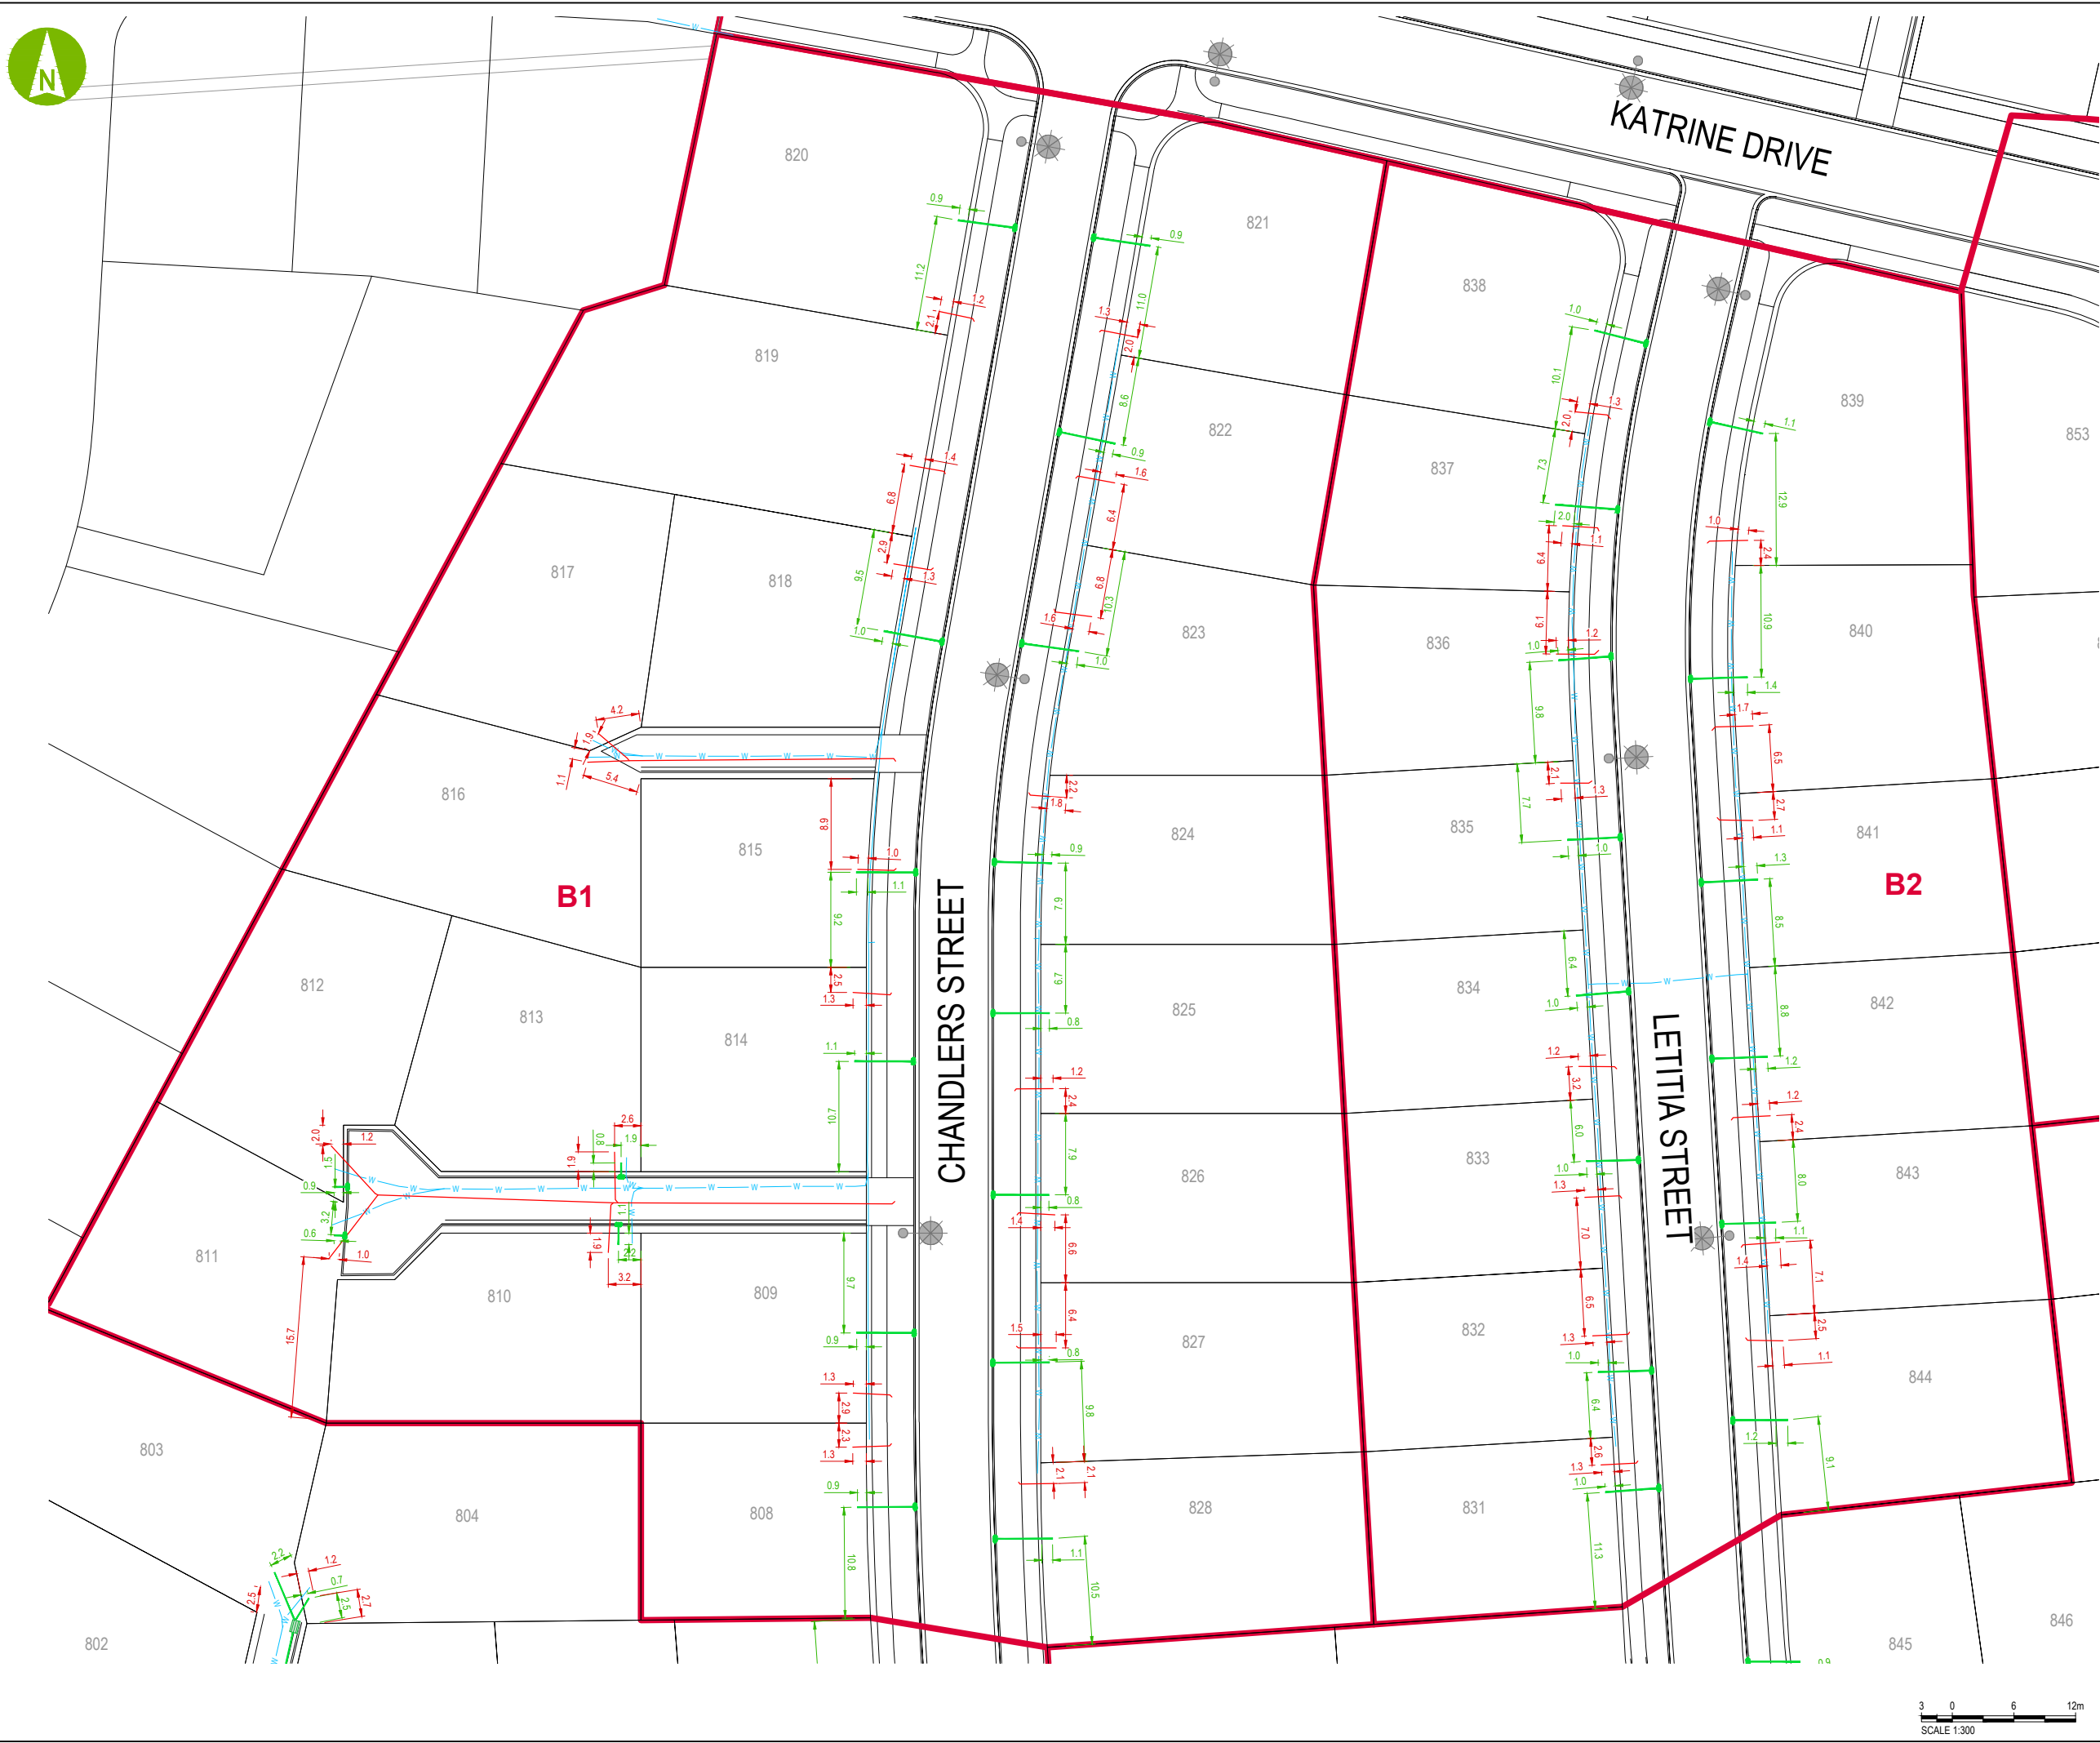

LEGEND

- SUB-STAGE BOUNDARY
- STORMWATER TO STREET
- SEWER LATERAL TO MAINS
- WATER SUBMAIN
- KIOSK

aurecon
www.aurecongroup.com

CLIENT



CDL LAND
NEW ZEALAND LIMITED

REV	DATE	REVISION DETAILS	APPROVED
A	05/03/21	ISSUE FOR AS-BUILT INFORMATION	K ASHBY

PROJECT

PRESTONS PARK

TITLE

AS-BUILT SEWER & STORMWATER
SUBSTAGE B1 & B2
STAGE 4

DRAWN	DESIGNED	INFORMATION	
T STOCKER	M CROWE	PROJECT No.	
CHECKED		SCALE	SIZE
D ROBINSON		1:300	A1
APPROVED		DRAWING No.	REV
K ASHBY		AB-PS-S4-SP-01	A
K ASHBY			

