


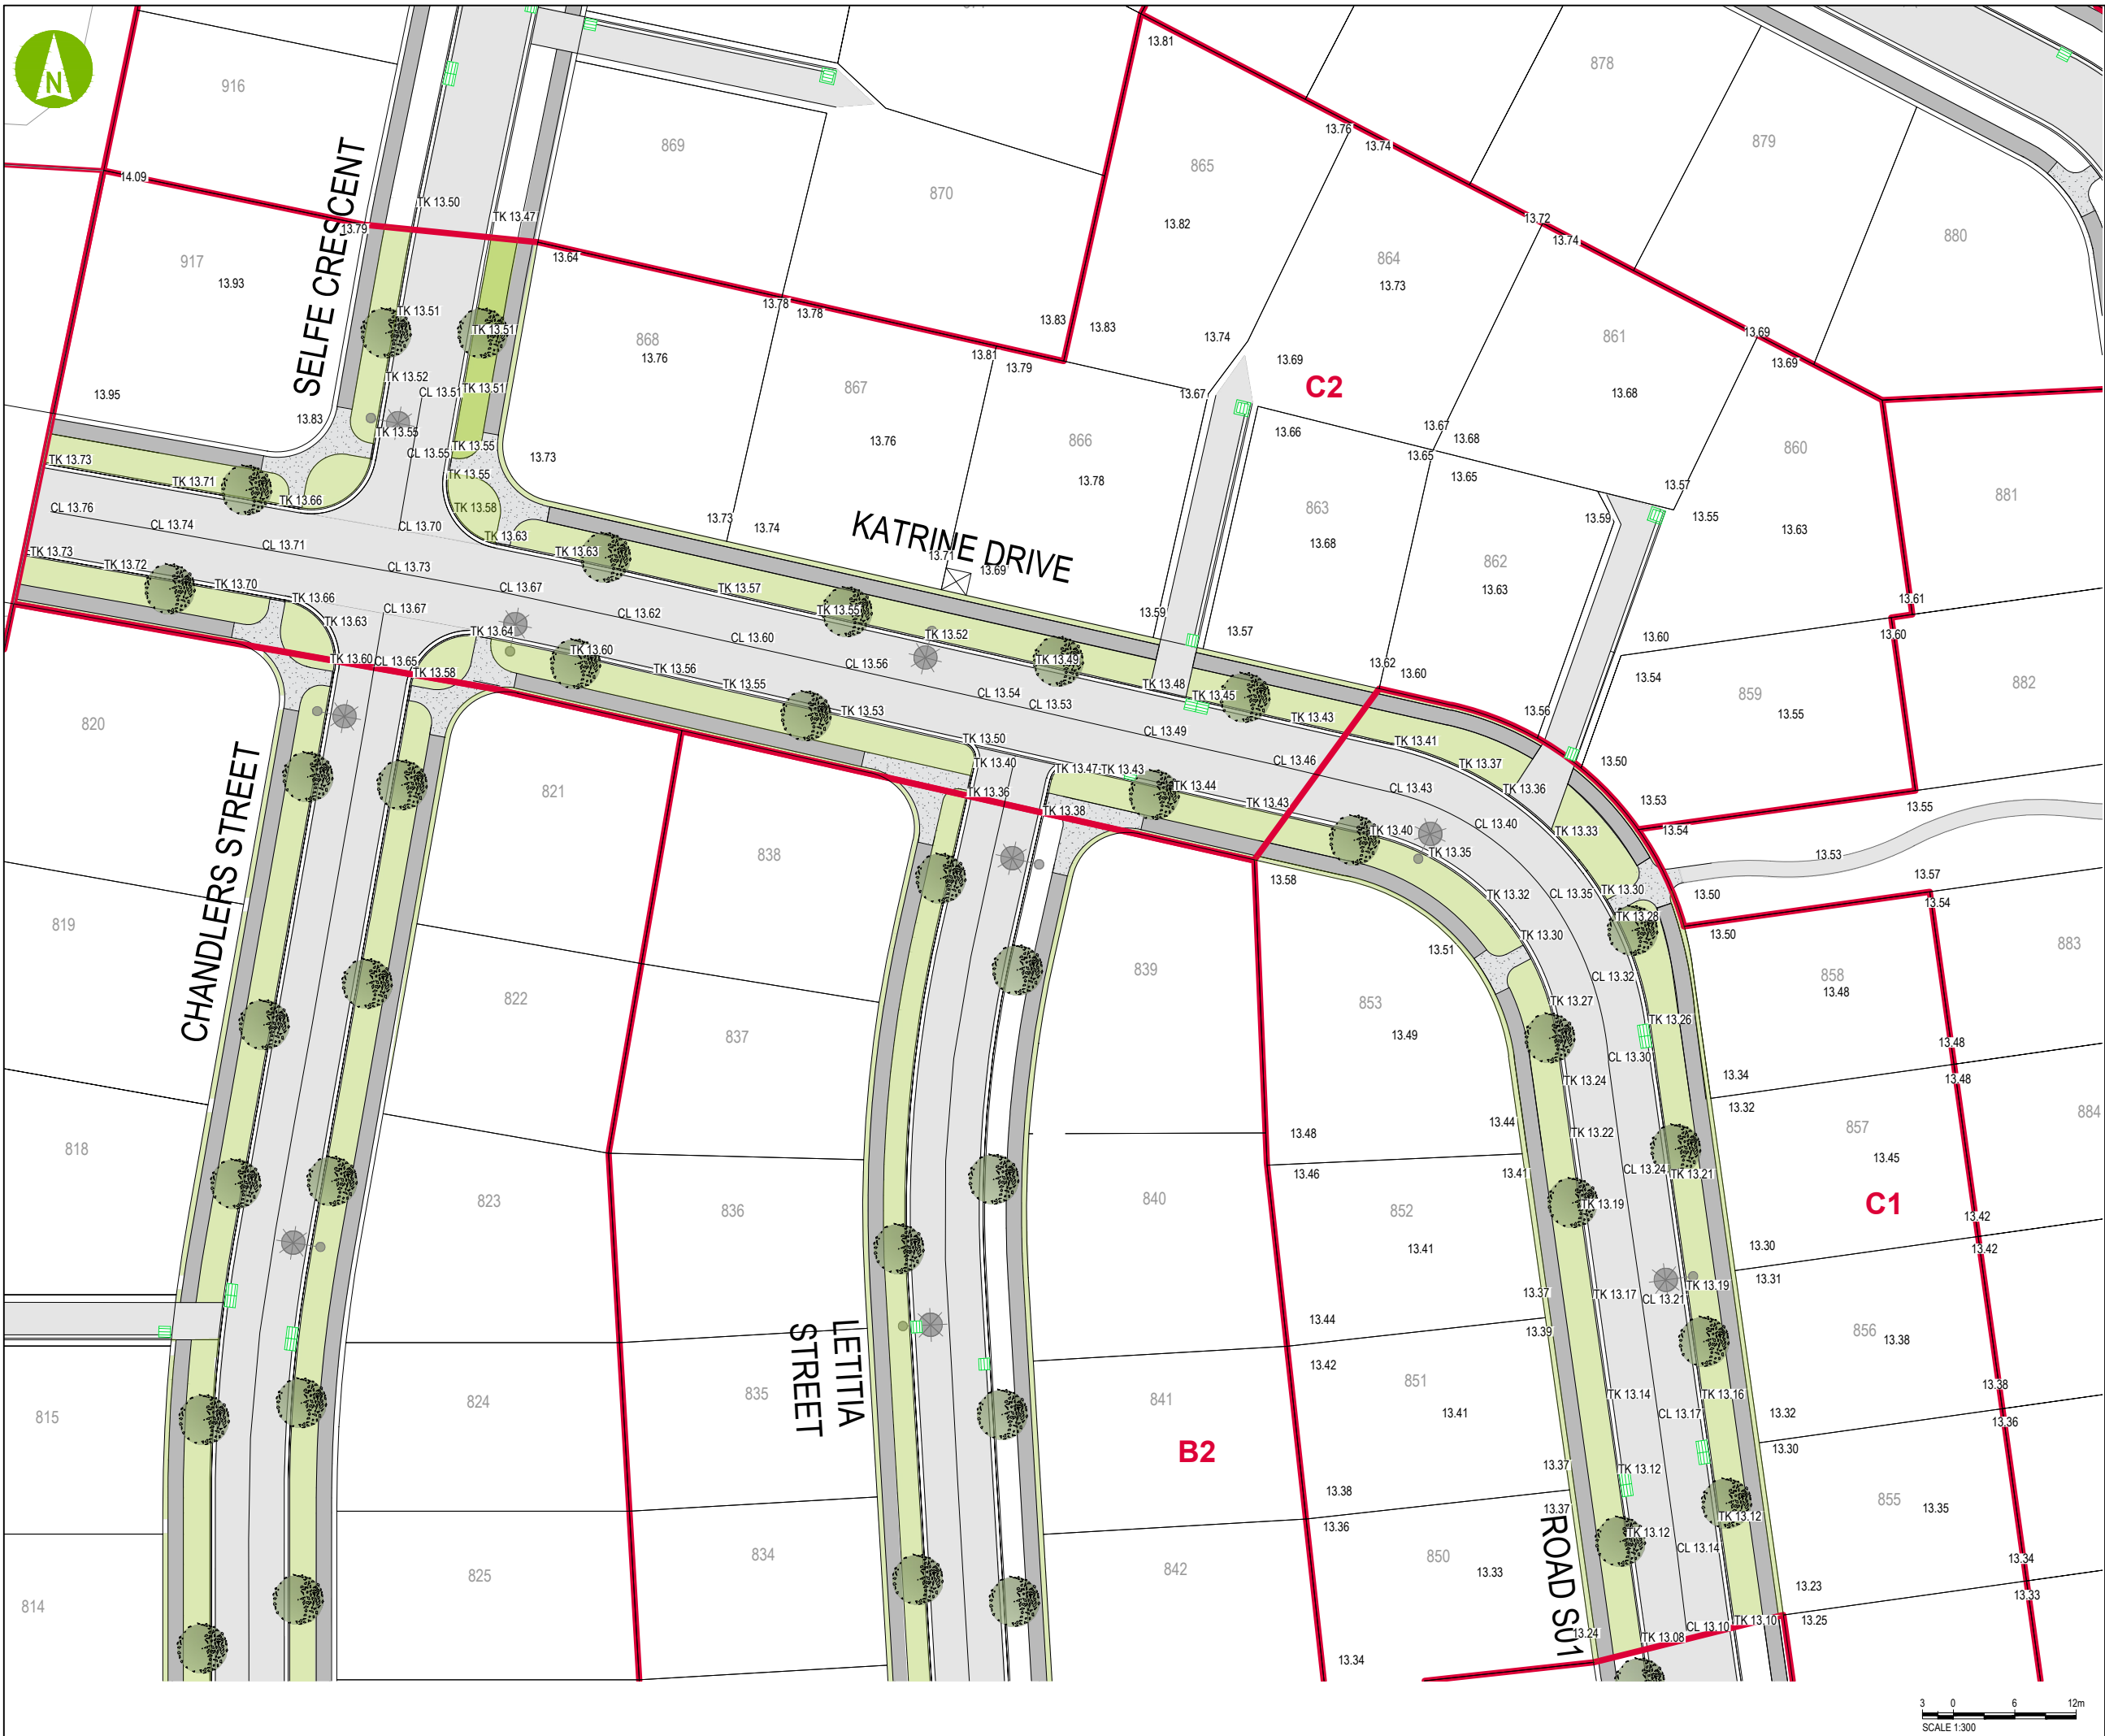

LEGEND

- SUB-STAGE BOUNDARY
- PROPOSED TREE
- PROPOSED STREET LIGHT
- DOUBLE SUMP
- SINGLE SUMP
- CORNER SUMP
- ROAD (Red line)
- ROAD (Green line)
- APPROVED ROAD NAME
- PROPOSED ROAD NAME
- KIOSK

NOTES:

- KERB LEVELS ARE AT TOP OF KERB.
- PROPOSED TREES & LANDSCAPING ARE INDICATIVE ONLY

SURVEY ORIGIN DATA

- THE PROPERTY DATA HAS BEEN SOURCED FROM AURECON (MAY 2019) AND IS SUBJECT TO FINAL LEGAL REVIEW BY LAND INFORMATION NEW ZEALAND (LINZ).
- VERTICAL ELEVATIONS ARE IN TERMS OF CHRISTCHURCH DRAINAGE DATUM, SCIRT PUBLISHED JUNE 2011.
- THE ORIGIN OF LEVELS IS BM 3257 (EHDK), RL 15.160m

www.aurecongroup.com

CLIENT

CDL LAND
NEW ZEALAND LIMITED

REV	DATE	REVISION DETAILS	APPROVED
A	21/05/21	ISSUE FOR INFORMATION	KASHBY

PROJECT

PRESTONS PARK

TITLE

SITE LEVELS PLAN
SUBSTAGE C1 & C2
STAGE 4

DRAWN	DESIGNED	INFORMATION	
C DOHERTY	C DOHERTY	PROJECT No.	
CHECKED		235361	
M CROWE		SCALE	SIZE
APPROVED		1:300	A1
K ASHBY	DATE	DRAWING No.	REV
K ASHBY		AB-PS-S4-IN-04	A