
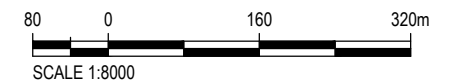
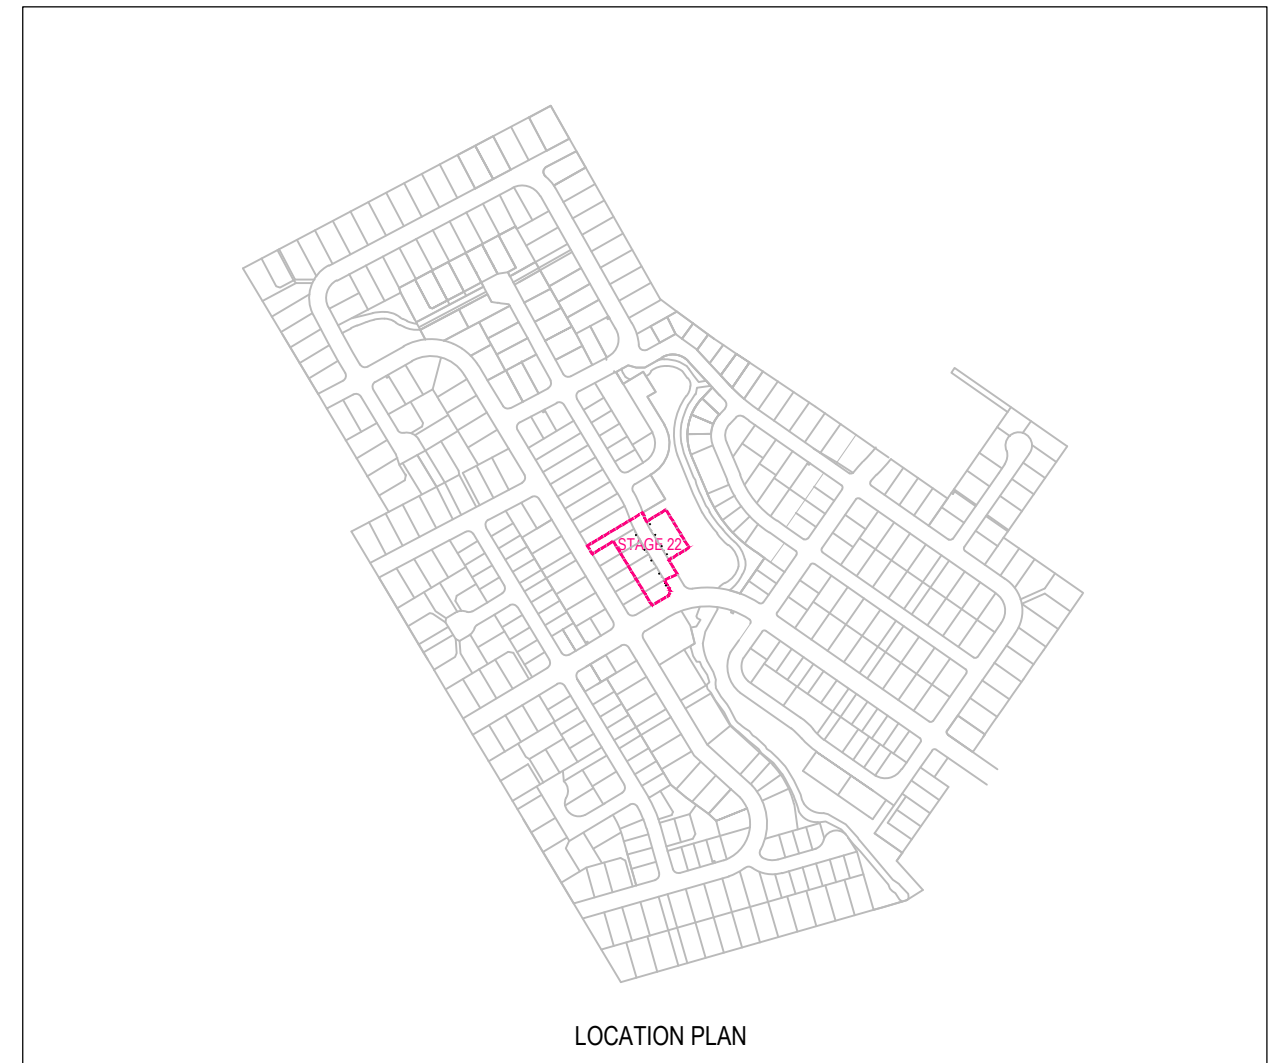


NOTES:

AS BUILT INFORMATION HAS BEEN SUPPLIED BY KBs
 CONTRACTING & QUARRIES LTD - FEBRUARY 2014.
 HEIGHTS ARE IN TERMS OF MEAN SEA LEVEL
 ALL LATERALS ARE 20mmØ ID POLY

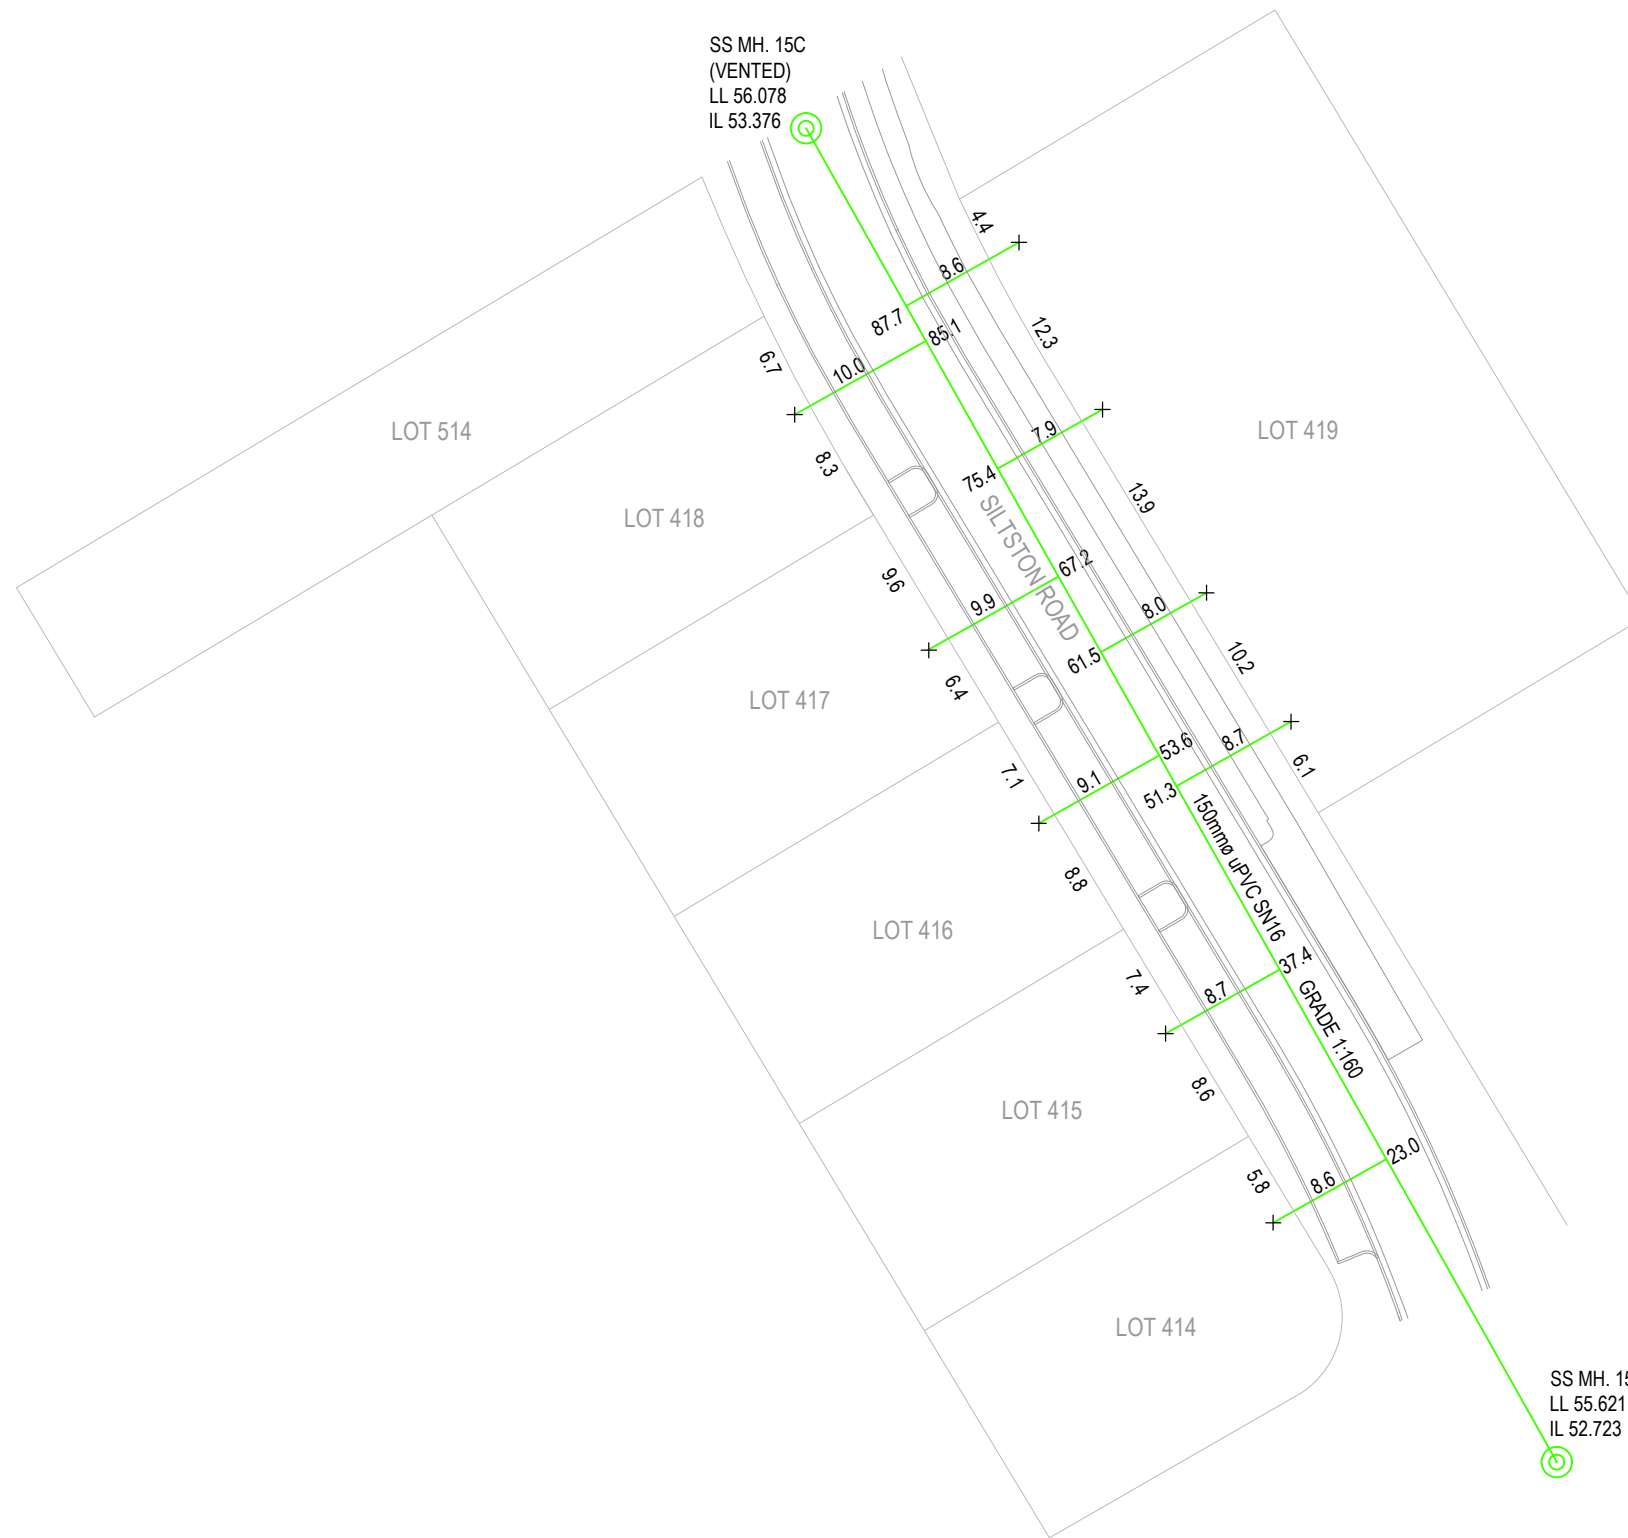

00/00000

CLIENT		REV	DATE	REVISION DETAILS	APPROVED	DRAWN A.GRAY	DESIGNED M.CROWE	PROJECT STONEBROOK ROLLESTON		AS BUILT PROJECT No. 224926	
						CHECKED D.WATSON		TITLE STAGE 22 SEWER AS BUILT		SCALE AS SHOWN	SIZE A3
						APPROVED				DRAWING No.	REV
						DATE				DW-LD-S2-AB-SS-01	A
		A	07.04.14	AS BUILTS ISSUED		B.TOMS					