
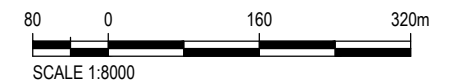
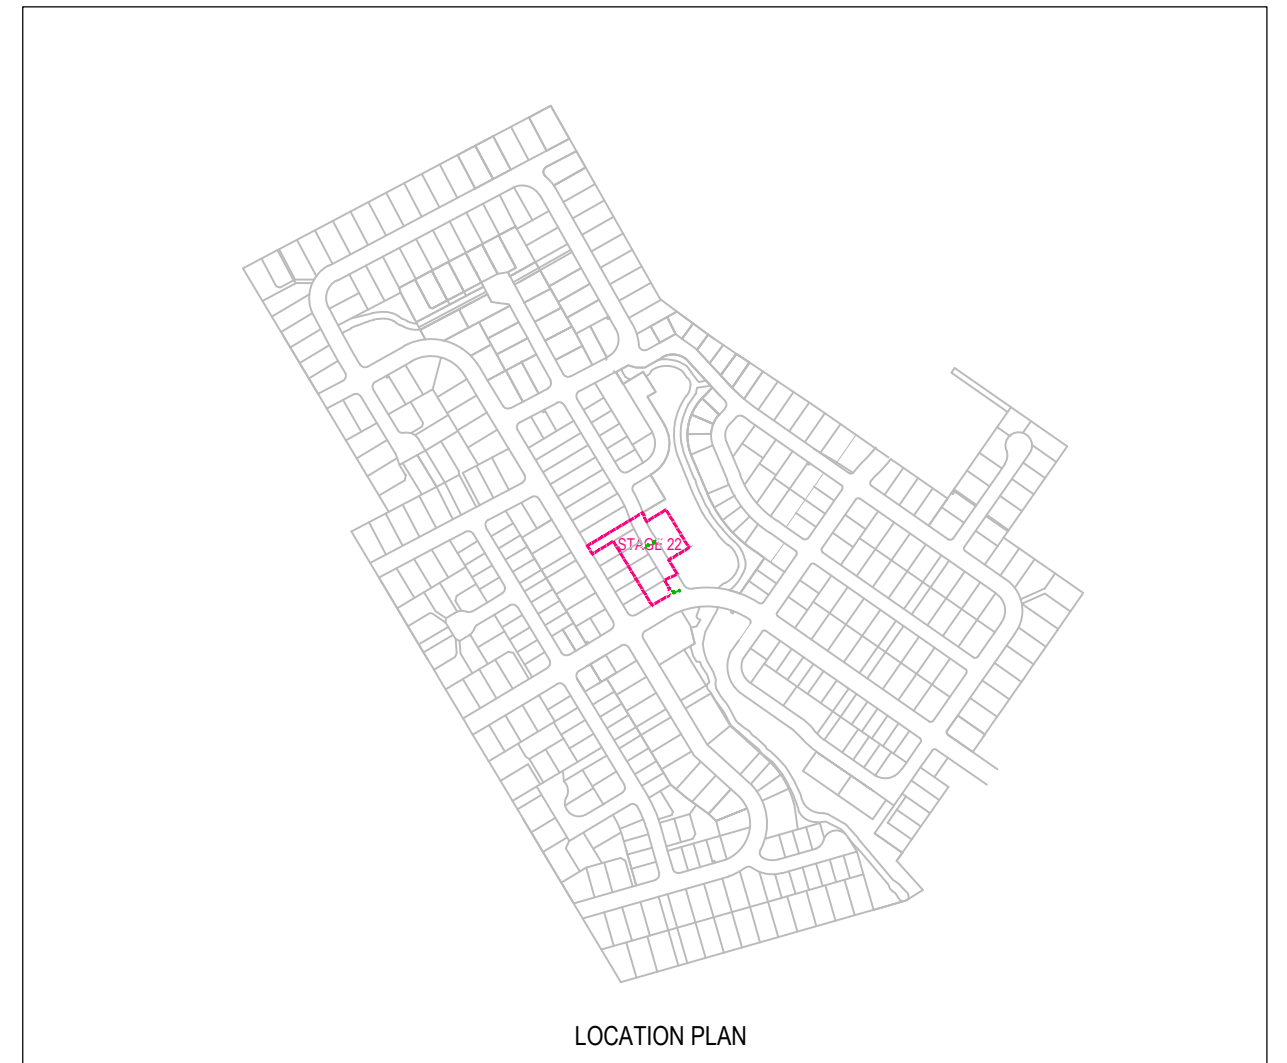


NOTES:

AS BUILT INFORMATION HAS BEEN SUPPLIED BY KBs  
 CONTRACTING & QUARRIES LTD - FEBRUARY 2014.  
 HEIGHTS ARE IN TERMS OF MEAN SEA LEVEL  
 ALL LATERALS ARE 20mmØ ID POLY

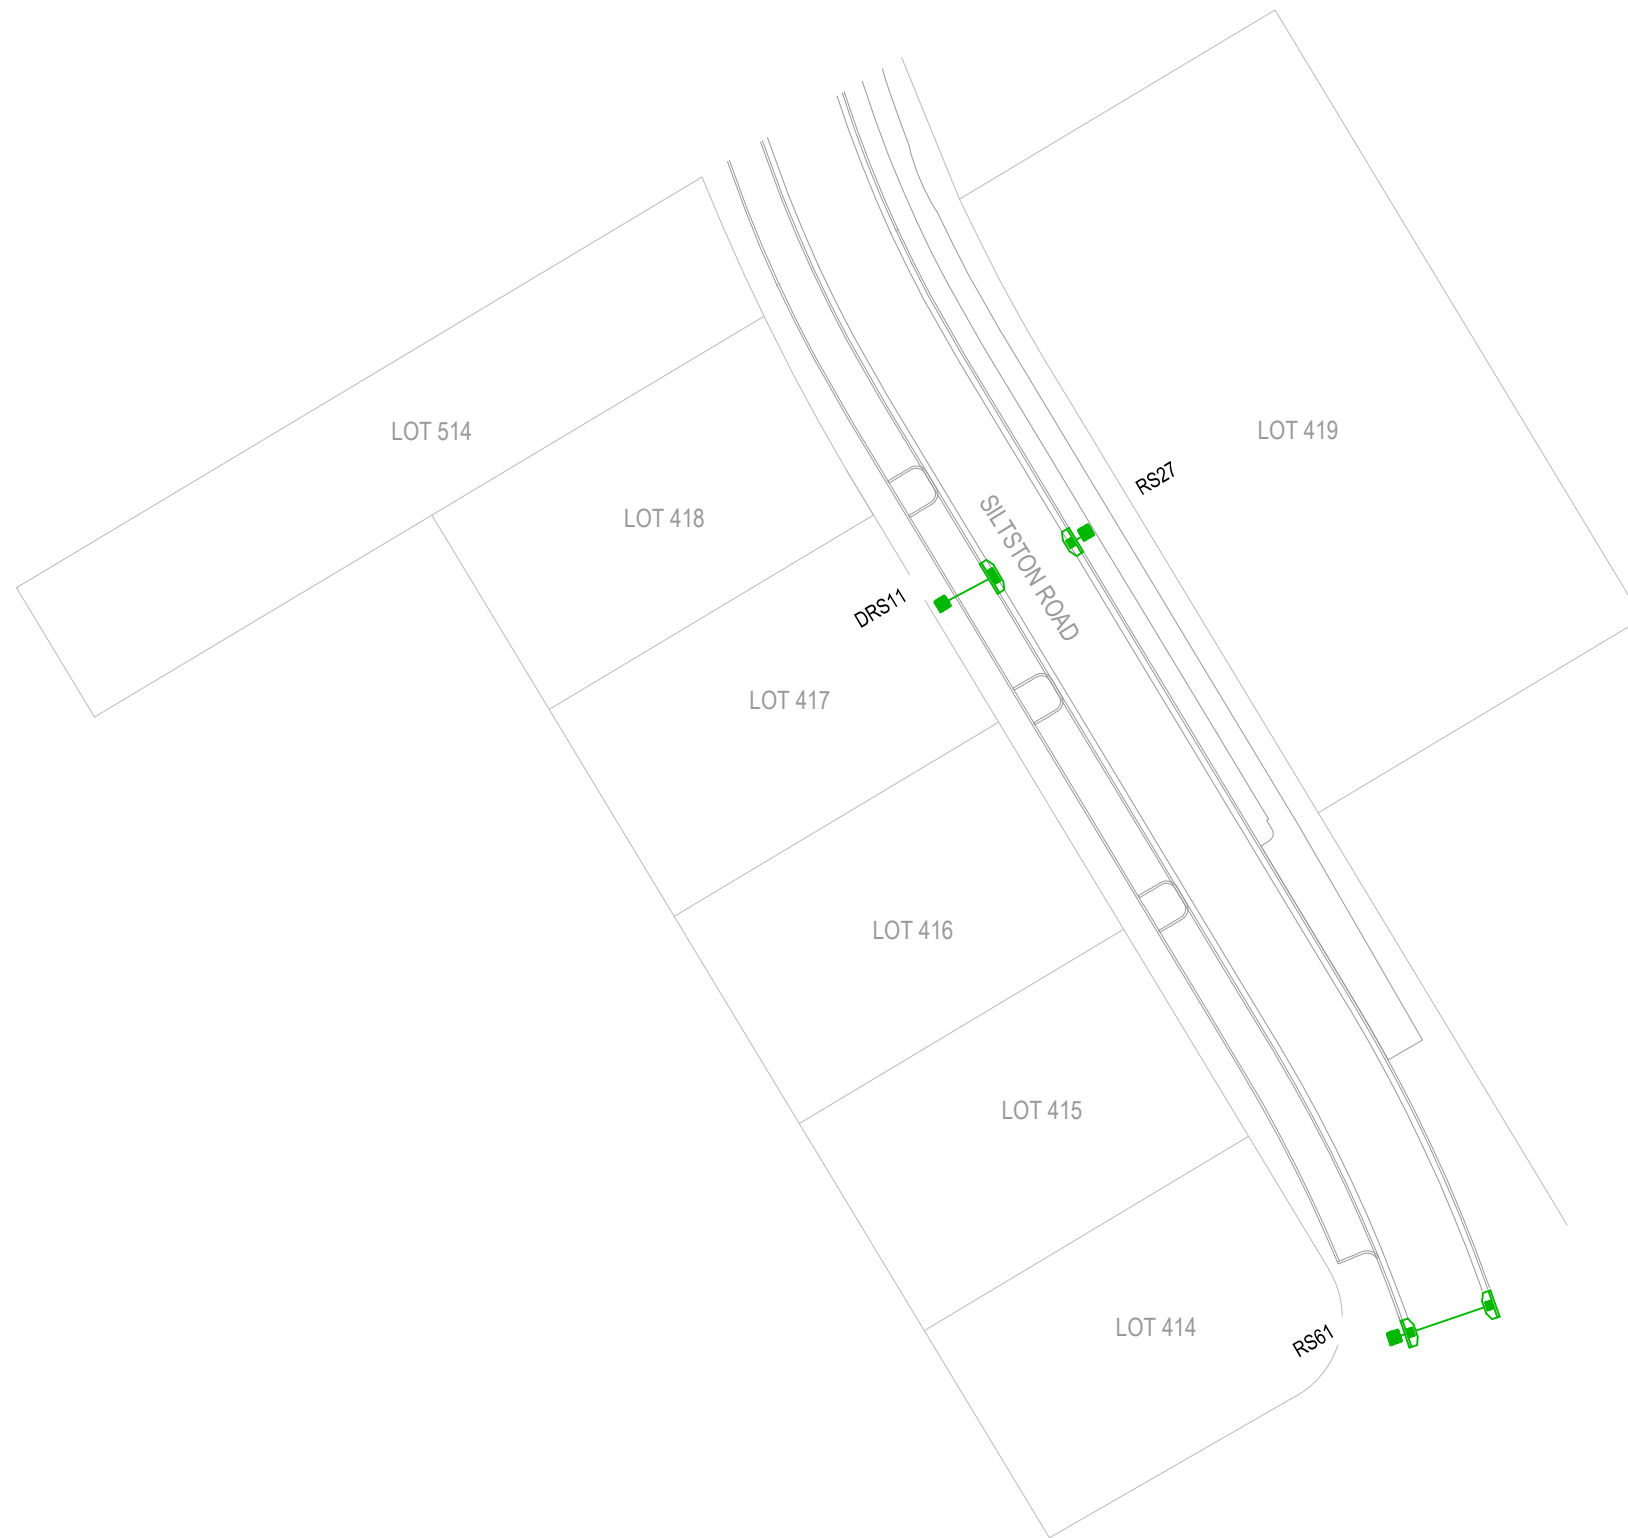

00/00000

CLIENT			REV	DATE	REVISION DETAILS	APPROVED	DRAWN A.GRAY	DESIGNED M.CROWE	PROJECT STONEBROOK ROLLESTON		AS BUILT	
							CHECKED D.WATSON				PROJECT No. 224926	
							APPROVED		TITLE STAGE 22 STORMWATER AS BUILT		SCALE AS SHOWN	SIZE A3
							DATE				DRAWING No.	REV
			A	07.04.14	AS BUILTS ISSUED		B.TOMS				DW-LD-S2-AB-SW-01	A