

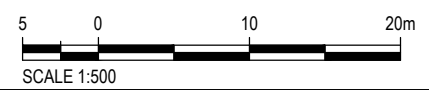


NOTES:

AS BUILT INFORMATION HAS BEEN SUPPLIED BY KBs CONTRACTING & QUARRIES LTD - FEBRUARY 2014.
 HEIGHTS ARE IN TERMS OF MEAN SEA LEVEL
 ALL LATERALS ARE 20mmØ ID POLY

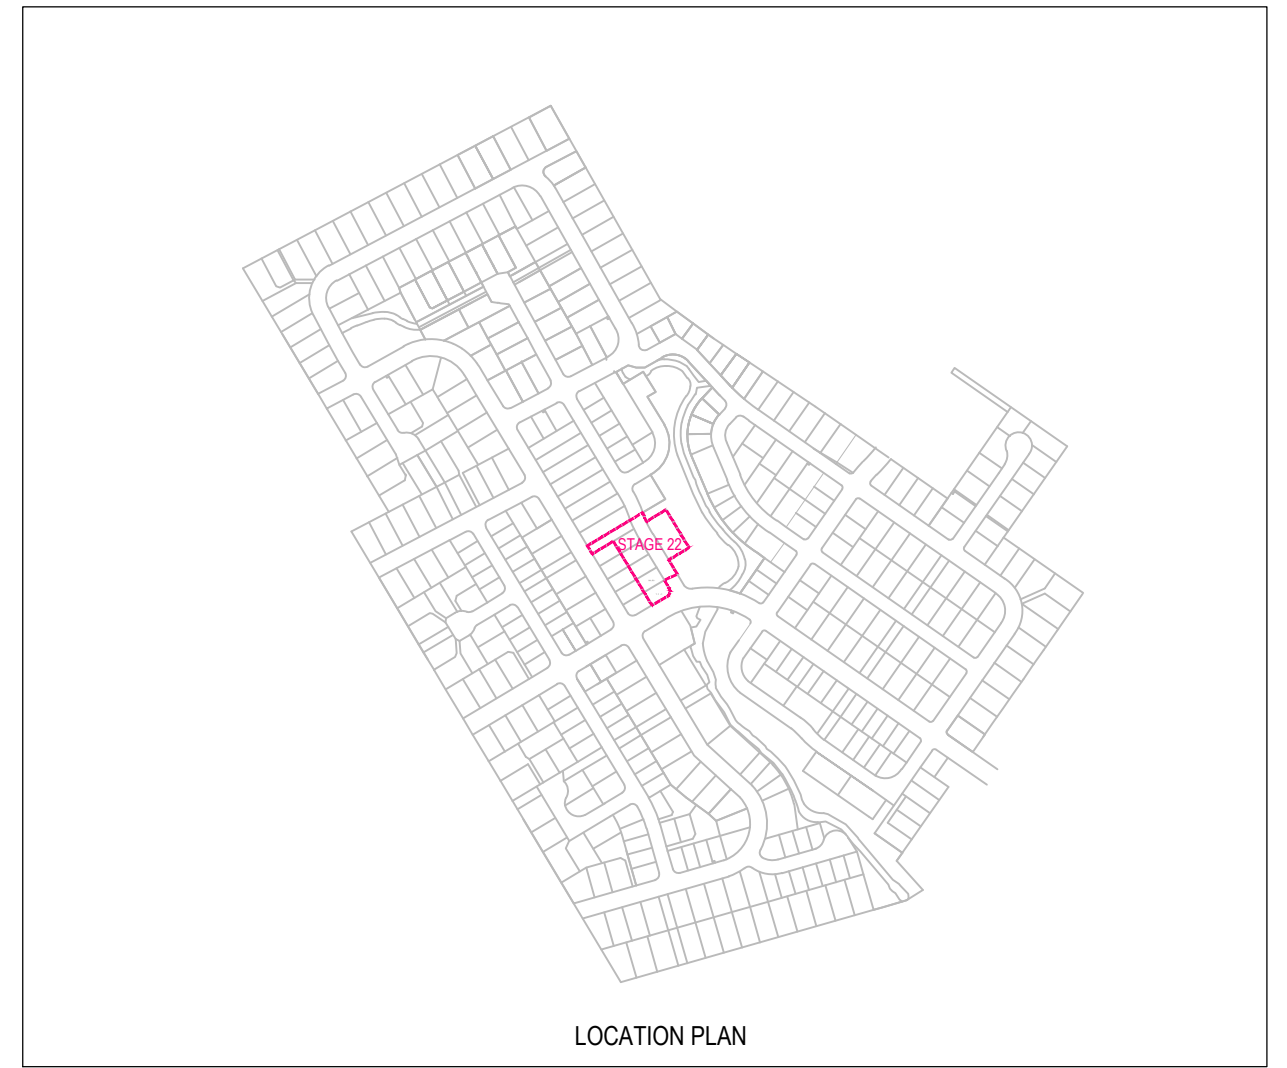

00/00000

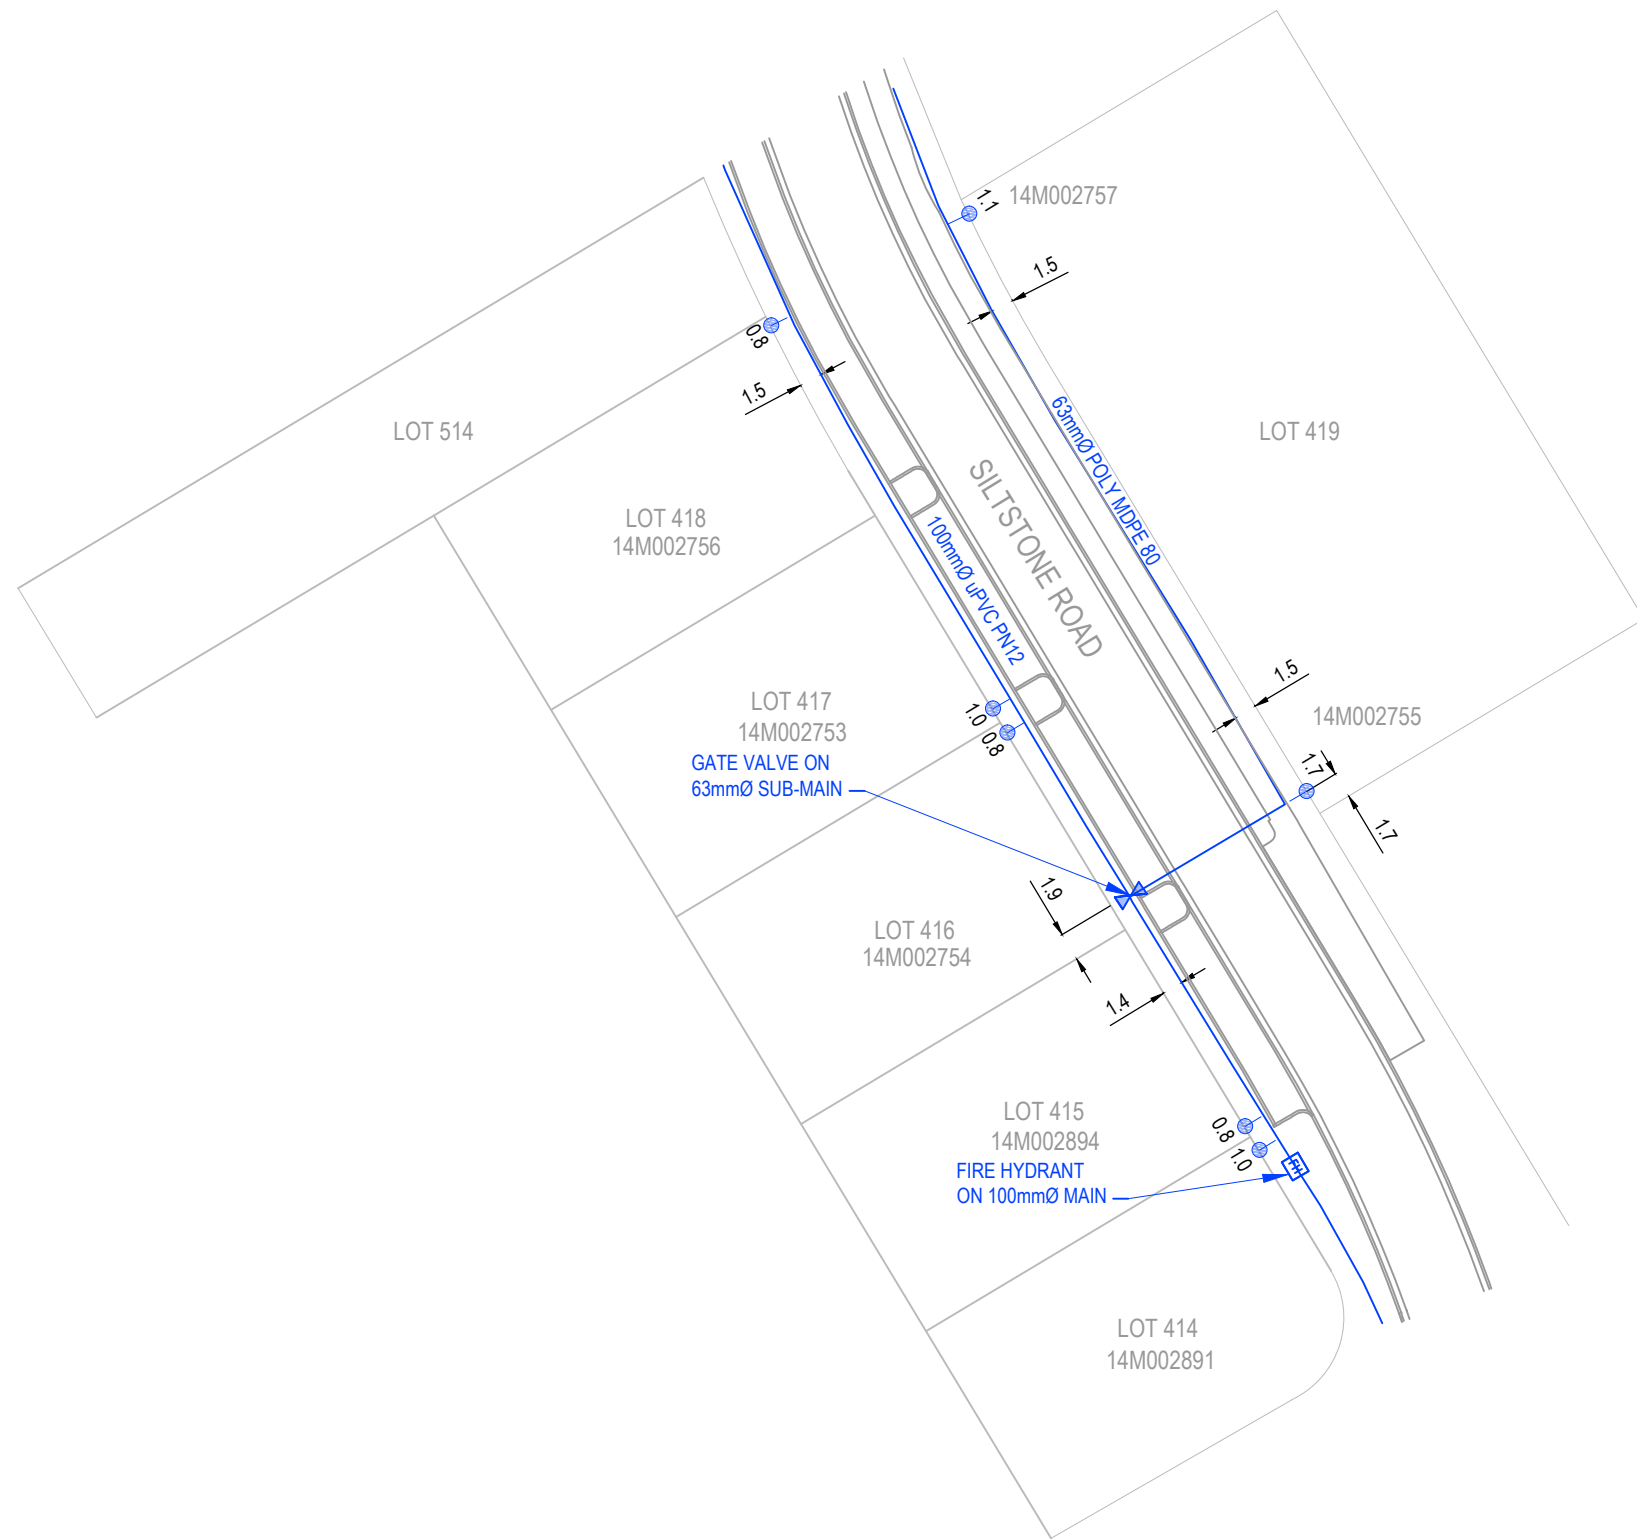

CLIENT

REV	DATE	REVISION DETAILS	APPROVED
A	07.04.14	AS BUILTS ISSUED	

DRAWN	DESIGNED
A.GRAY	M.CROWE
CHECKED	
D.WATSON	
APPROVED	DATE
B.TOMS	

PROJECT	AS BUILT
STONEBROOK ROLLESTON	PROJECT No.
	224926
TITLE	SCALE
STAGE 22	AS SHOWN
WATER	SIZE
AS BUILT	A3
	DRAWING No.
	DW-LD-S2-AB-W-01
	REV
	A

AS BUILT	PROJECT No.
	224926
SCALE	SIZE
AS SHOWN	A3
DRAWING No.	REV
DW-LD-S2-AB-W-01	A