


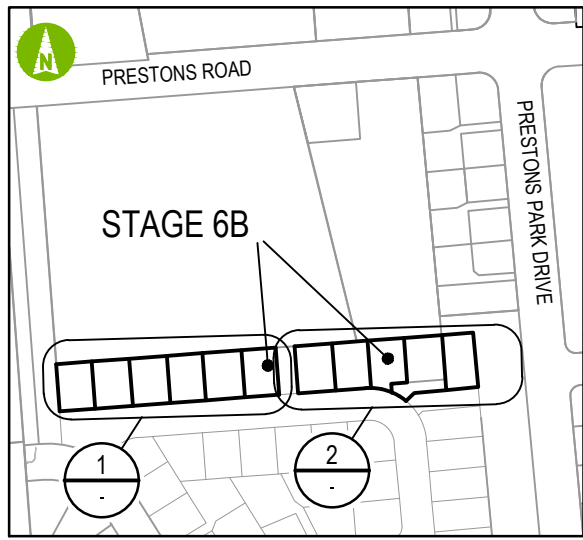

LOCATION PLAN

- NOTES:**
- KERB LEVELS ARE AT TOP OF KERB.
- SURVEY ORIGIN DATA**
- THE PROPERTY DATA HAS BEEN SOURCED FROM AURECON (NOVEMBER 2021) AND IS SUBJECT TO FINAL LEGAL REVIEW BY LAND INFORMATION NEW ZEALAND (LINZ).
 - VERTICAL ELEVATIONS ARE IN TERMS OF CHRISTCHURCH DRAINAGE DATUM, SCIRT PUBLISHED JUNE 2011.
 - THE ORIGIN OF LEVELS IS BM 3257 (EHDK), RL 15.160m

LEGEND

- EXISTING TREE
- STREET LIGHT
- DOUBLE SUMP
- SINGLE SUMP
- CORNER SUMP

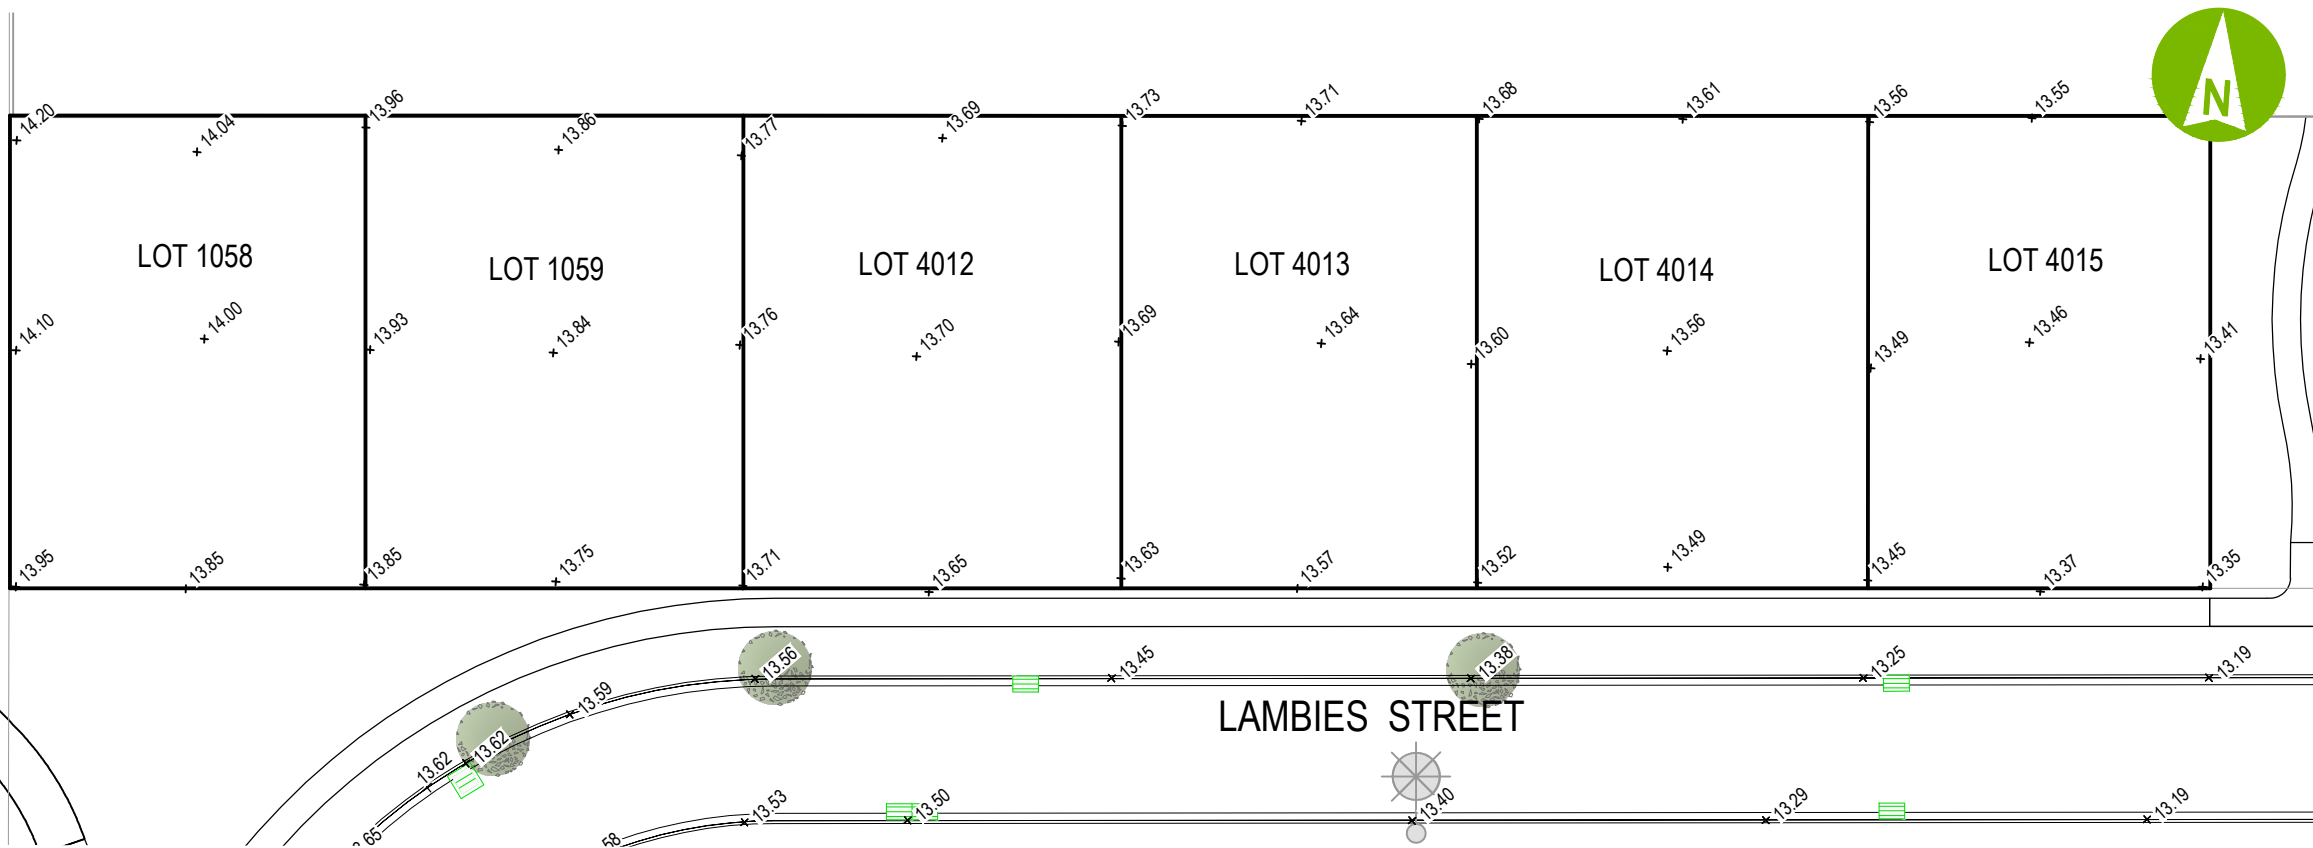


DIAGRAM 1
1:400


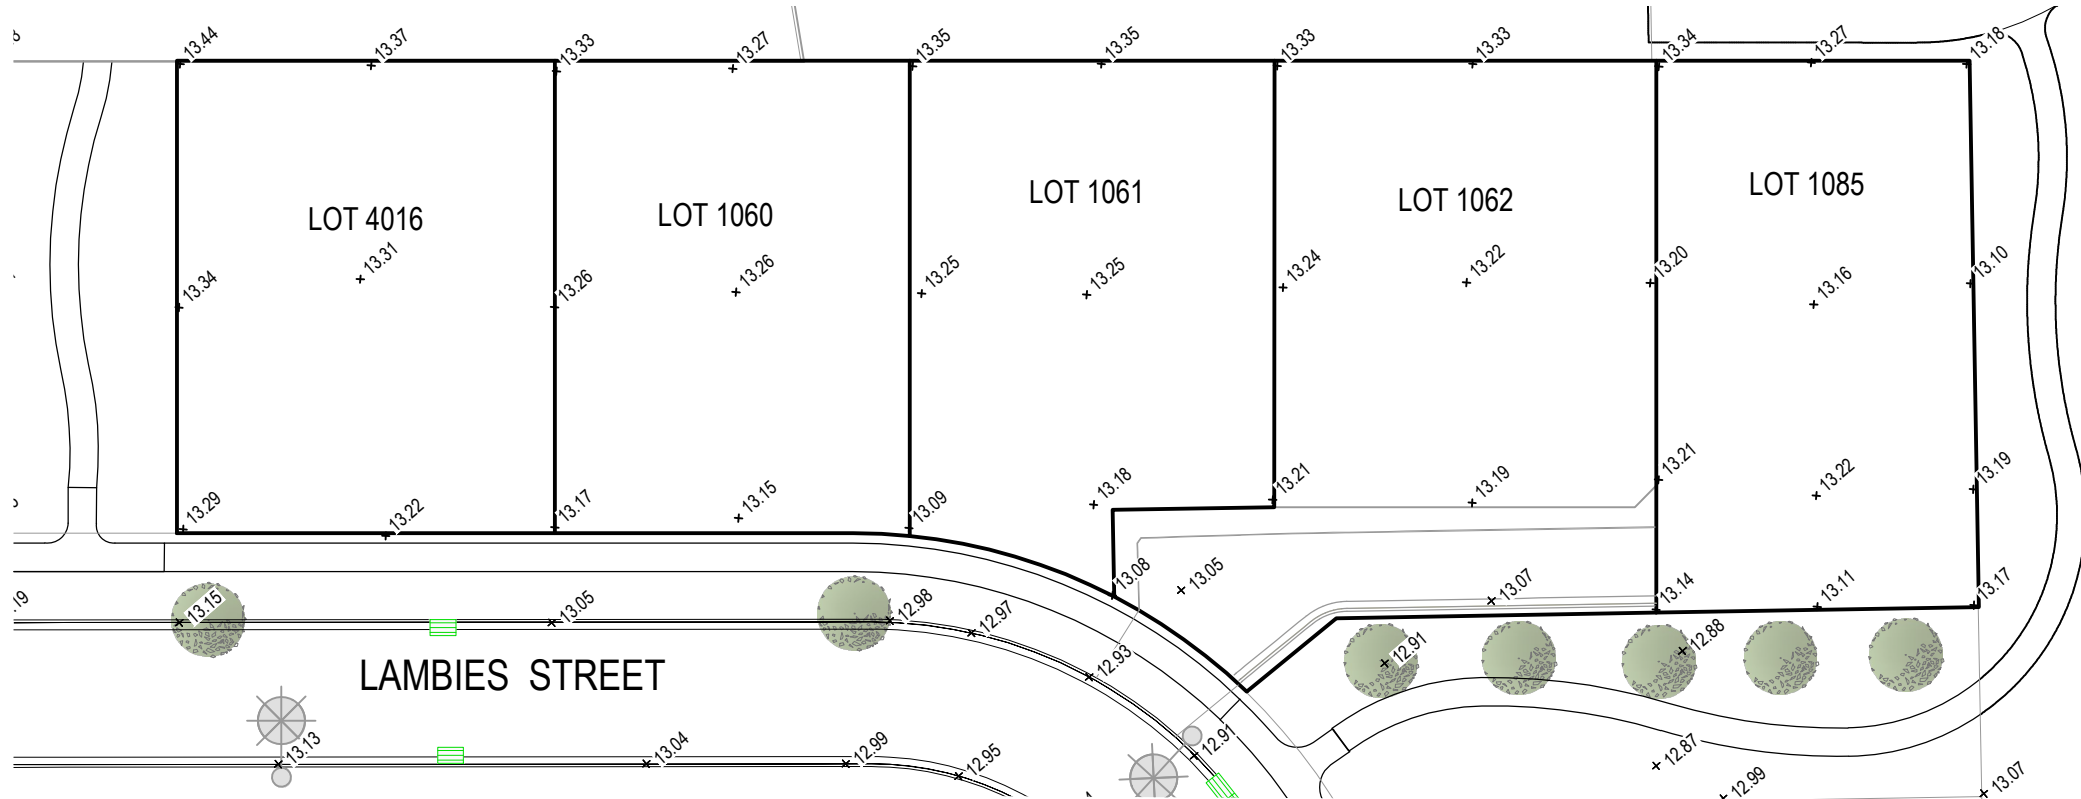


DIAGRAM 2
1:400

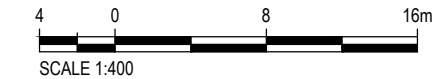

0000000

REV	DATE	REVISION DETAILS	APPROVED
A	03/02/22	ISSUE FOR INFORMATION	K ASHBY

DRAWN	DESIGNED
R DAWSON	R PINNER
CHECKED C DOHERTY	
APPROVED	
DATE	
K ASHBY	

PROJECT
PRESTONS PARK
TITLE
LOTS 1058-1062, 1085 & 4012-4016 SUB-STAGE 6B AS BUILT SPOT HEIGHTS

FOR INFORMATION	
PROJECT No. 235361	
SCALE 1:400	SIZE A3
DRAWING No. SU-PS-S6-IN-08	REV A