


LOCATION PLAN

NOTES:

- KERB LEVELS ARE AT TOP OF KERB.
- SURVEY ORIGIN DATA
 - THE PROPERTY DATA HAS BEEN SOURCED FROM AURECON (NOVEMBER 2021) AND IS SUBJECT TO FINAL LEGAL REVIEW BY LAND INFORMATION NEW ZEALAND (LINZ).
 - VERTICAL ELEVATIONS ARE IN TERMS OF CHRISTCHURCH DRAINAGE DATUM, SCIRT PUBLISHED JUNE 2011.
 - THE ORIGIN OF LEVELS IS BM 3257 (EHDK). RL 15.160m

LEGEND

- EXISTING TREE
- STREET LIGHT
- DOUBLE SUMP
- SINGLE SUMP
- CORNER SUMP

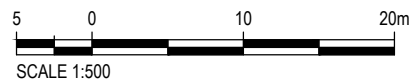

000000

CLIENT

REV	DATE	REVISION DETAILS	APPROVED	DRAWN	DESIGNED
A	03/02/22	ISSUE FOR INFORMATION	K ASHBY	R DAWSON	R PINNER
				CHECKED C DOHERTY	
				APPROVED	DATE
				K ASHBY	

PROJECT
PRESTONS PARK
TITLE
LOTS 1069 - 1075 STAGE 6C AS BUILT SPOT HEIGHTS

FOR INFORMATION
PROJECT No. 235361
SCALE 1:500
DRAWING No. SU-PS-S6-IN-09
SIZE A3
REV A