


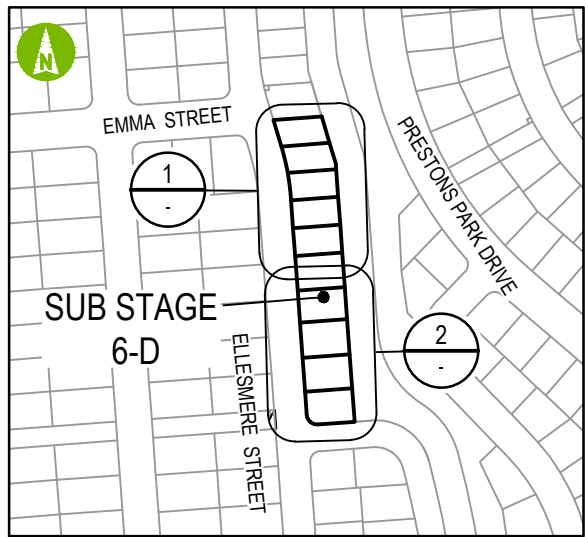

LOCATION PLAN

- NOTES:
- KERB LEVELS ARE AT TOP OF KERB.
- SURVEY ORIGIN DATA
- THE PROPERTY DATA HAS BEEN SOURCED FROM AURECON (NOVEMBER 2021) AND IS SUBJECT TO FINAL LEGAL REVIEW BY LAND INFORMATION NEW ZEALAND (LINZ) .
 - VERTICAL ELEVATIONS ARE IN TERMS OF CHRISTCHURCH DRAINAGE DATUM, SCIRT PUBLISHED JUNE 2011.
 - THE ORIGIN OF LEVELS IS BM 3257 (EHDK). RL 15.160m

LEGEND

- EXISTING TREE
- STREET LIGHT
- DOUBLE SUMP
- SINGLE SUMP
- CORNER SUMP

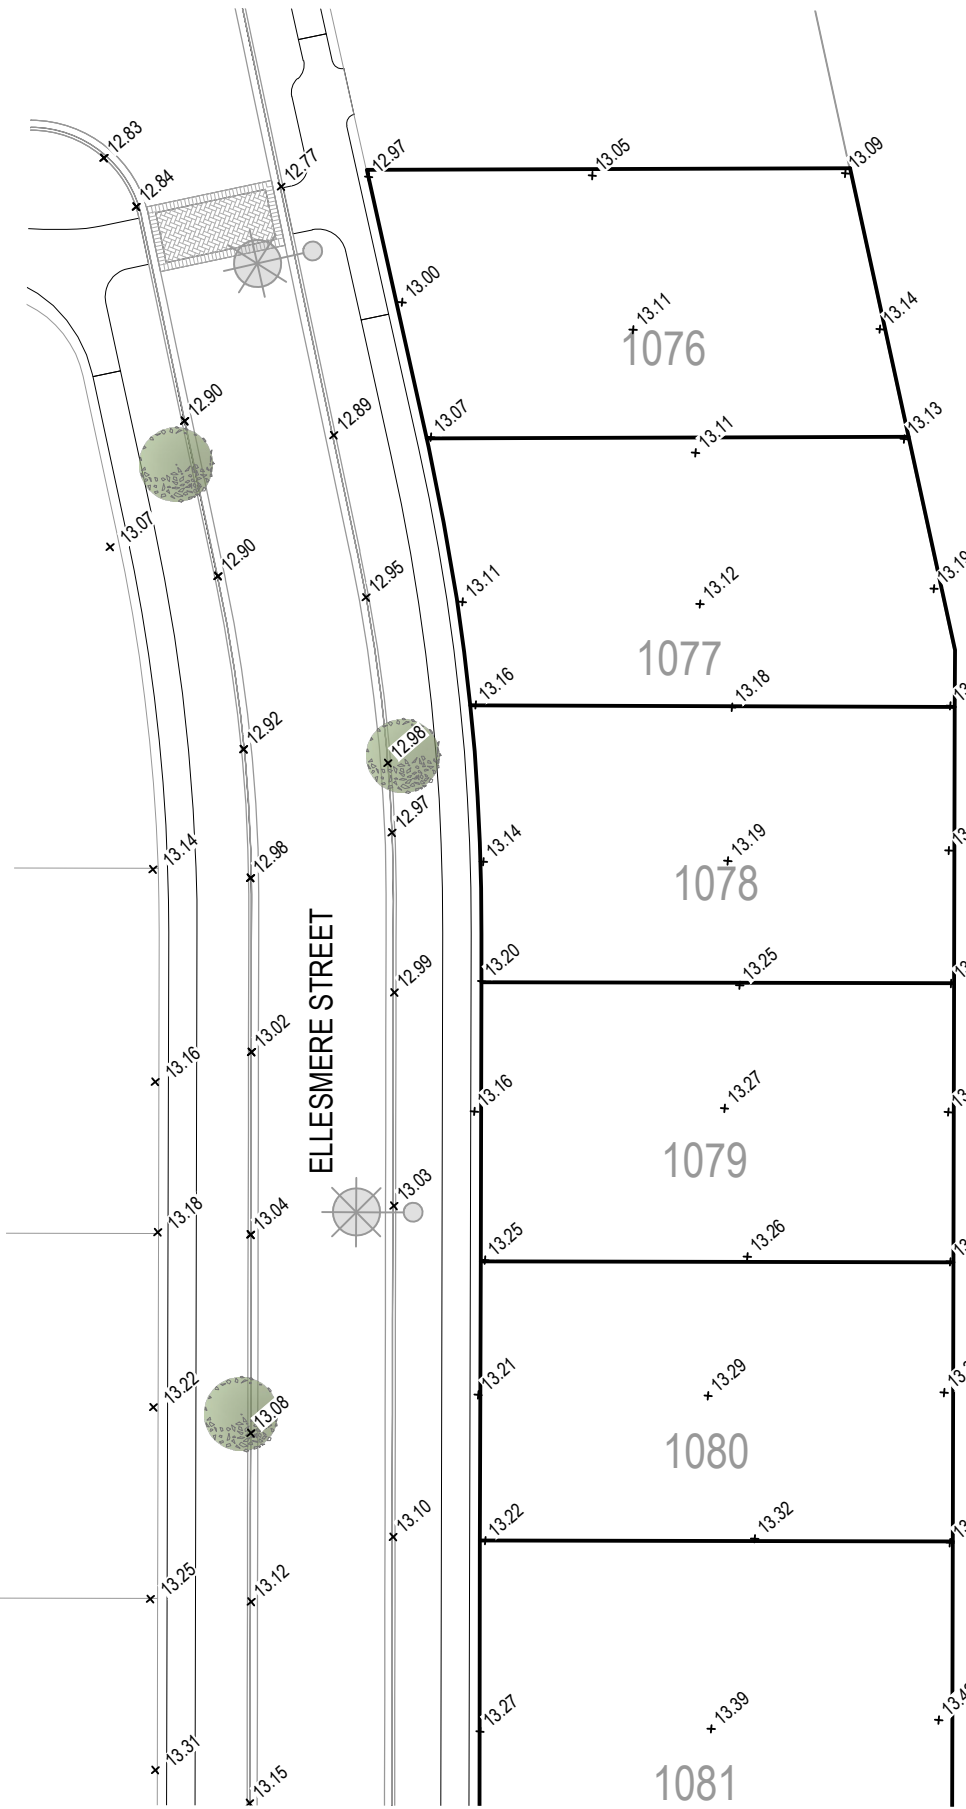
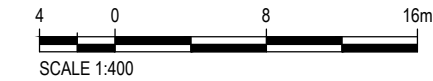


DIAGRAM 1
1:400

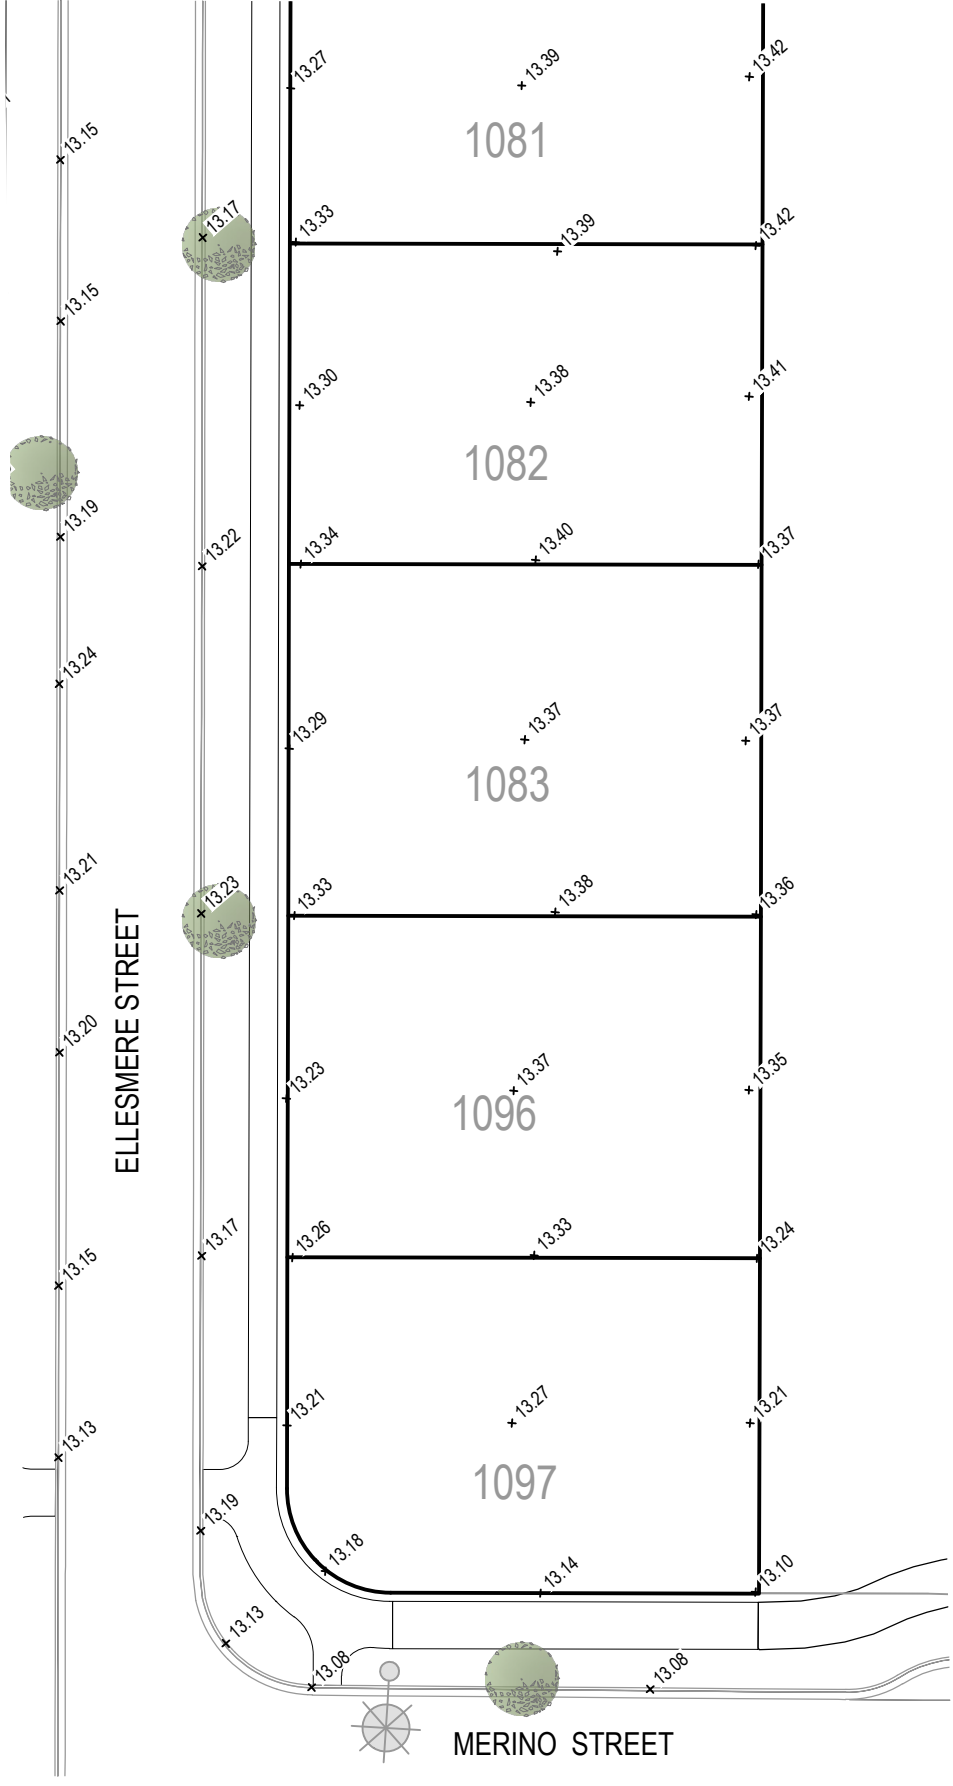


DIAGRAM 2
1:400

CLIENT			
REV	DATE	REVISION DETAILS	APPROVED
A	03/02/22	ISSUE FOR INFORMATION	K ASHBY

REV	DATE	REVISION DETAILS	APPROVED
A	03/02/22	ISSUE FOR INFORMATION	K ASHBY

DRAWN	DESIGNED
R DAWSON	R PINNER
CHECKED	
C DOHERTY	
APPROVED	
DATE	
K ASHBY	

PROJECT	
PRESTONS PARK	
TITLE	
SUB STAGE 6-D AS BUILT SPOT HEIGHTS	

FOR INFORMATION	
PROJECT No. 235361	
SCALE 1:400	SIZE A3
DRAWING No. SU-PS-S6-IN-10	REV A