


LOCATION PLAN

NOTES:

- THE PROPERTY DATA HAS BEEN SOURCED FROM AURECON (NOVEMBER 2021) AND IS SUBJECT TO FINAL LEGAL REVIEW BY LAND INFORMATION NEW ZEALAND (LINZ).

LEGEND

- STORMWATER TO STREET
- SEWER LATERAL TO MAINS
- W — WATER SUBMAIN

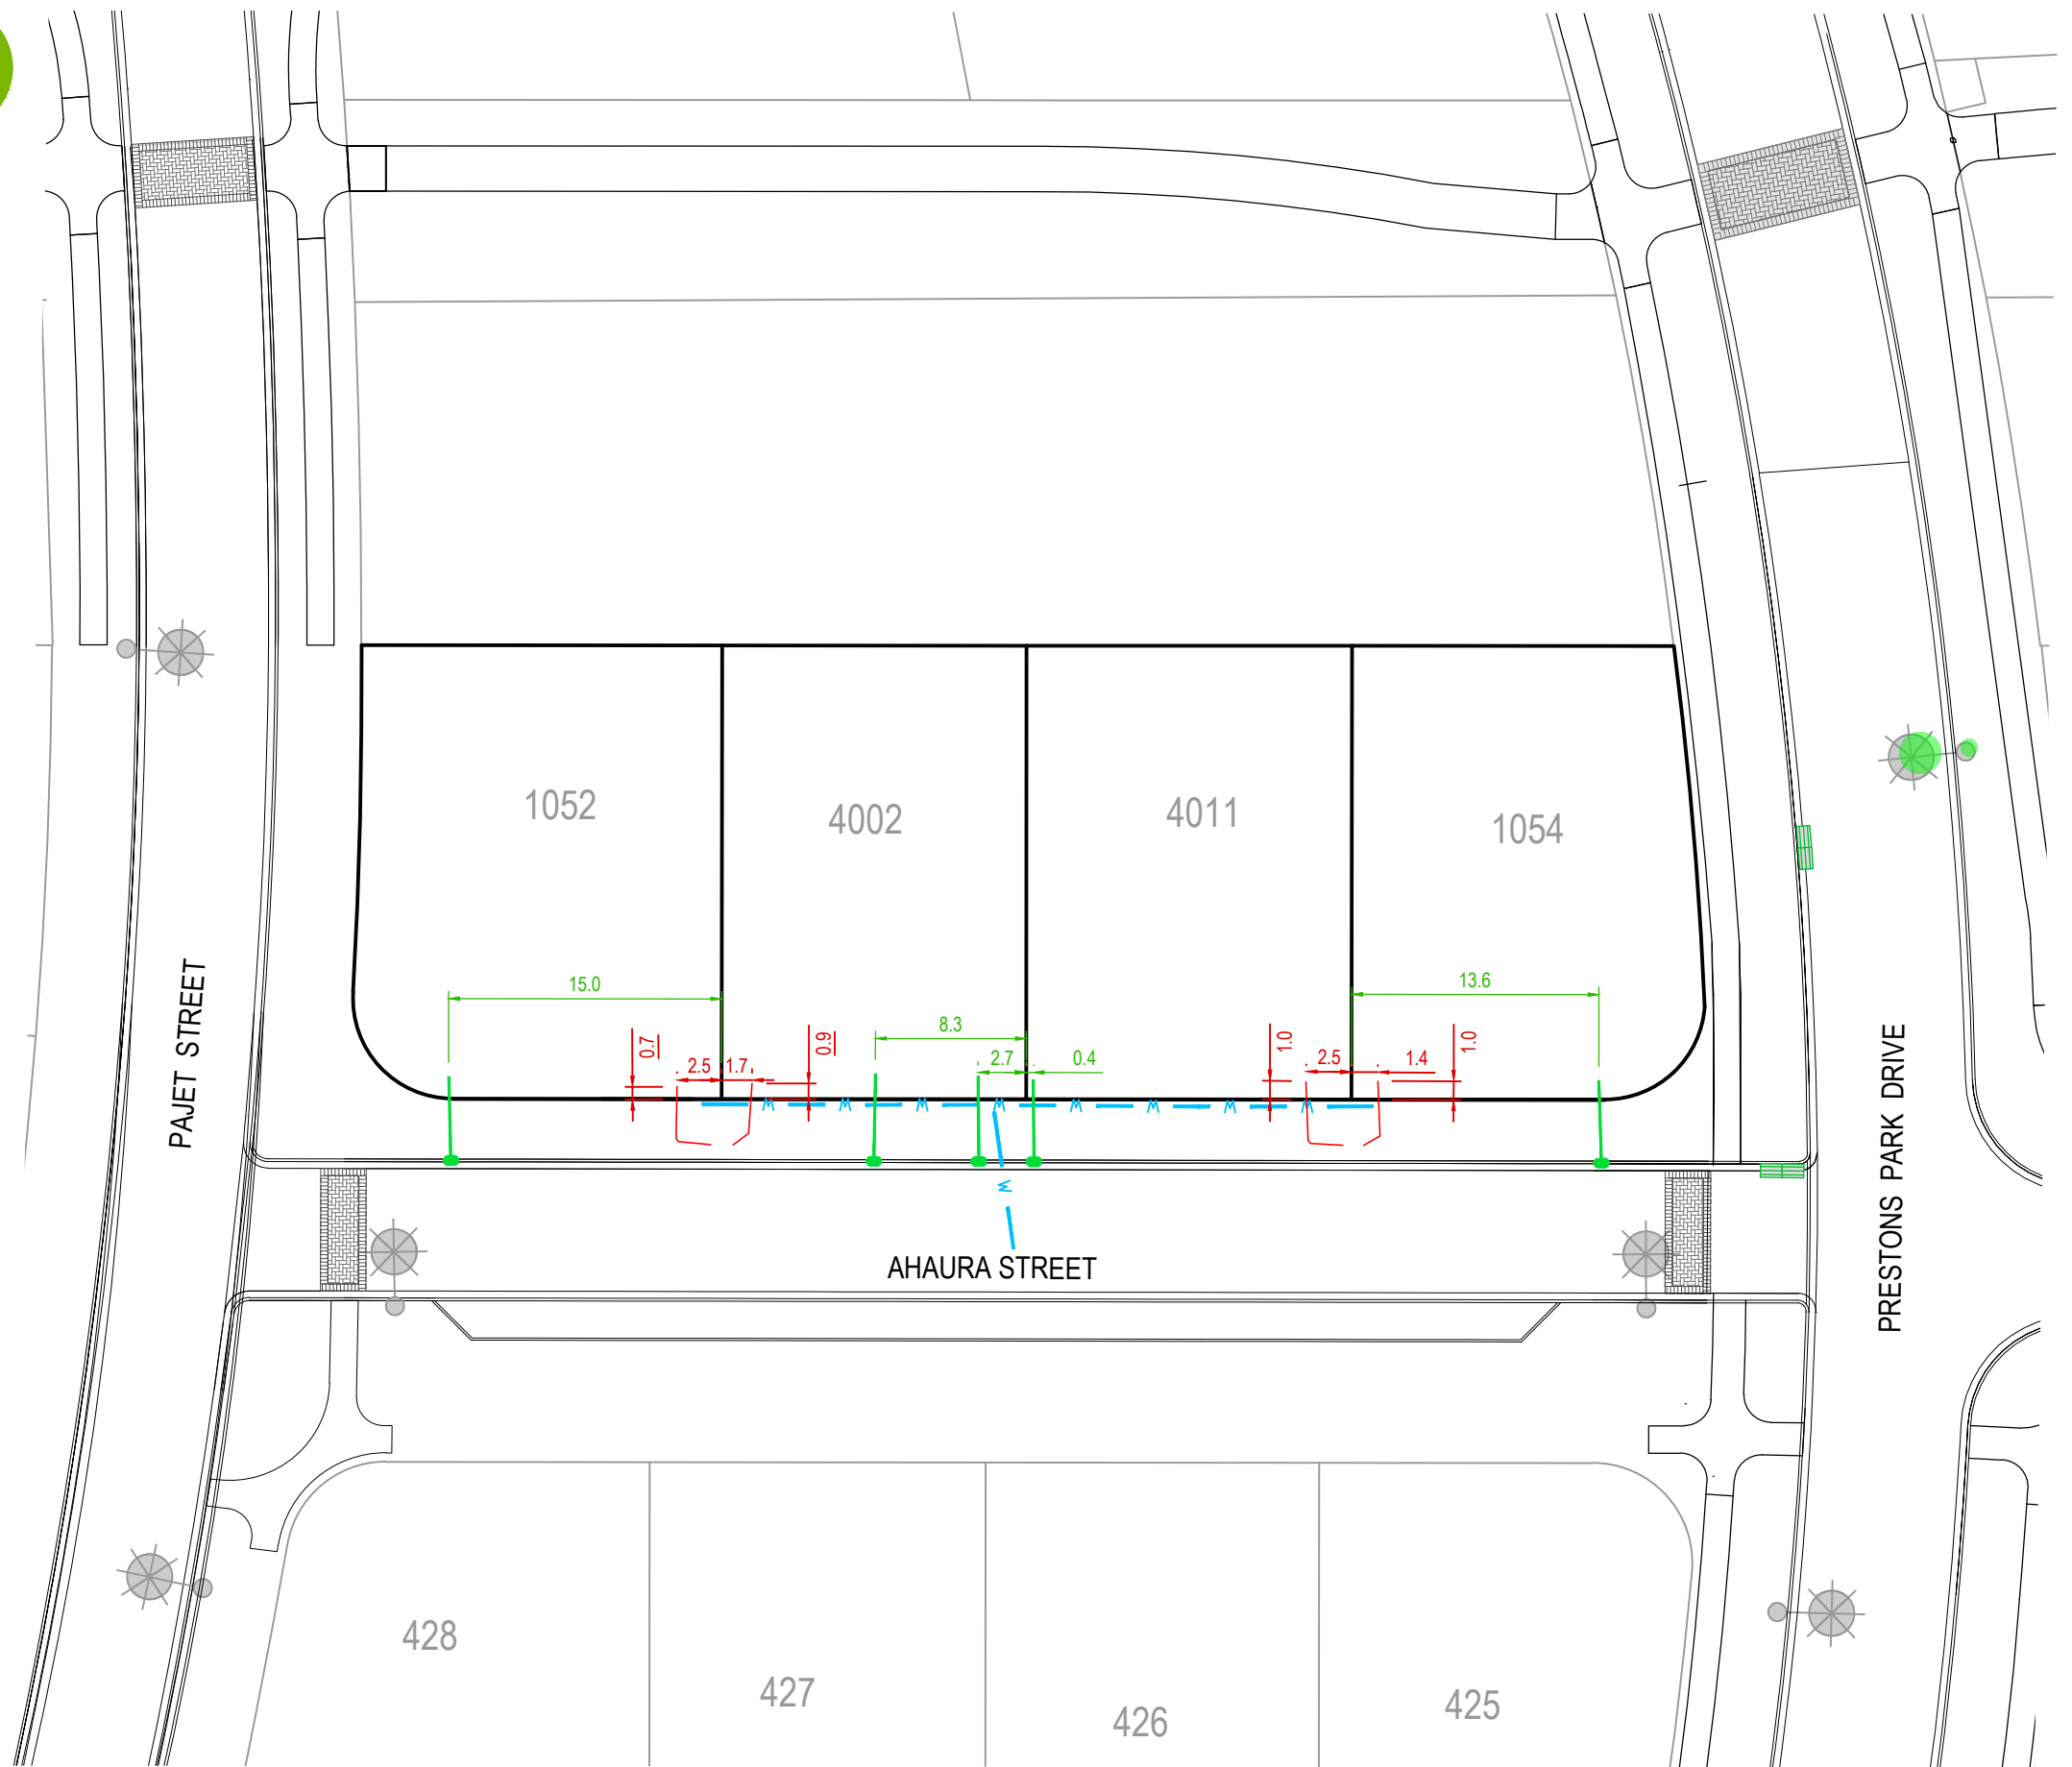

000000

REV	DATE	REVISION DETAILS	APPROVED	DRAWN	DESIGNED
A	06/12/21	ISSUE FOR INFORMATION	K ASHBY	R DAWSON	
				CHECKED	
				APPROVED	DATE

PROJECT	
PRESTONS PARK	
TITLE	
SUB STAGE 6-F AS BUILT SEWER, STORMWATER AND WATER	

FOR INFORMATION	
PROJECT No.	235361
SCALE	1:400
DRAWING No.	LD-PS-DCF-AB-02
SIZE	A3
REV	A