

LOCATION PLAN

NOTES:

- THE PROPERTY DATA HAS BEEN SOURCED FROM AURECON (NOVEMBER 2021) AND IS SUBJECT TO FINAL LEGAL REVIEW BY LAND INFORMATION NEW ZEALAND (LINZ).

LEGEND

- STORMWATER TO STREET
- SEWER LATERAL TO MAINS
- WATER SUBMAIN

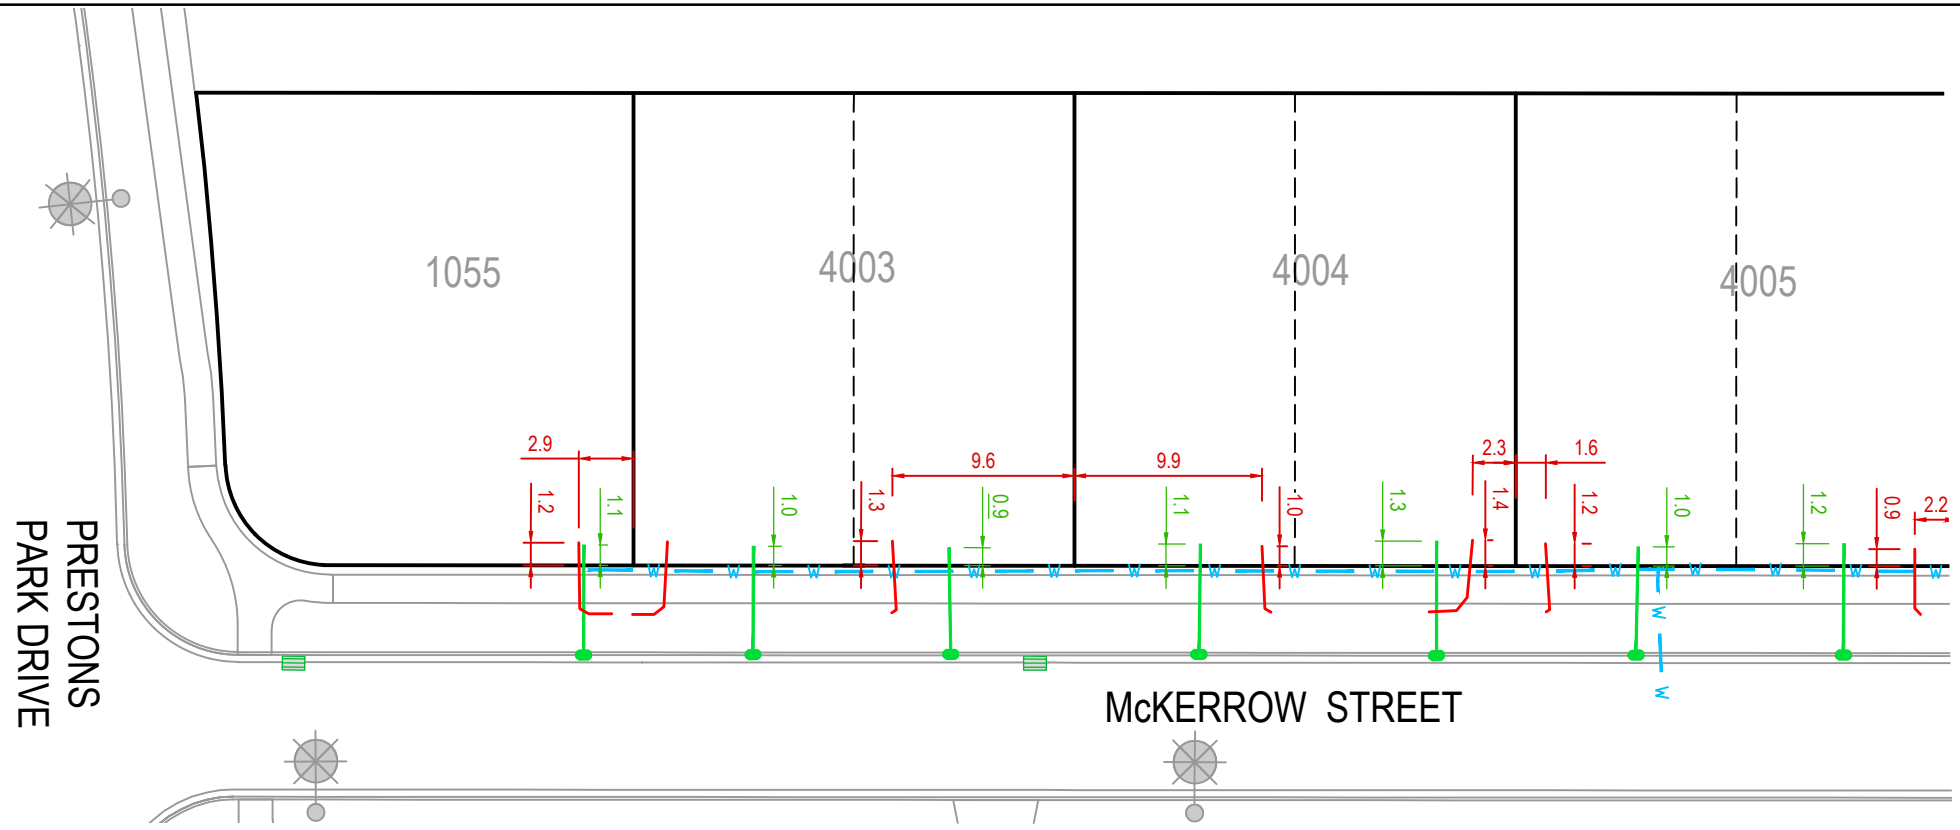


DIAGRAM 1

1:400

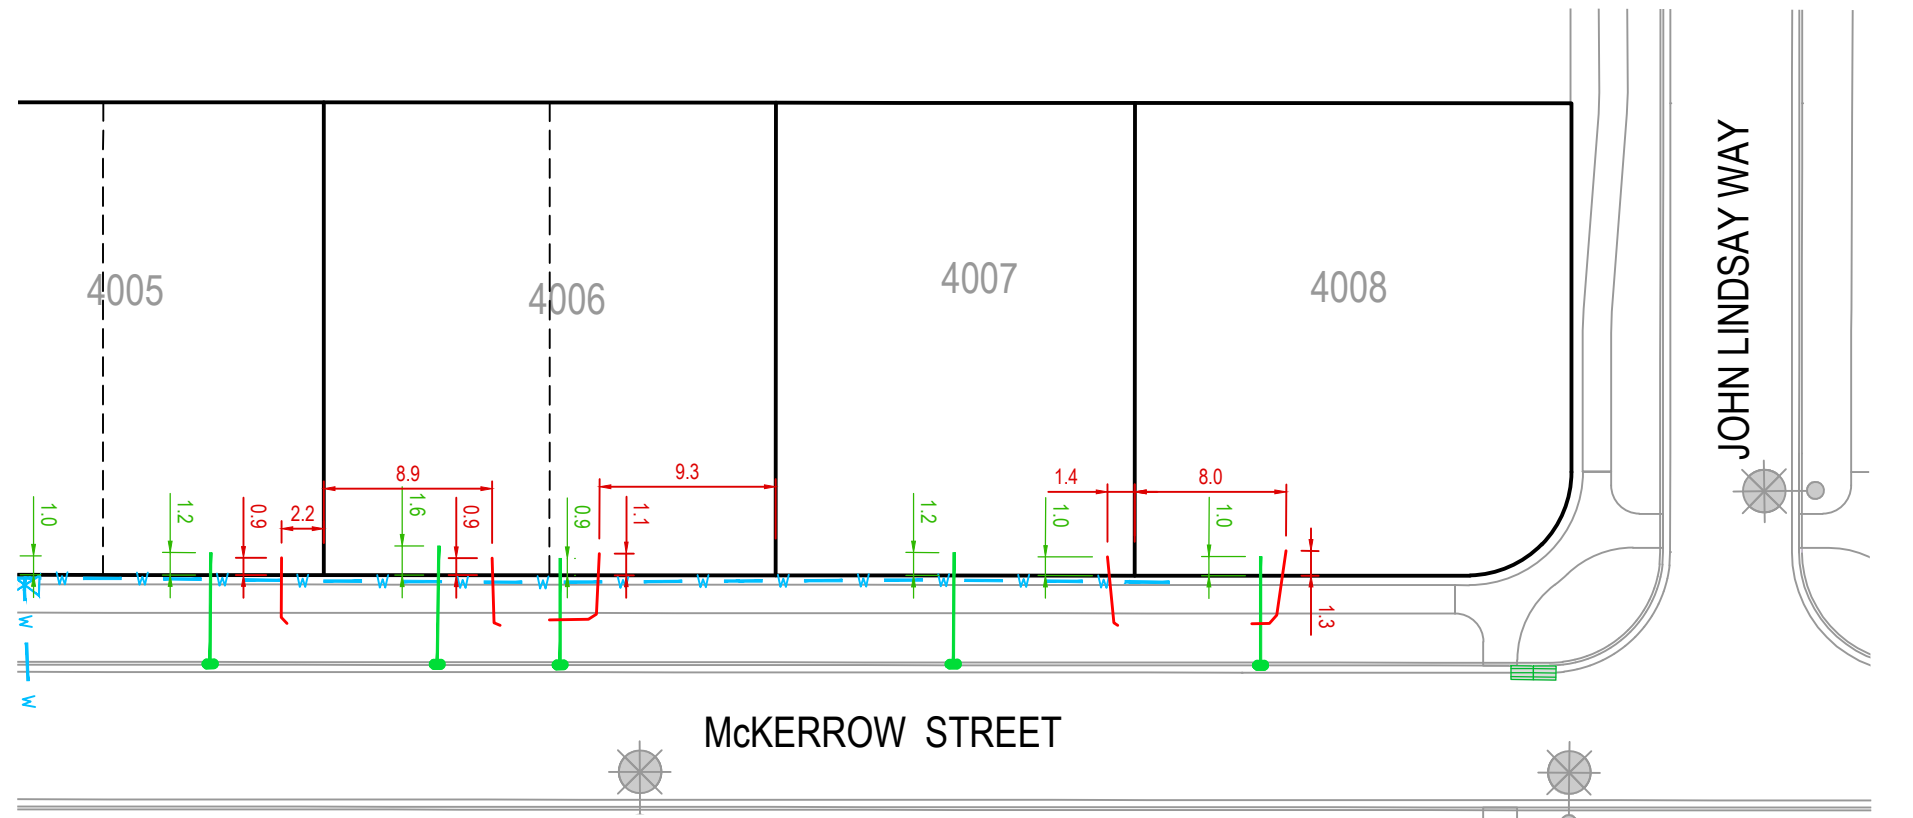


DIAGRAM 2

1:400



REV	DATE	REVISION DETAILS	APPROVED	DRAWN	DESIGNED
A	06/12/21	ISSUE FOR INFORMATION	K ASHBY	R DAWSON	
				CHECKED	
				APPROVED	DATE

PROJECT
PRESTONS PARK
TITLE
SUB STAGE 6-G AS BUILT SEWER, STORMWATER AND WATER

FOR INFORMATION
PROJECT No. 235361
SCALE 1:400
DRAWING No. LD-PS-DCG-AB-02
SIZE A3
REV A