



LOCATION PLAN

NOTES:

- THE PROPERTY DATA HAS BEEN SOURCED FROM AURECON (NOVEMBER 2021) AND IS SUBJECT TO FINAL LEGAL REVIEW BY LAND INFORMATION NEW ZEALAND (LINZ).

LEGEND

- STORMWATER TO STREET
- SEWER LATERAL TO MAINS
- WATER SUBMAIN

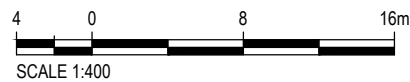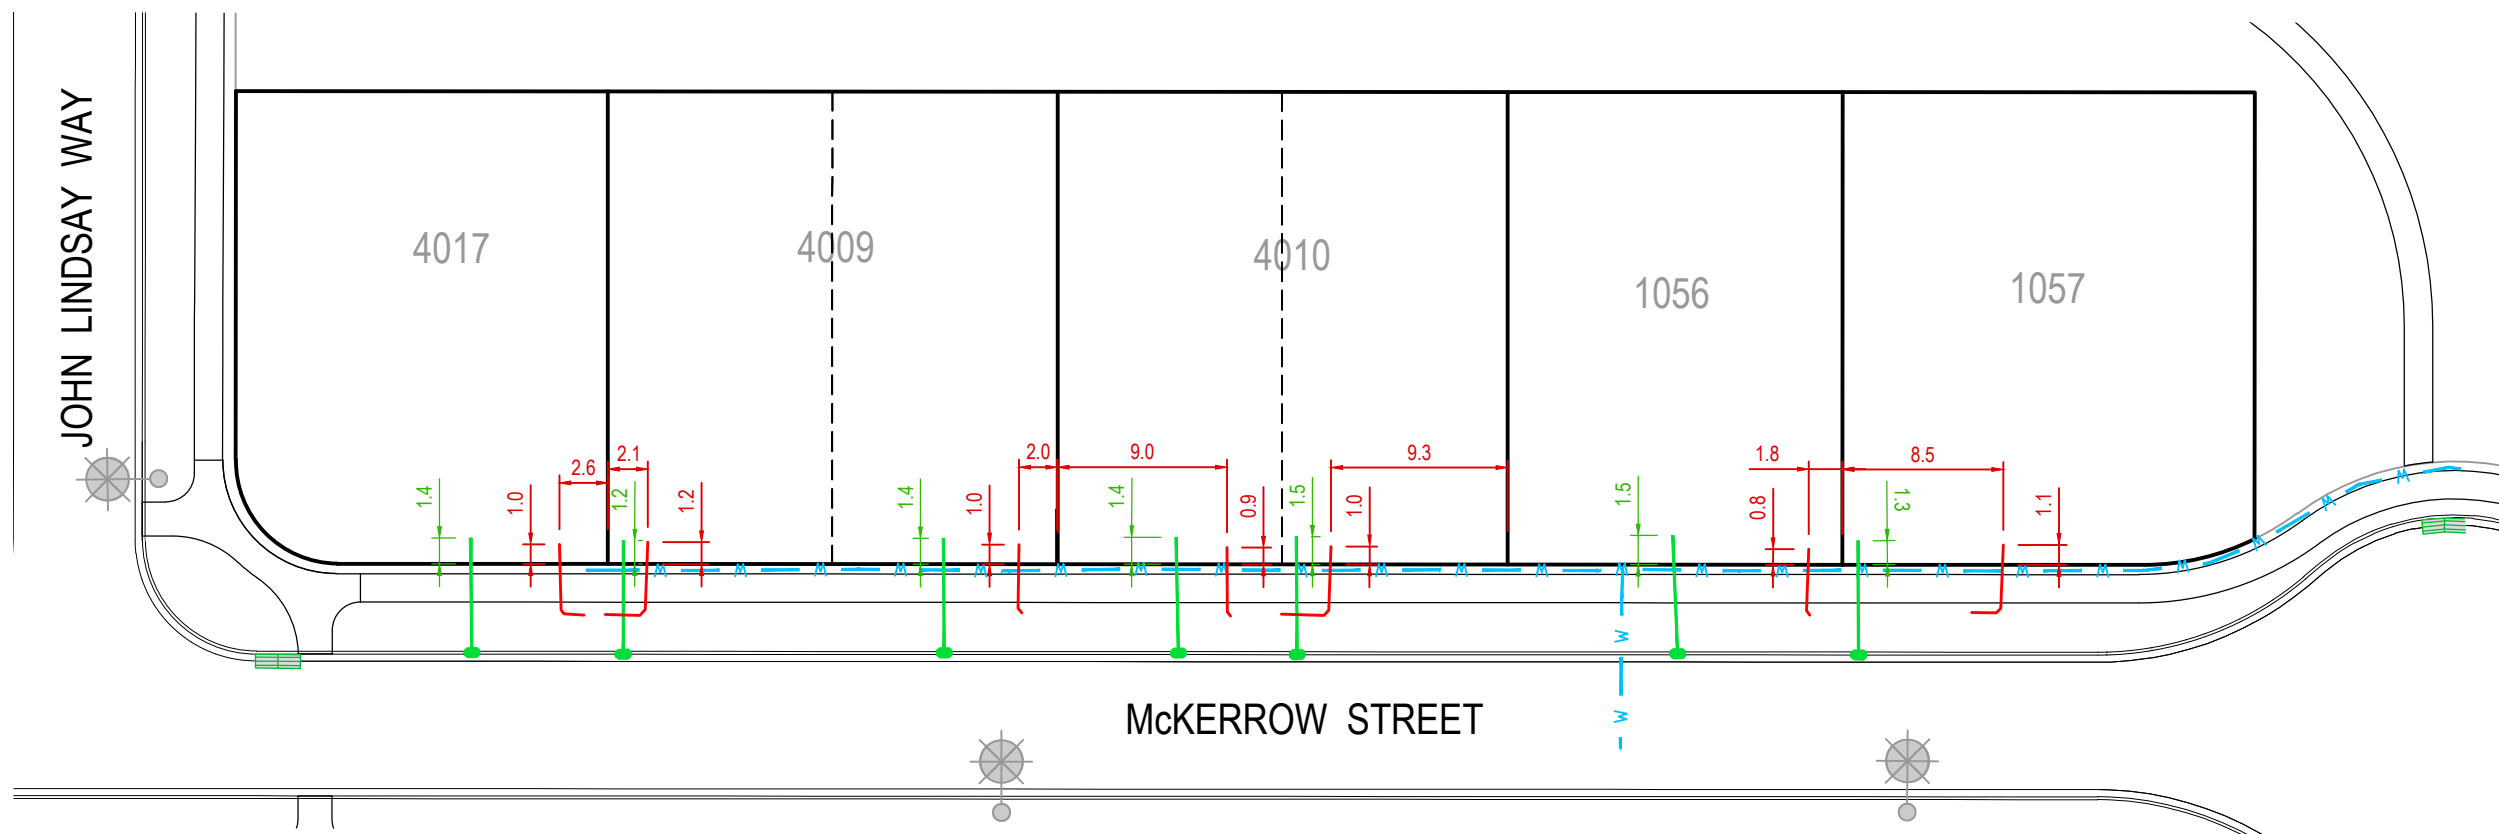

000000



CLIENT



REV	DATE	REVISION DETAILS	APPROVED
A	06/12/21	ISSUE FOR INFORMATION	K ASHBY

DRAWN	DESIGNED
R DAWSON	
CHECKED	
APPROVED	
	DATE

PROJECT
PRESTONS PARK
TITLE
SUB STAGE 6-H AS BUILT SEWER, STORMWATER AND WATER

FOR INFORMATION	
PROJECT No.	235361
SCALE	1:400
DRAWING No.	LD-PS-DCH-AB-02
SIZE	A3
REV	A