


LOCATION PLAN

NOTES:

- KERB LEVELS ARE AT TOP OF KERB.
- SURVEY ORIGIN DATA
 - THE PROPERTY DATA HAS BEEN SOURCED FROM AURECON (NOVEMBER 2021) AND IS SUBJECT TO FINAL LEGAL REVIEW BY LAND INFORMATION NEW ZEALAND (LINZ).
 - VERTICAL ELEVATIONS ARE IN TERMS OF CHRISTCHURCH DRAINAGE DATUM, SCIRT PUBLISHED JUNE 2011.
 - THE ORIGIN OF LEVELS IS BM 3257 (EHDK). RL 15.160m

LEGEND

- EXISTING TREE
- STREET LIGHT
- DOUBLE SUMP
- SINGLE SUMP
- CORNER SUMP

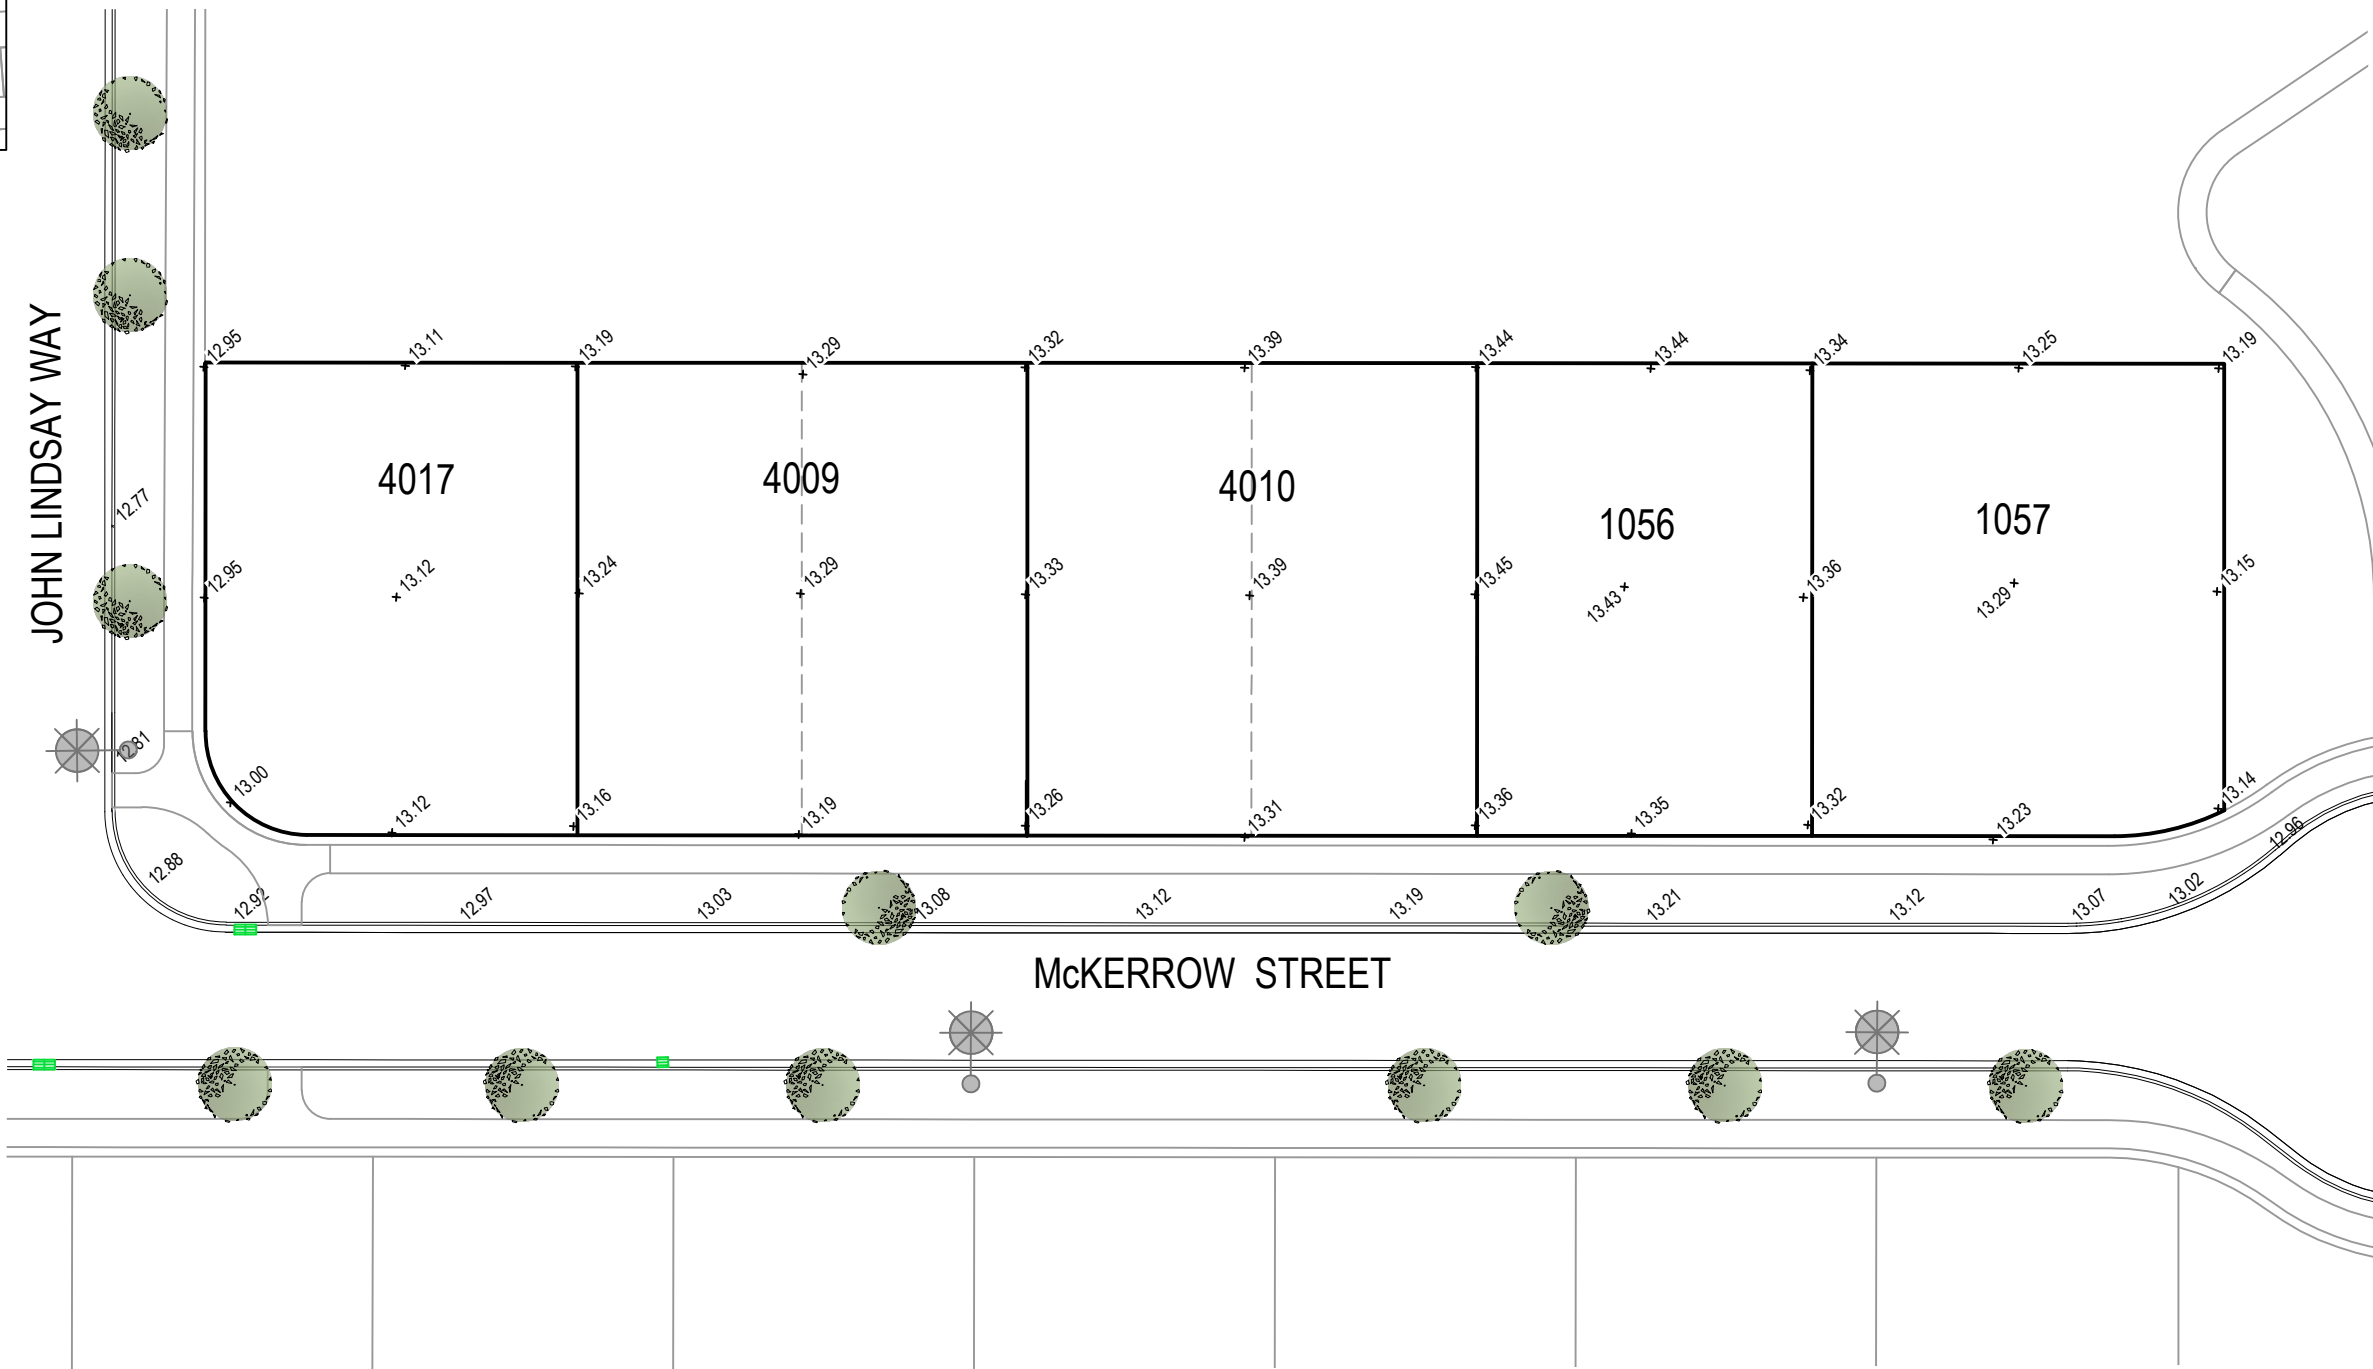

000000

CLIENT

REV	DATE	REVISION DETAILS	APPROVED
A	03/02/22	ISSUE FOR INFORMATION	K ASHBY

DRAWN	DESIGNED
R DAWSON	R PINNER
CHECKED	
C DOHERTY	
APPROVED	
K ASHBY	
DATE 03/02/22	

PROJECT
PRESTONS PARK
TITLE
SUB STAGE 6-H AS BUILT SPOT HEIGHTS

FOR INFORMATION	
PROJECT No.	235361
SCALE	1:400
SIZE	A3
DRAWING No.	SU-PS-S6-IN-14
REV	A