

LOCATION PLAN


NOTES:

• KERB LEVELS ARE AT TOP OF KERB.

SURVEY ORIGIN DATA

- THE PROPERTY DATA HAS BEEN SOURCED FROM AURECON (NOVEMBER 2021) AND IS SUBJECT TO FINAL LEGAL REVIEW BY LAND INFORMATION NEW ZEALAND (LINZ).
- VERTICAL ELEVATIONS ARE IN TERMS OF CHRISTCHURCH DRAINAGE DATUM, SCIRT PUBLISHED JUNE 2011.
- THE ORIGIN OF LEVELS IS BM 3257 (EHDK). RL 15.160m



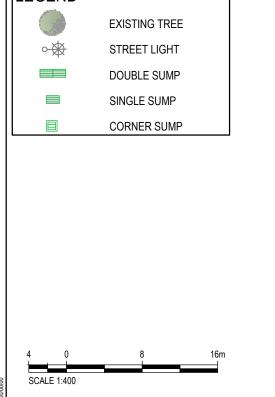







CLIENT

APPROVED	DRAWN	DESIGNED
K ASHBY	R DAWSON	R PINNER
	CHEC	CKED
	C DOF	IERTY
	APPR	OVED
		DATE
		03/02/22
	K ASHBY	,
		K ASHBY R DAWSON CHEC C DOH APPR

PROJECT FOR INFORMATION PRESTONS PARK TITLE SUB STAGE 6-I FOR INFORMATION PROJECT No. 235361 SCALE SIZE 1:400 A3 DRAWING No. REV			
235361 TITLE SCALE SIZE 1:400 A3	PROJECT	FOR INFORMATION	
235361 TITLE SCALE SIZE 1:400 A3	DDECTONG DADIZ		
SCALE SIZE 1:400 A3	PRESTONS PARK	PROJECT No.	
SCALE SIZE 1:400 A3		235361	
1:400 A3	TITLE		
SUB STAGE 6-1 DRAWING NO. REV		1:400	A3
DIAMING NO. INC.	SUB STAGE 6-1	DRAWING No.	REV
AS BUILT SPOT HEIGHTS SU-PS-S6-IN-15 A	AS BUILT SPOT HEIGHTS	SU-PS-S6-IN-15	Α