

LOCATION PLAN

NOTES:

- THE PROPERTY DATA HAS BEEN SOURCED FROM AURECON (NOVEMBER 2021) AND IS SUBJECT TO FINAL LEGAL REVIEW BY LAND INFORMATION NEW ZEALAND (LINZ).

LEGEND

- STORMWATER TO STREET
- SEWER LATERAL TO MAINS
- W WATER SUBMAIN

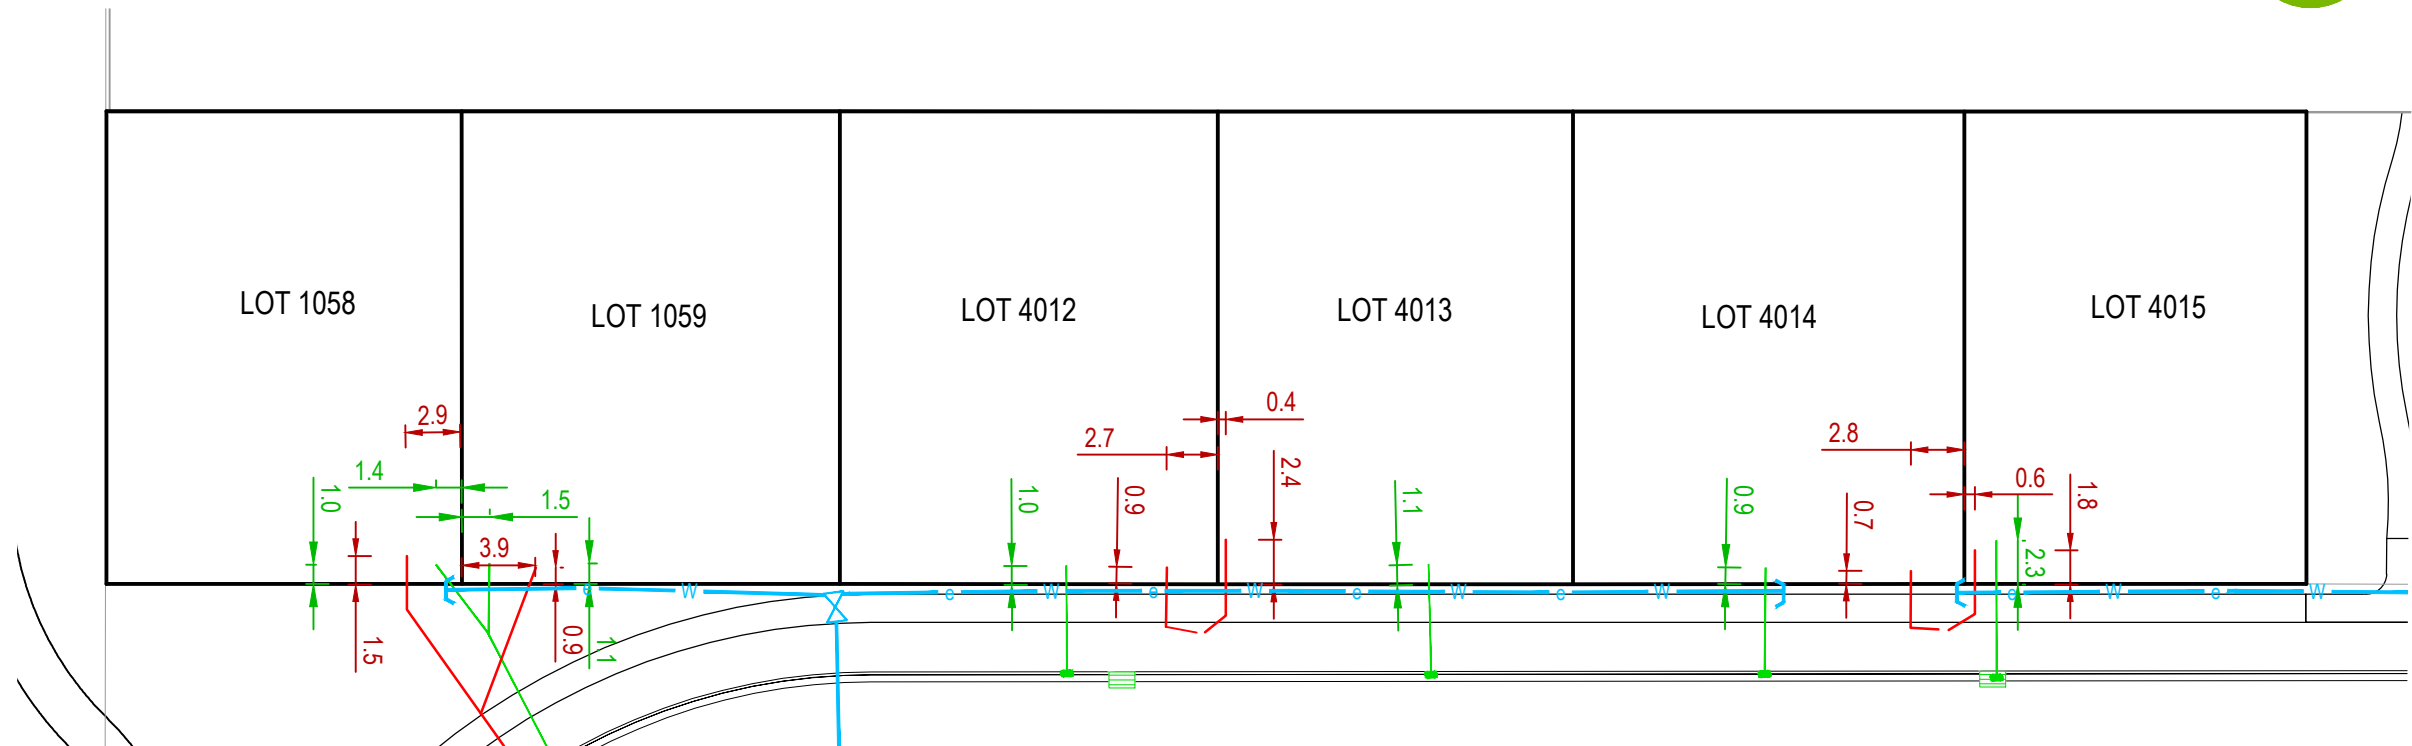


DIAGRAM 1

1:400

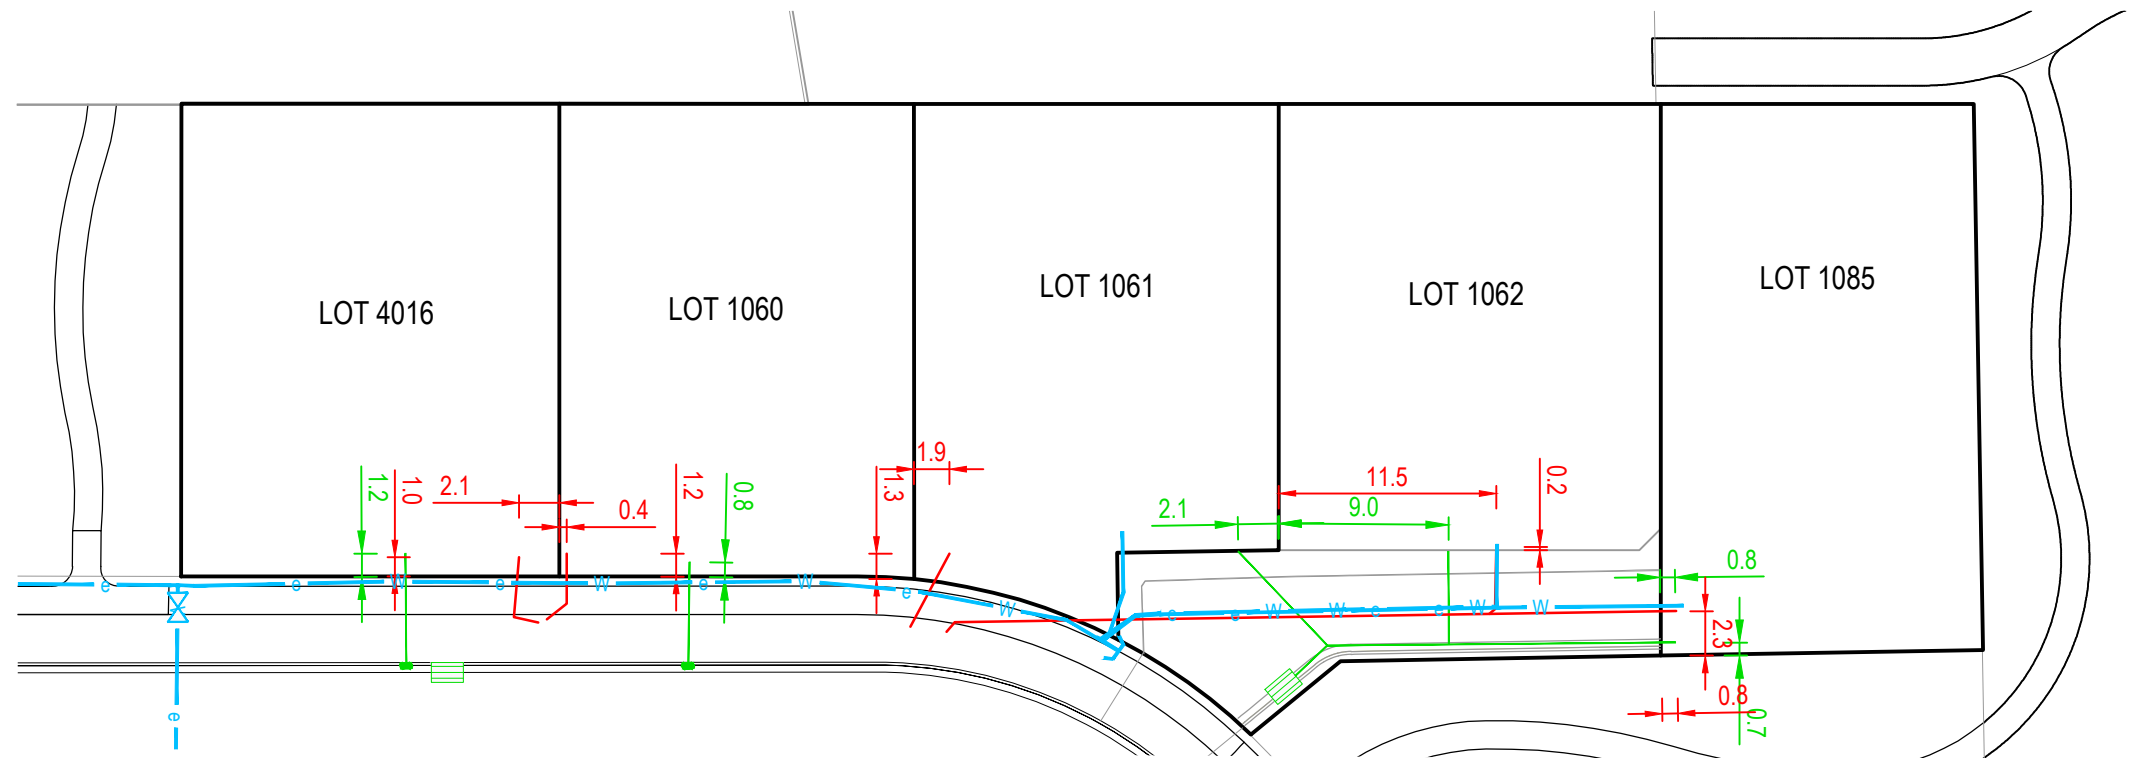


DIAGRAM 2

1:400



CLIENT

REV	DATE	REVISION DETAILS	APPROVED
A	06/12/21	ISSUE FOR INFORMATION	K ASHBY

DRAWN	DESIGNED
R DAWSON	
CHECKED	
APPROVED	
	DATE

PROJECT
PRESTONS PARK
TITLE
LOTS 1058-1062, 1085 & 4012-4016 SUB STAGE 6-B AS BUILT SEWER, STORMWATER AND WATER

FOR INFORMATION
PROJECT No. 235361
SCALE 1:400
DRAWING No. LD-PS-DCB-AB-02
SIZE A3
REV A