


LOCATION PLAN

NOTES:

- THE PROPERTY DATA HAS BEEN SOURCED FROM AURECON (NOVEMBER 2021) AND IS SUBJECT TO FINAL LEGAL REVIEW BY LAND INFORMATION NEW ZEALAND (LINZ).

LEGEND

	STORMWATER TO STREET
	SEWER LATERAL TO MAINS
	WATER SUBMAIN

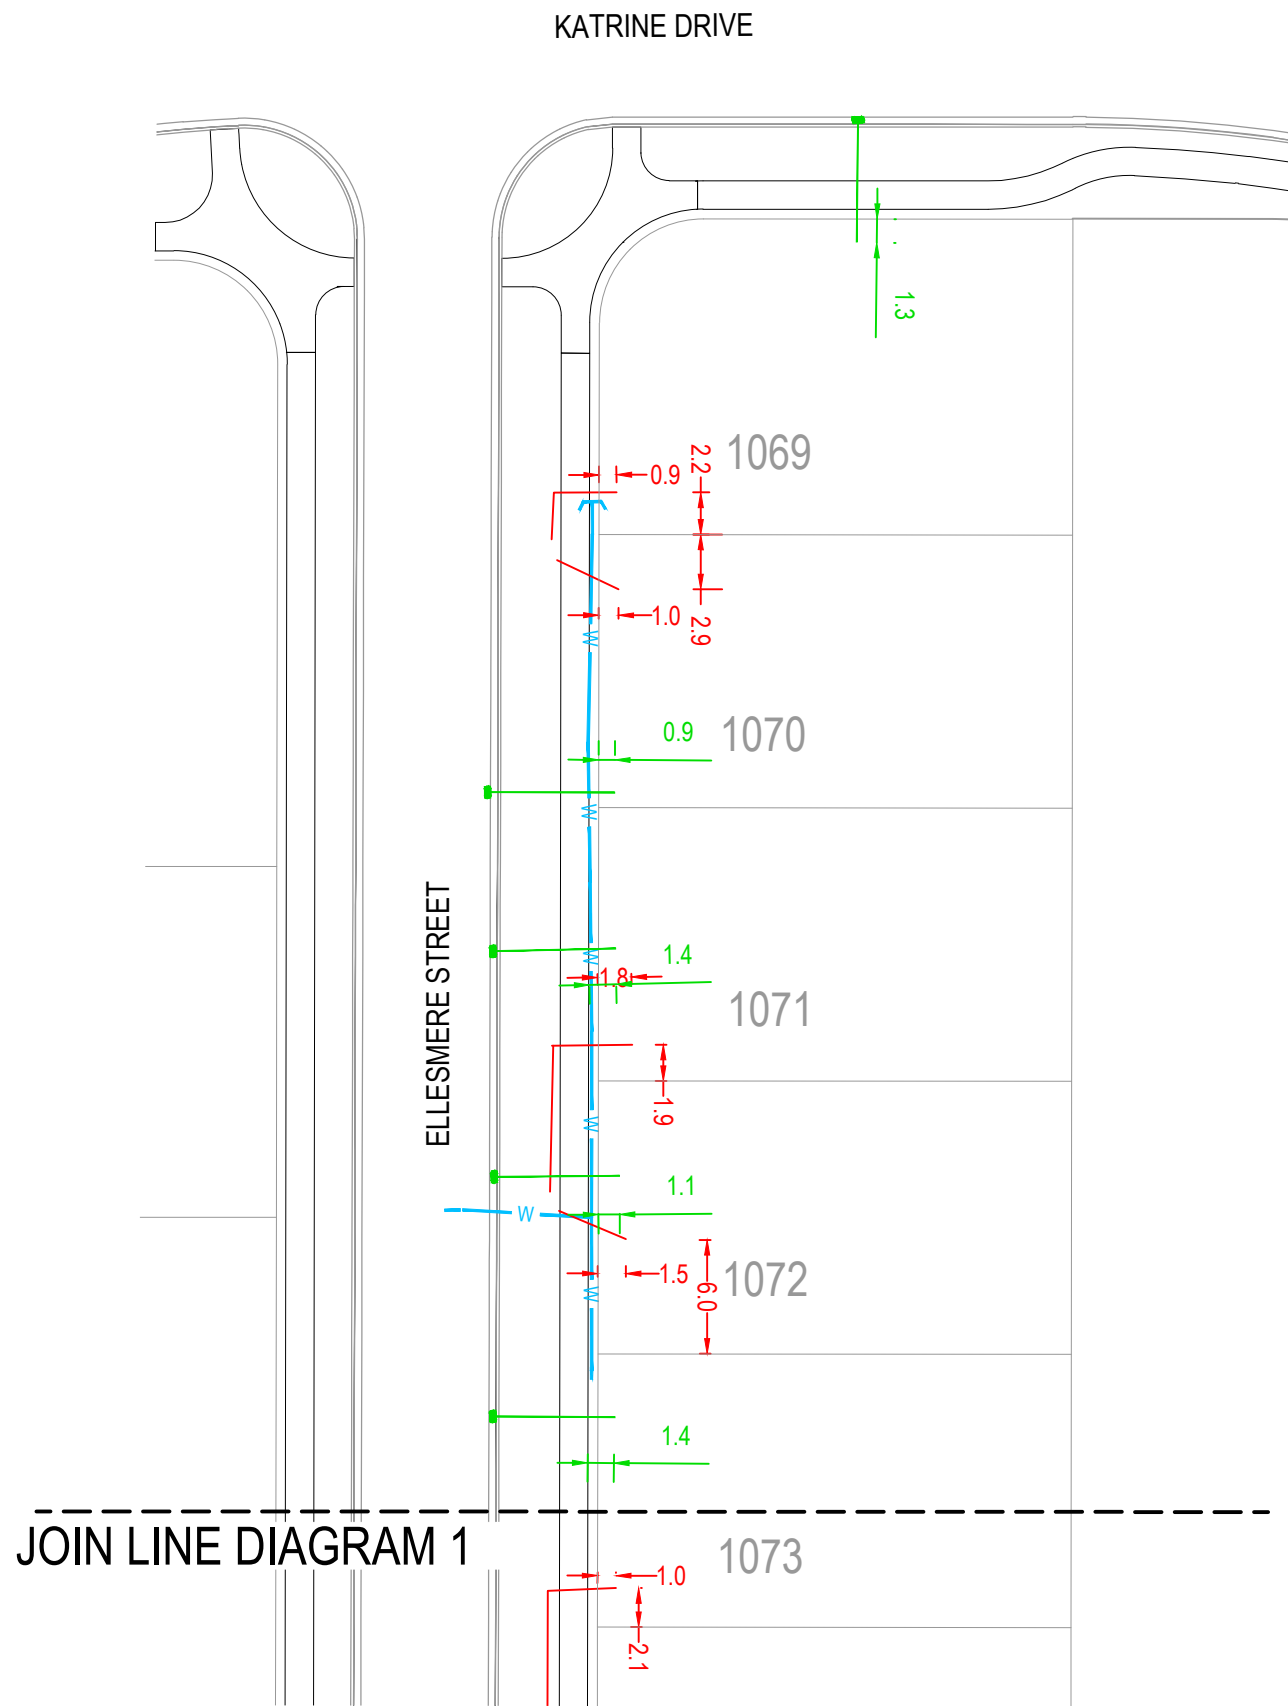

JOIN LINE DIAGRAM 1

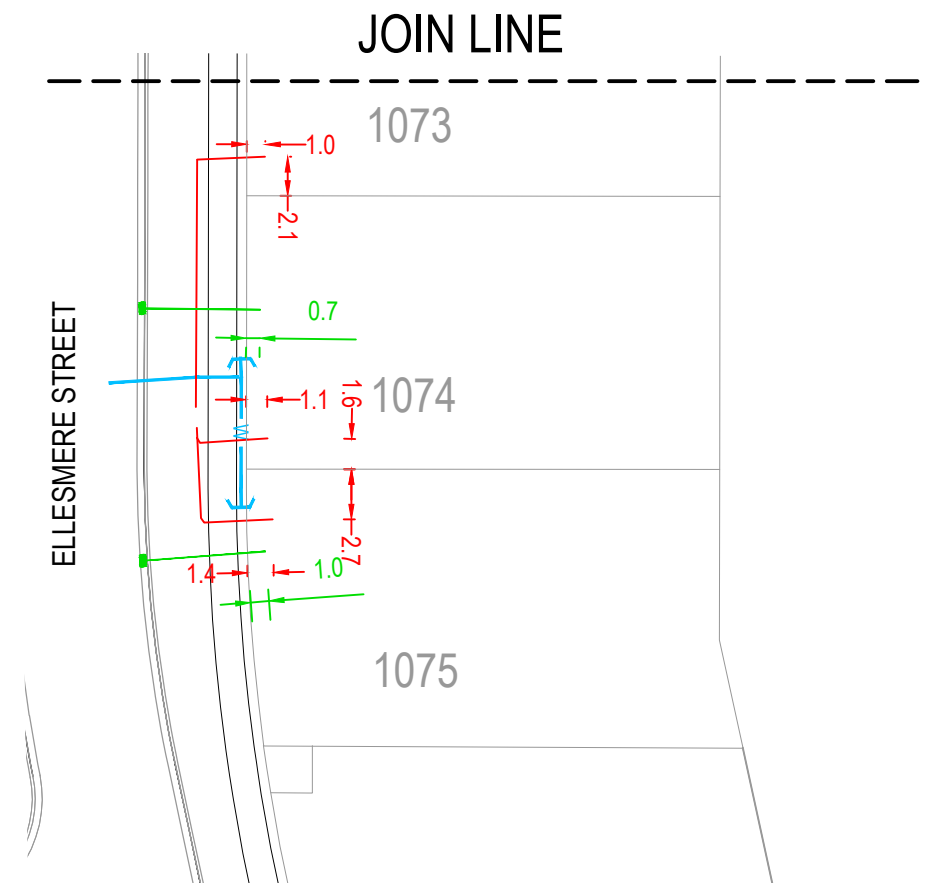


DIAGRAM 1



0000000

REV	DATE	REVISION DETAILS	APPROVED
A	06/12/21	ISSUE FOR INFORMATION	K ASHBY

DRAWN	DESIGNED
R DAWSON	
CHECKED	
APPROVED	
	DATE

PROJECT
PRESTONS PARK
TITLE
SUB STAGE 6-C AS BUILT SEWER, STORMWATER AND WATER

FOR INFORMATION NOT FOR CONSTRUCTION	
PROJECT No.	235361
SCALE	1:400
DRAWING No.	LD-PS-DCC-AB-02
SIZE	A3
REV	A