


LOCATION PLAN

**NOTES:**

- THE PROPERTY DATA HAS BEEN SOURCED FROM AURECON (NOVEMBER 2021) AND IS SUBJECT TO FINAL LEGAL REVIEW BY LAND INFORMATION NEW ZEALAND (LINZ).

**LEGEND**

	STORMWATER TO STREET
	SEWER LATERAL TO MAINS
	WATER SUBMAIN

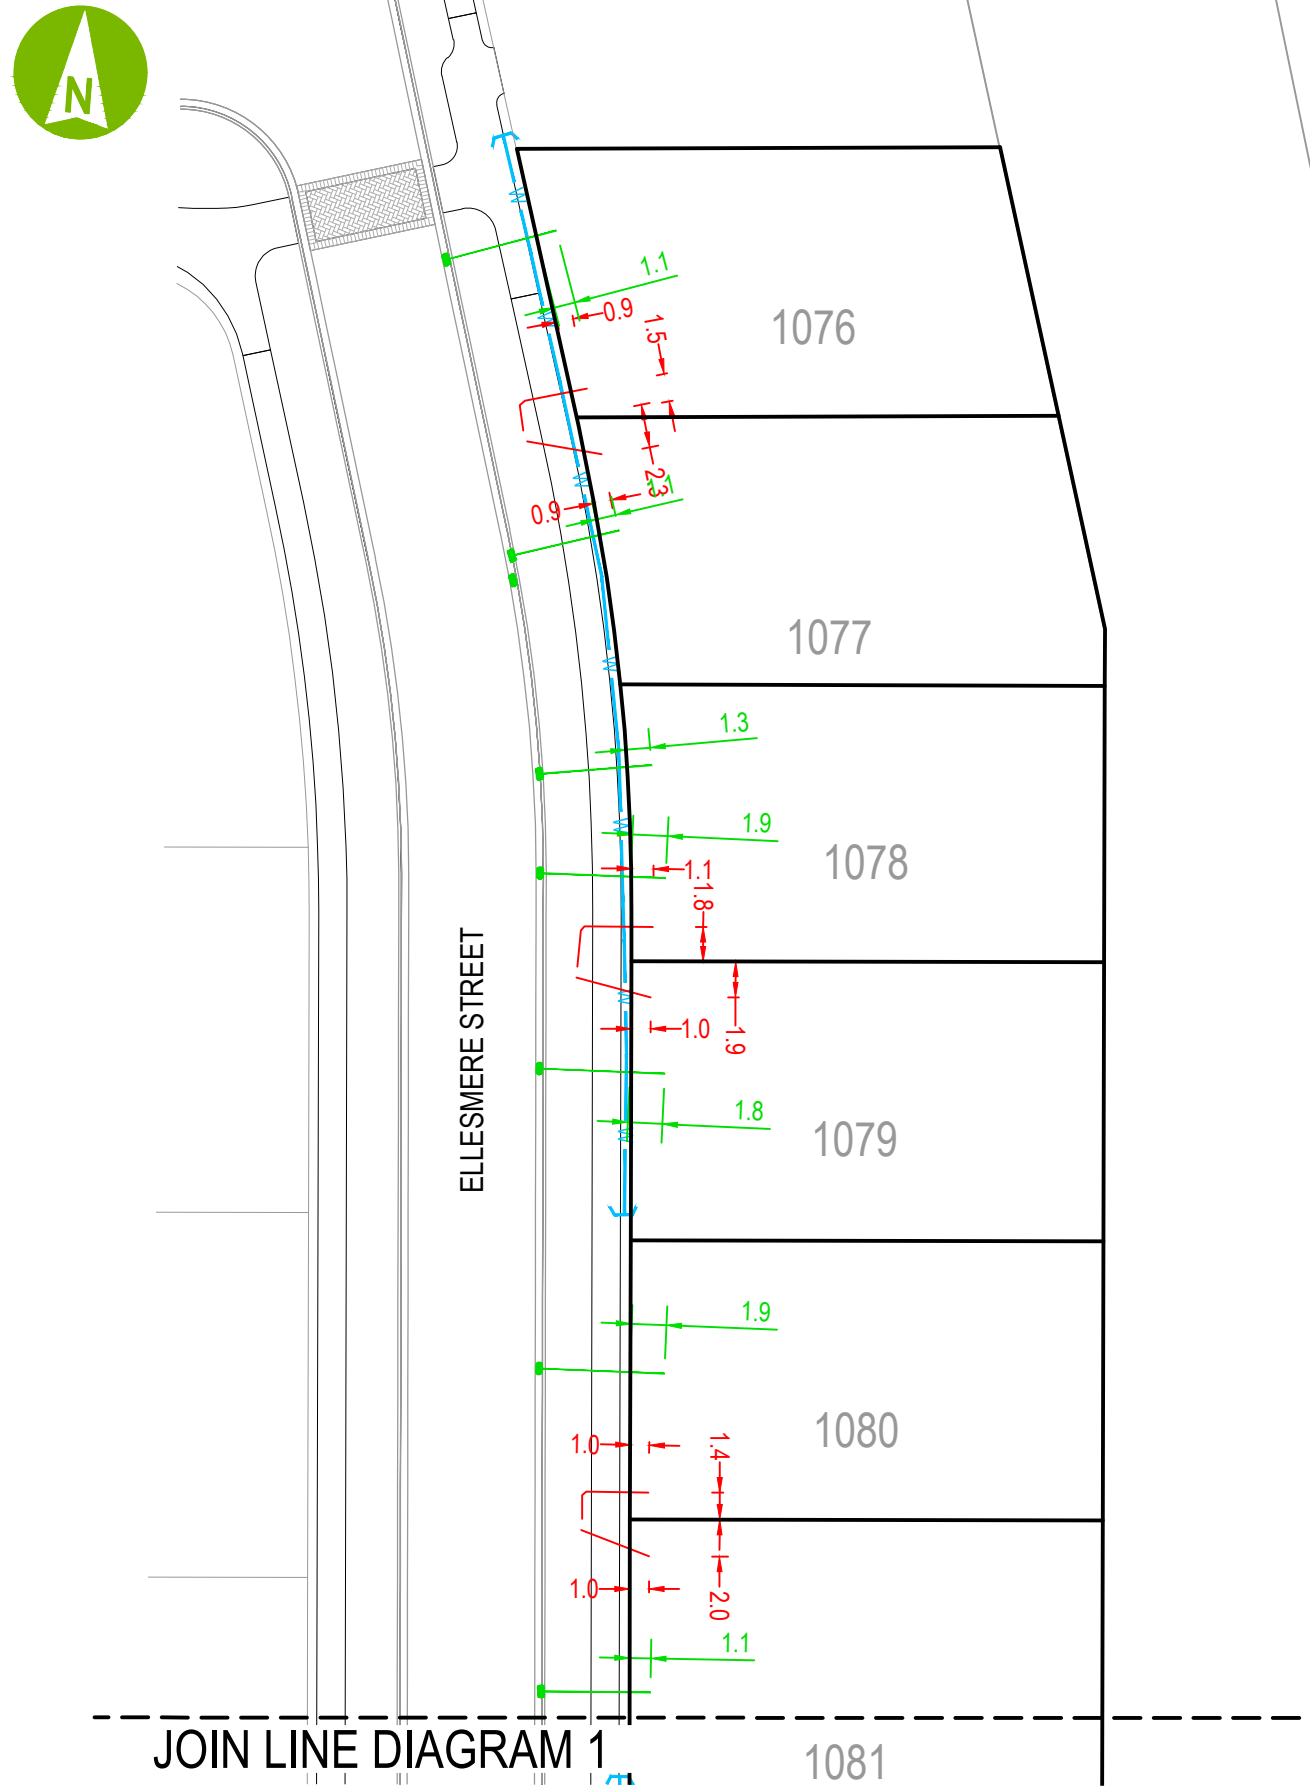

JOIN LINE DIAGRAM 1

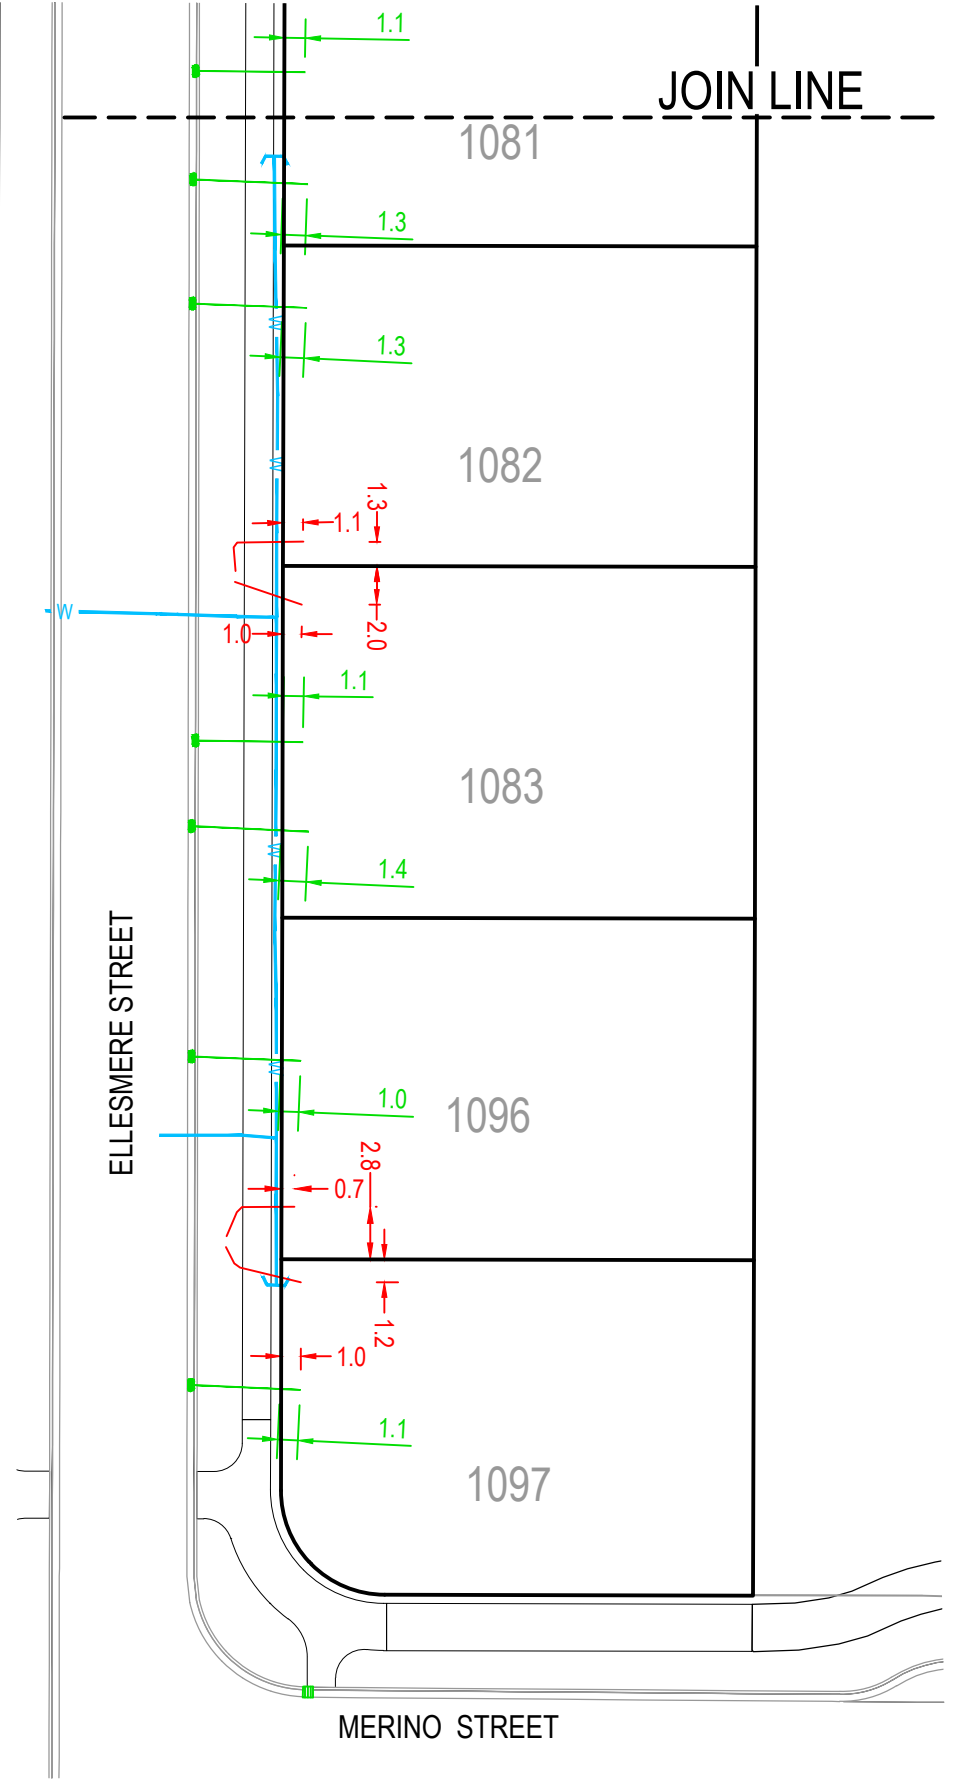


DIAGRAM 1



REV	DATE	REVISION DETAILS	APPROVED
A	06/12/21	ISSUE FOR INFORMATION	K ASHBY

DRAWN	DESIGNED
R DAWSON	
CHECKED	
APPROVED	
	DATE

PROJECT
PRESTONS PARK
TITLE
SUB STAGE 6-D AS BUILT SEWER, STORMWATER AND WATER

FOR INFORMATION NOT FOR CONSTRUCTION	
PROJECT No.	235361
SCALE	1:400
DRAWING No.	LD-PS-DCD-AB-02
SIZE	A3
REV	A