



NOTE

TECHNICAL CATEGORY CLASSIFICATION HAS BEEN ASSESSED IN ACCORDANCE WITH SECTION 3 OF THE MBIE GUIDELINES (2012)

LEGEND

TC1 EQUIVALENT BEHAVIOUR

TC2 EQUIVALENT BEHAVIOUR



NOTES - PROPERTY DATA FROM LINZ


Source: Esri, DigitalGlobe, GeoEye, Earthstar Geographics, CNES/Airbus DS, USDA, USGS, AeroGRID, IGN, and the GIS User Community

REV	DATE	REVISION DETAILS	APPROVED
A	23/03/31	ISSUE FOR INFORMATION	J. Kupec

DRAWN	DESIGNED
R.Dawson	C. Scott
CHECKED	
J. Muirson	
APPROVED	
DATE	
J. Kupec	31/03/2023

PROJECT
PRESTONS PARK - SUBSTAGE G1
TITLE
TECHNICAL CATEGORY PLAN

PROJECT No.
235361
SCALE
AS SHOWN
DRAWING No.
FIG 5
REV
A

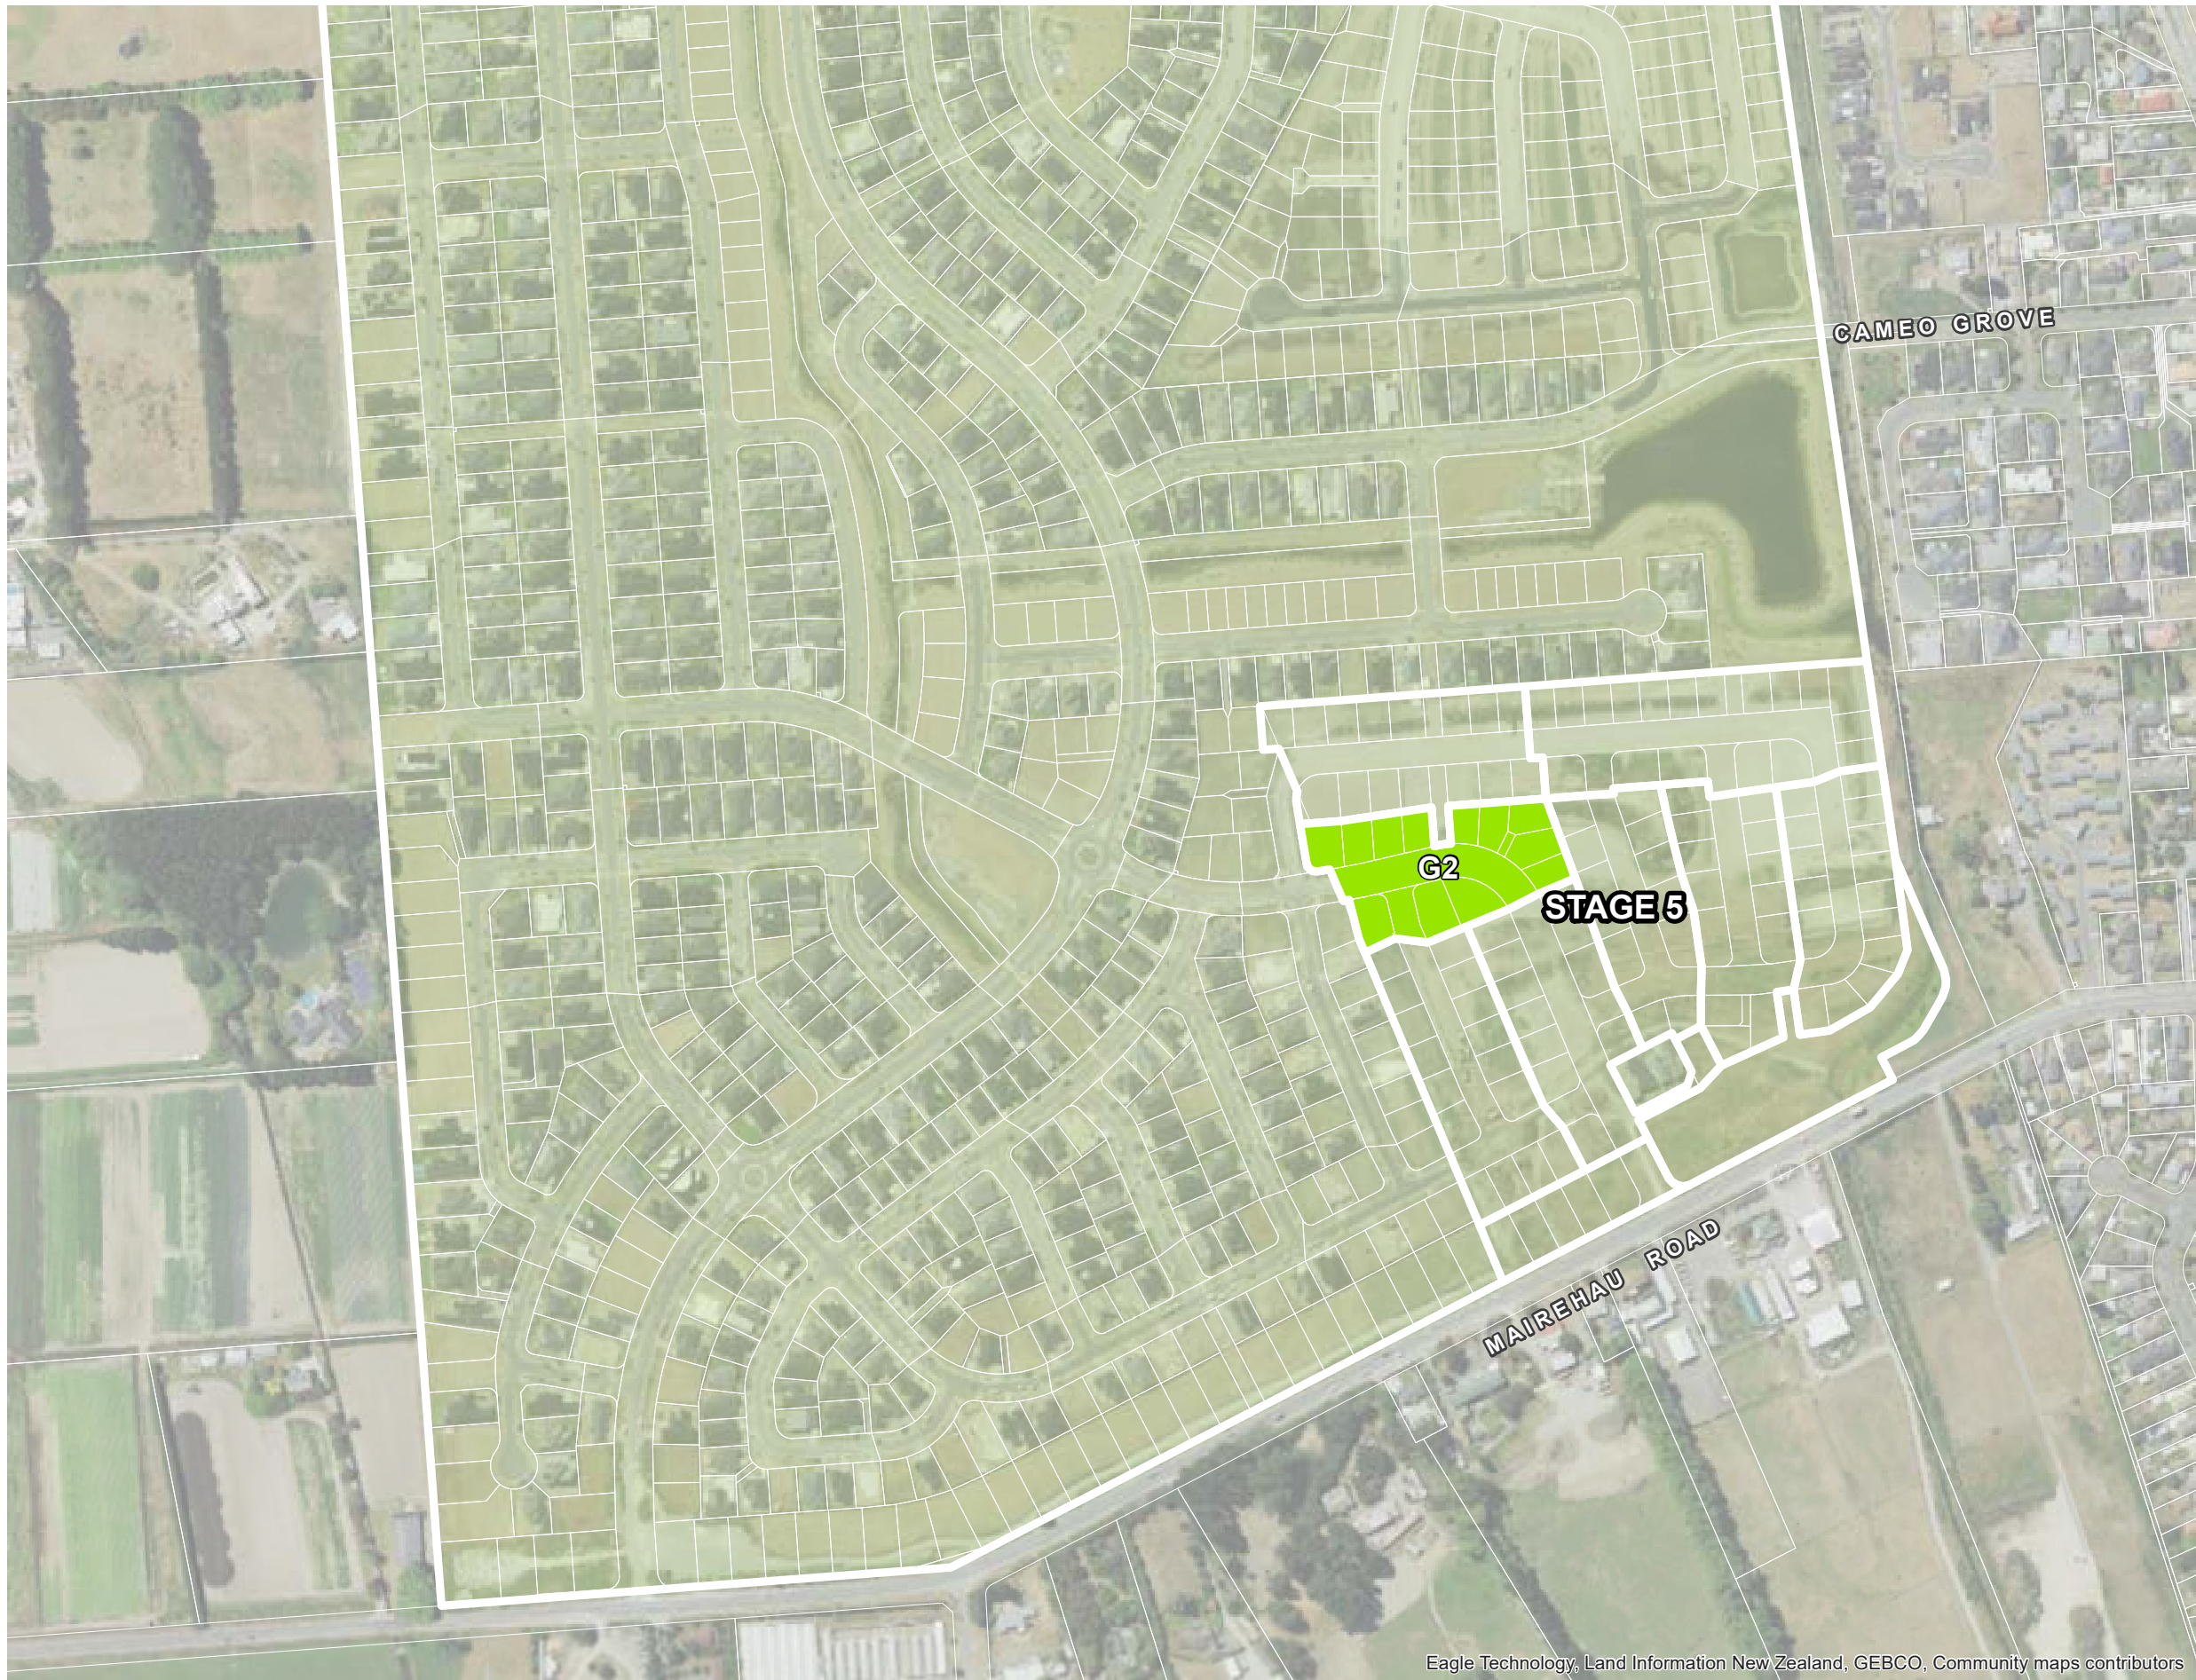

Eagle Technology, Land Information New Zealand, GEBCO, Community maps contributors




0 40 80 120 160 Meters

REV	DATE	REVISION DETAILS	APPROVED
A	23/03/31	ISSUE FOR INFORMATION	J. Kupec

DRAWN	DESIGNED
R.Dawson	T Tremain
CHIEF	
J. Muirson	
APPROVED	DATE
J. Kupec	31/03/2023

PROJECT
PRESTONS PARK SUB-STAGE G2
TITLE
SITE PLAN

PROJECT No.	235361
SCALE	AS SHOWN
DRAWING No.	FIG 1
REV	A

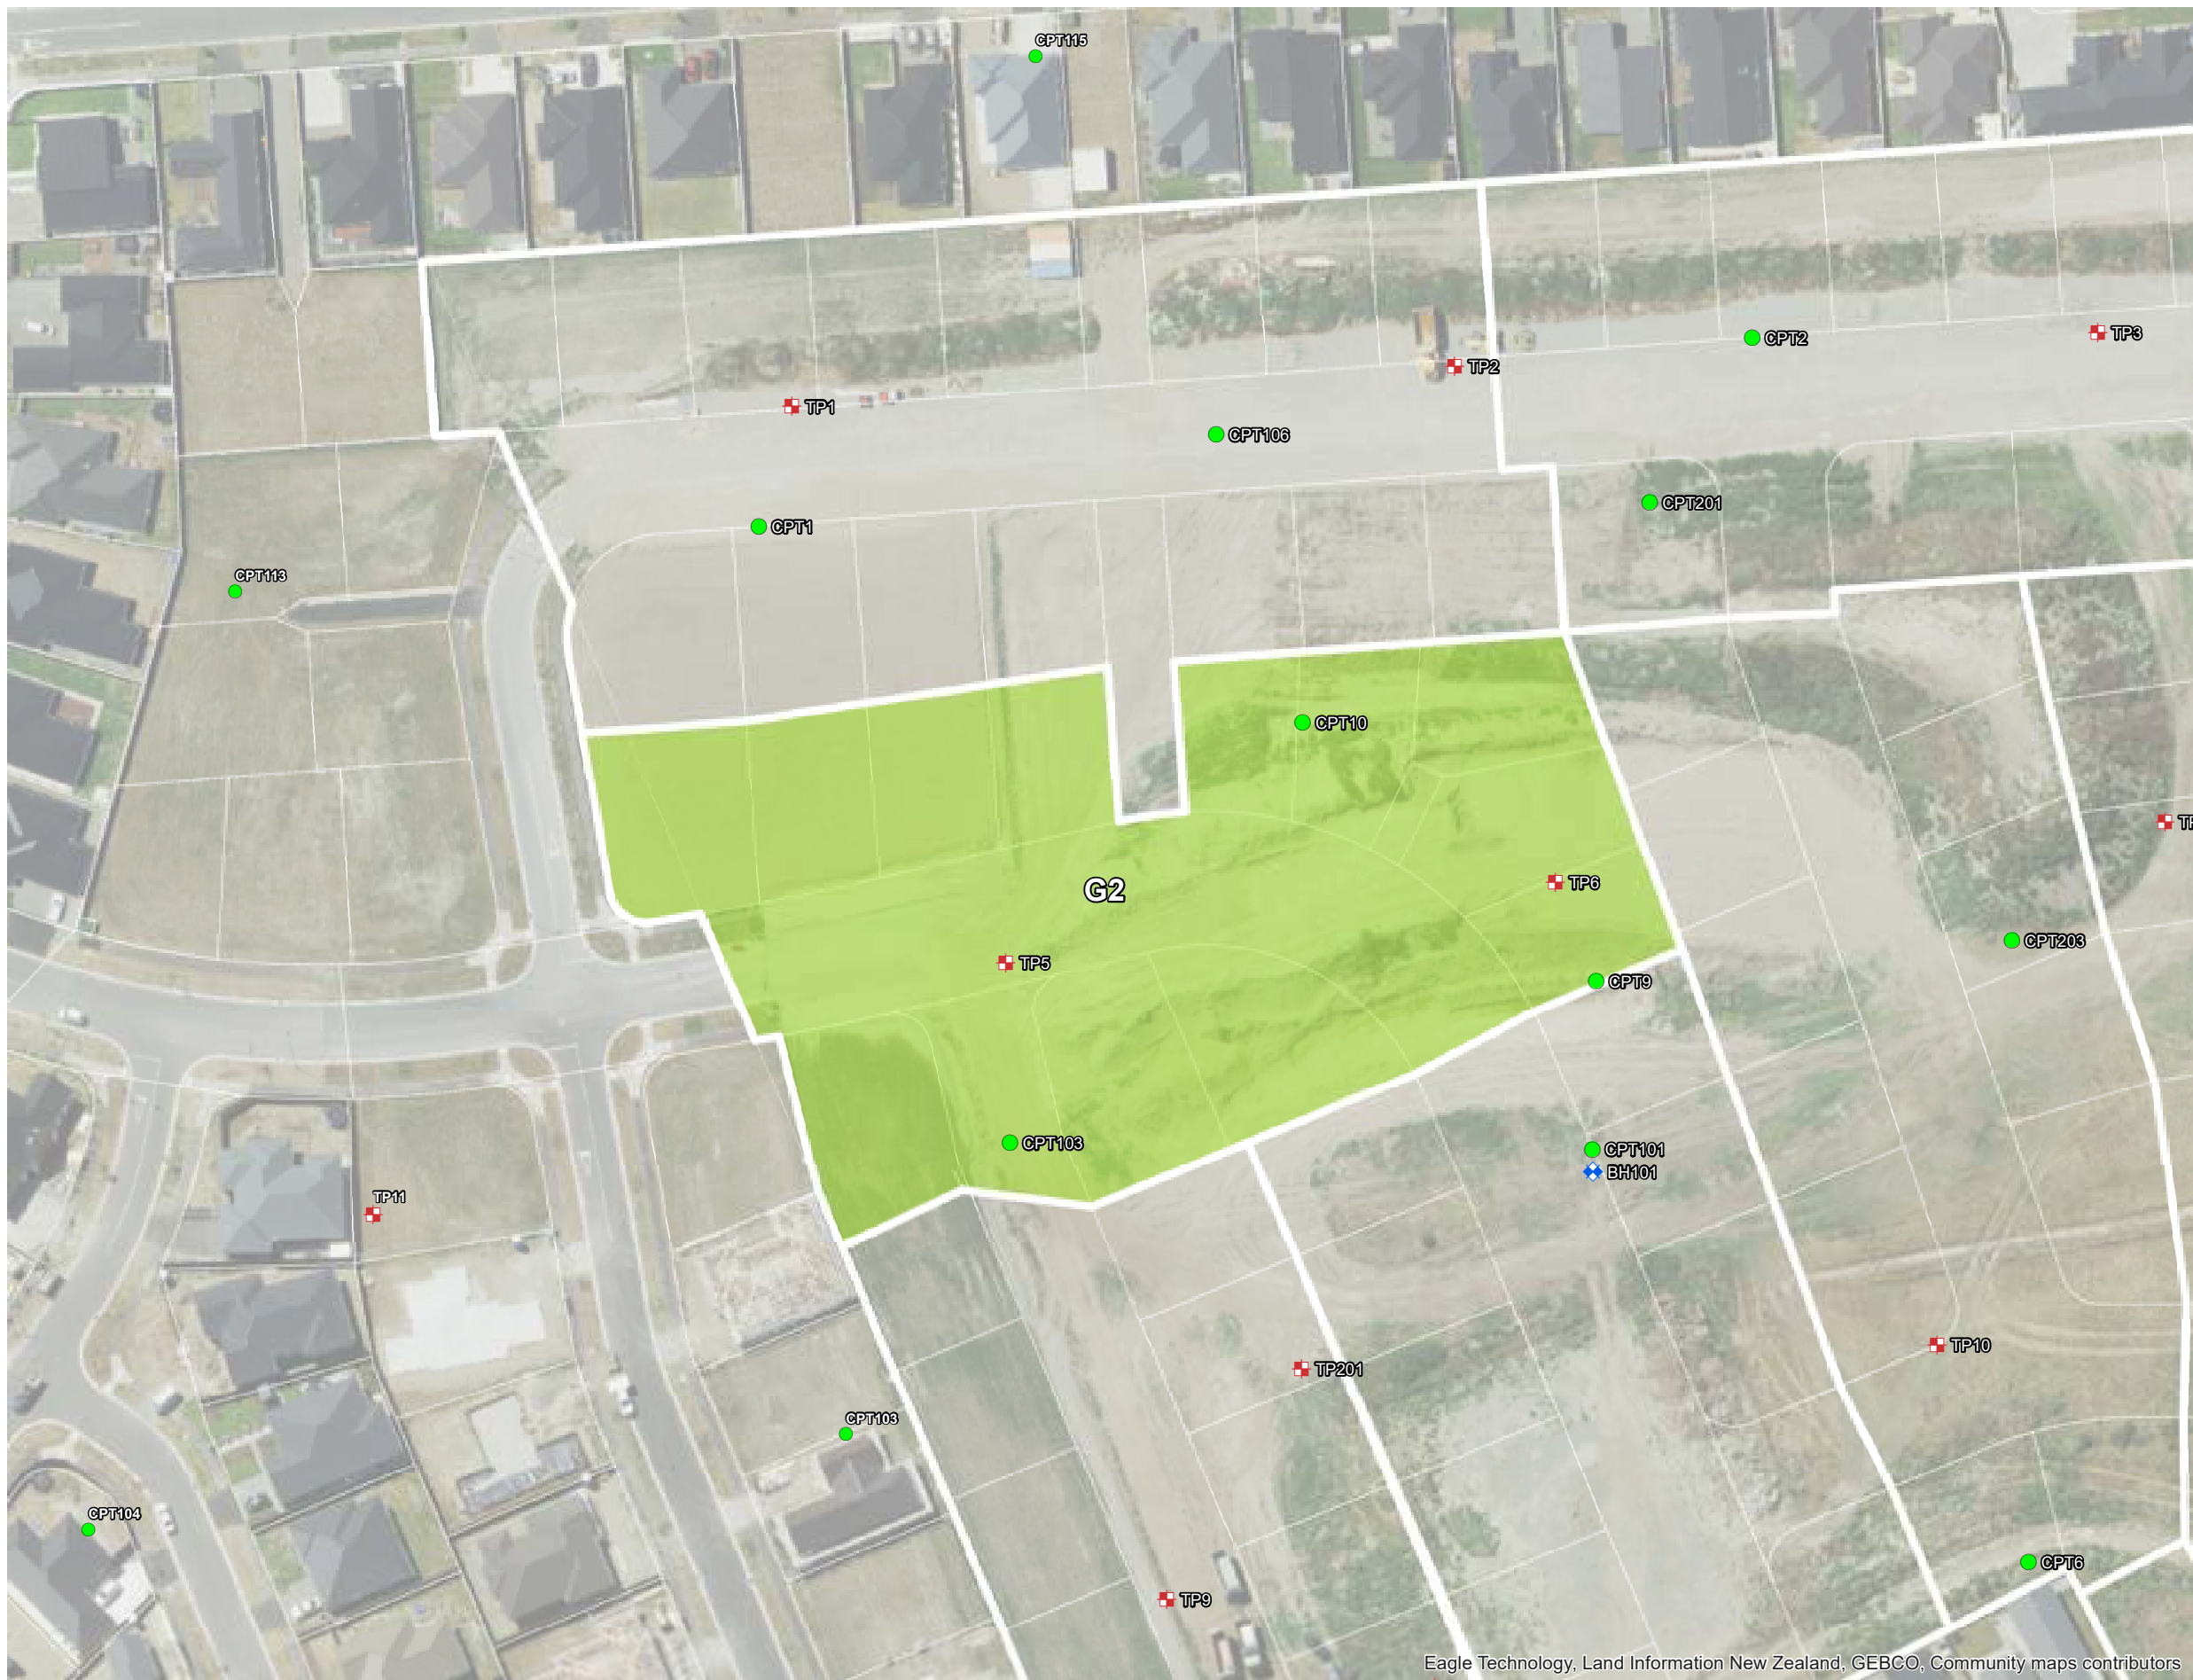

Eagle Technology, Land Information New Zealand, GEBCO, Community maps contributors



0 10 20 30 40 Meters

LEGEND

- ◆ BORE HOLE
- CPT LOCATION
- ✚ TEST PIT LOCATION

REV	DATE	REVISION DETAILS	APPROVED
A	23/03/31	ISSUE FOR INFORMATION	J. Kupec

DRAWN	DESIGNED
R.Dawson	T.Tremain
CHIEF	
J. Muirson	
APPROVED	
	DATE
J. Kupec	31/03/2023

PROJECT
PRESTONS PARK SUB-STAGE G2
TITLE
PREVIOUS INVESTIGATIONS

PROJECT No.	235361
SCALE	AS SHOWN
DRAWING No.	FIG 2
SHEET	A

LEGEND


AS BUILT FILL				
Lower_value	Upper_value		Colour	
-3	to	-2.4	m	
-2.4	to	-1.8	m	
-1.8	to	-1.2	m	
-1.2	to	-0.6	m	
-0.6	to	0	m	
0	to	0.01	m	
0.01	to	0.2	m	
0.2	to	0.4	m	
0.4	to	0.6	m	
0.6	to	0.8	m	
0.8	to	1	m	
1	to	1.2	m	
1.2	to	1.4	m	
1.4	to	1.6	m	
1.6	to	1.8	m	



This AS BUILT drawing has been prepared based on
Information provided by the contractor "KB Contracting".

NOTE:

1. FILL BANDING SHOWN IS BETWEEN EXISTING SUBGRADE (STRIPPED
EXISTING SURFACE) TO FINISHED SUBGRADE.

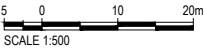

CLIENT

REV	DATE	REVISION DETAILS	APPROVED
A	29/03/23	ISSUED FOR INFORMATION	K ASHBY

DRAWN	DESIGNED
A COLUMBUS	A COLUMBUS
CHECKED	
D WATSON	
APPROVED	
K. ASHBY	
DATE	

PROJECT		PRELIMINARY NOT FOR CONSTRUCTION	
PRESTONS PARK		PROJECT No. 235361	
TITLE		SCALE	SIZE
AS-BUILT EARTHWORKS FILL PLAN SUBSTAGE G1 & G2 STAGE 5		1:500	A1
DRAWING No.		REV	
AB-PS-S5-EW-03		A	