


NOTES:


AS BUILT INFORMATION HAS BEEN SUPPLIED BY KBs CONTRACTING & QUARRIES LTD - DECEMBER 2014.
HEIGHTS ARE IN TERMS OF MEAN SEA LEVEL



RS = ROAD SUMP IN SDC LOW PROFILE KERB AND CHANNEL

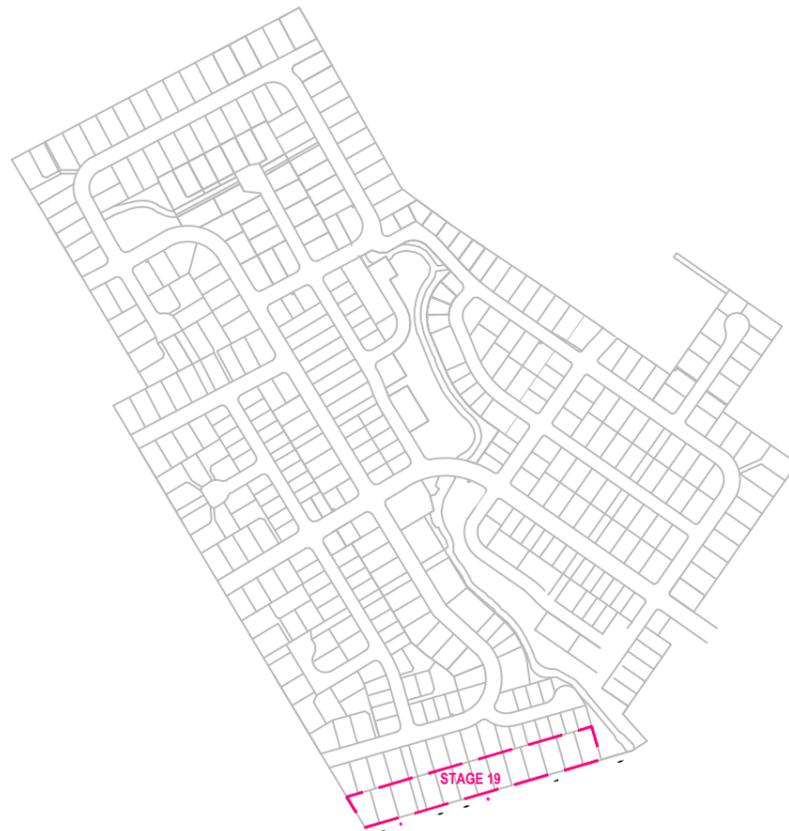

LOCATION PLAN

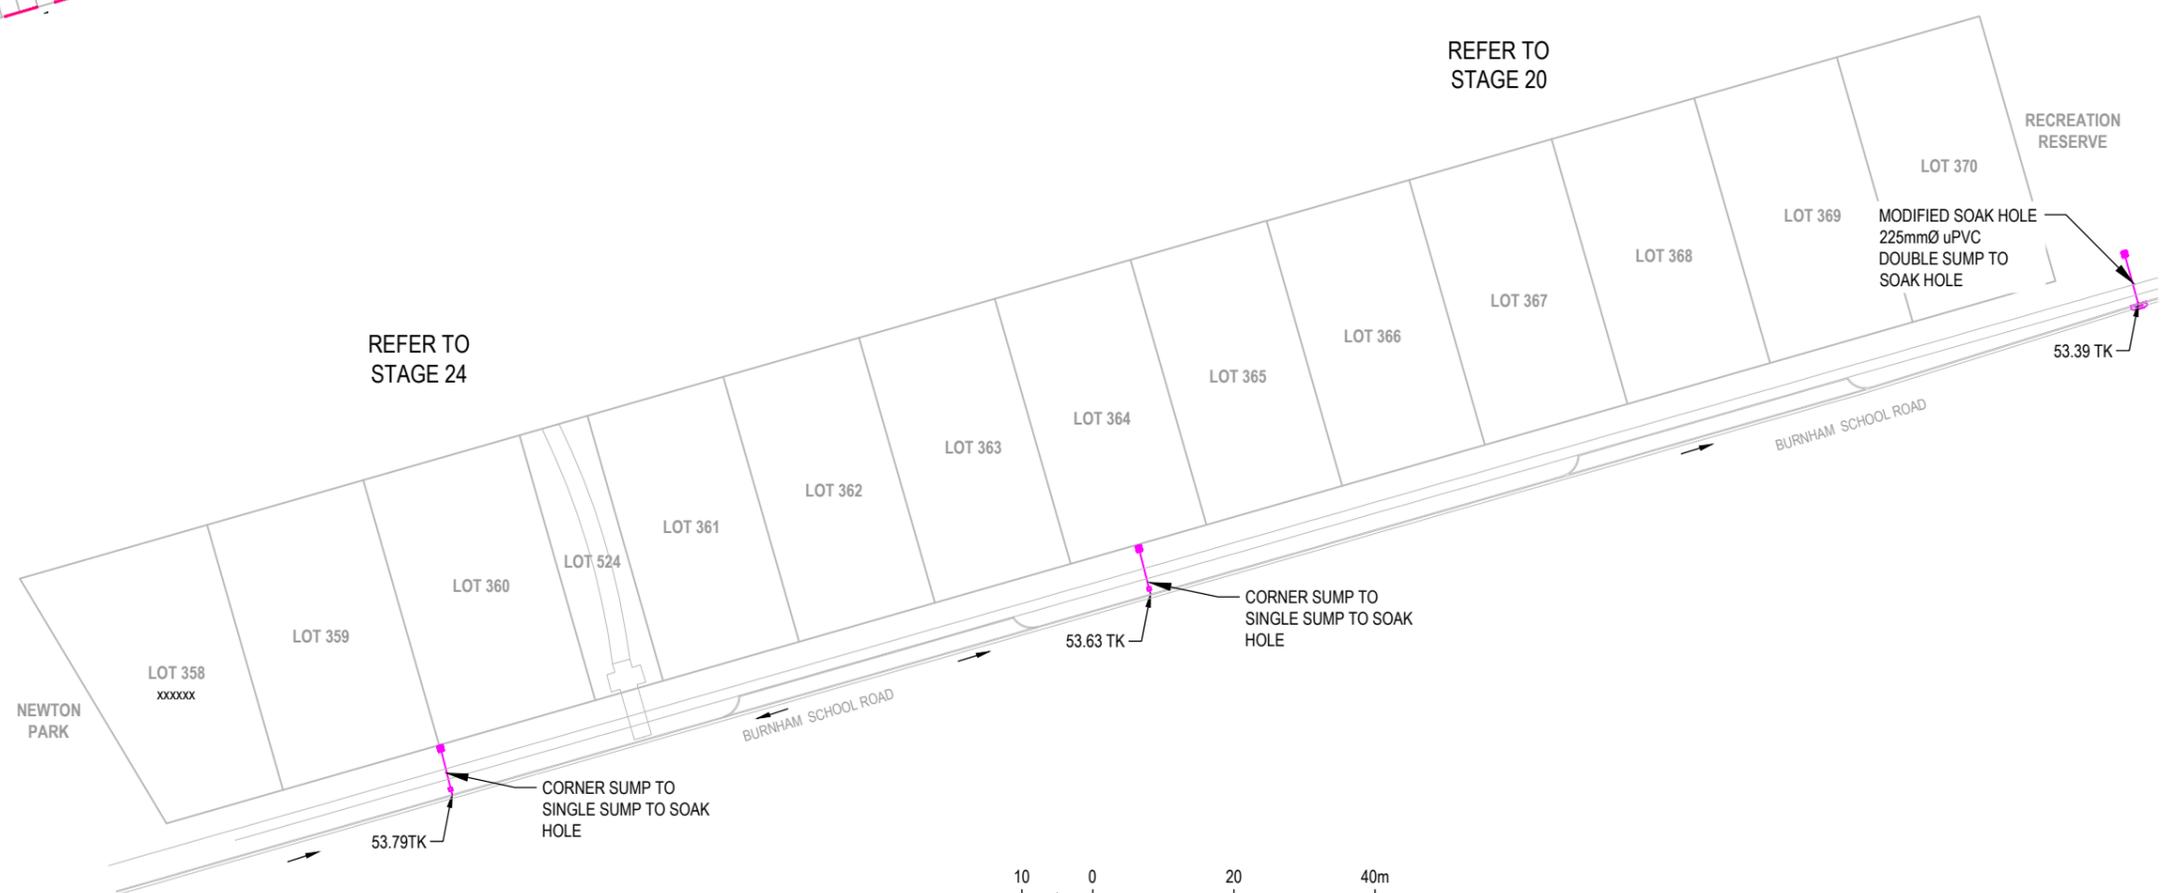

CLIENT		REV	DATE	REVISION DETAILS	APPROVED	DRAWN	DESIGNED	PROJECT	
						A.COLUMBUS	M.CROWE	STONEBROOK ROLLESTON	
						CHECKED		AS BUILT	
						D.WATSON		PROJECT No.	
						APPROVED		224926	
							DATE	SCALE	
								AS SHOWN	
								A3	
								DRAWING No.	
								REV	
								A	
A	05.12.14			AS BUILTS ISSUED	B.TOMS	B.TOMS		TITLE	
								STAGE 19	
								STORMWATER	
								AS BUILT	
								DW-LD-S19-AB-SW-01	