




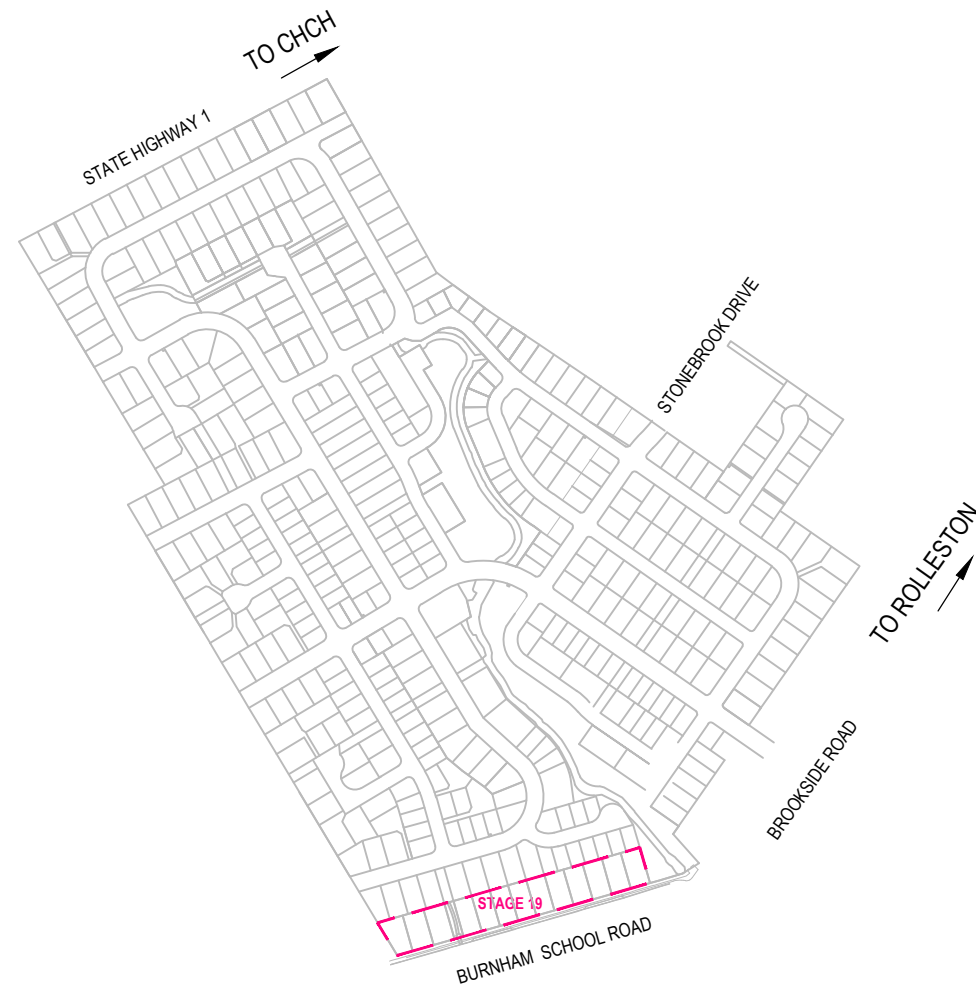

NOTES:
 AS BUILT INFORMATION HAS BEEN SUPPLIED BY KBs
 CONTRACTING & QUARRIES LTD - FEBRUARY 2014.
 HEIGHTS ARE IN TERMS OF MEAN SEA LEVEL
 ALL LATERALS ARE 20mmØ ID POLY

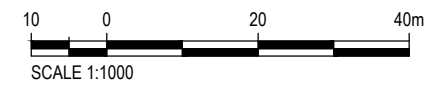

LOCATION PLAN

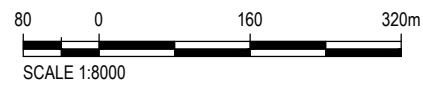

CLIENT		REV	DATE	REVISION DETAILS	APPROVED	DRAWN	DESIGNED	PROJECT	
						A.COLUMBUS	M.CROWE	STONEBROOK ROLLESTON	
						CHECKED		AS BUILT	
						D.WATSON		PROJECT No.	
						APPROVED		224926	
						B.TOMS	DATE	SCALE	
							20.03.15	1:1000	
								SIZE	
								A3	
								DRAWING No.	
								REV	
								DW-LD-S19-AB-W-01	
								A	

000000