



LEGEND

- SUB-STAGE BOUNDARY
- STORMWATER TO STREET
- DOUBLE SUMP
- SINGLE SUMP
- CORNER SUMP
- SEWER LATERAL TO MAINS
- WATER SUBMAIN



CLIENT



REV	DATE	REVISION DETAILS	APPROVED
A		AS BUILT FOR INFORMATION	K ASHBY


PROJECT

PRESTONS PARK

TITLE

AS-BUILT SEWER AND STORMWATER
SUBSTAGE Q5 & R3
STAGE 2

DRAWN	DESIGNED	AS BUILT	
R DAWSON	C DOHERTY		
CHECKED	APPROVED	PROJECT No.	
D ROBINSON		235361	
DATE	SCALE	SIZE	REV
	1:400	A1	
DRAWING No.	REV		
K ASHBY	A	AB-PS-S2-SP-19	

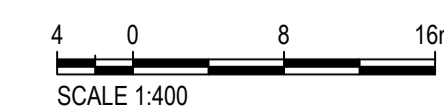

000000