
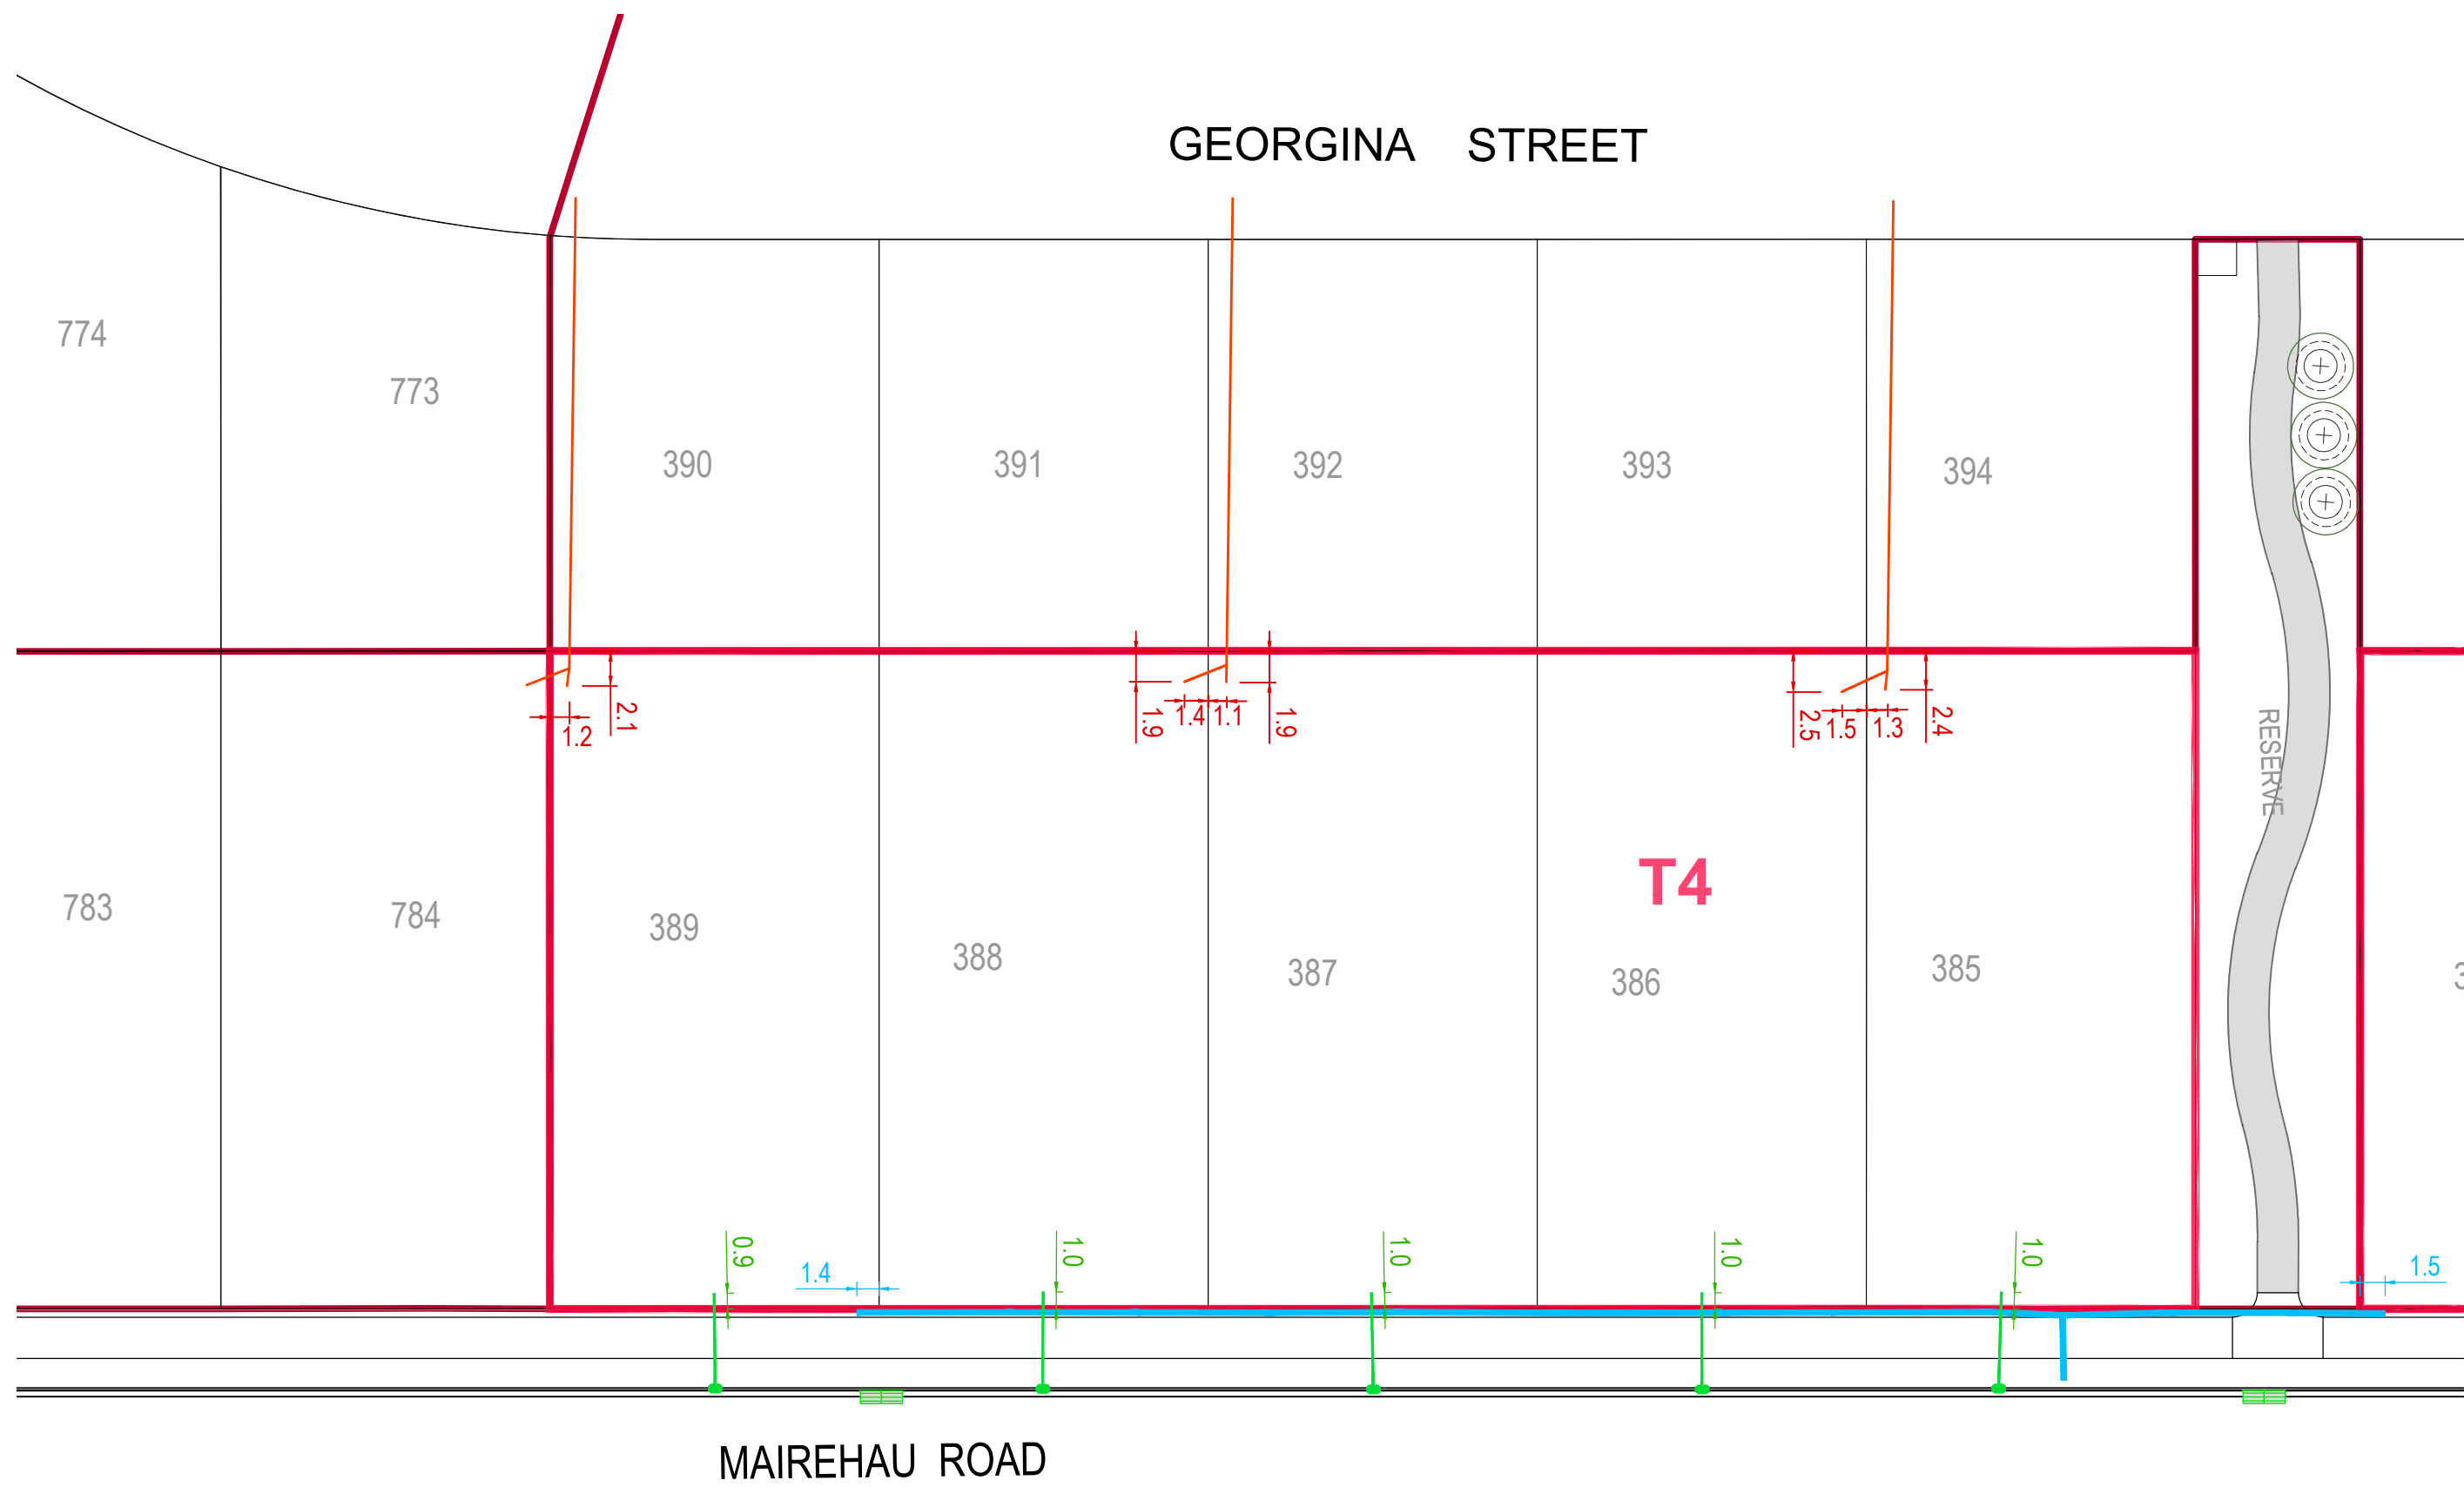


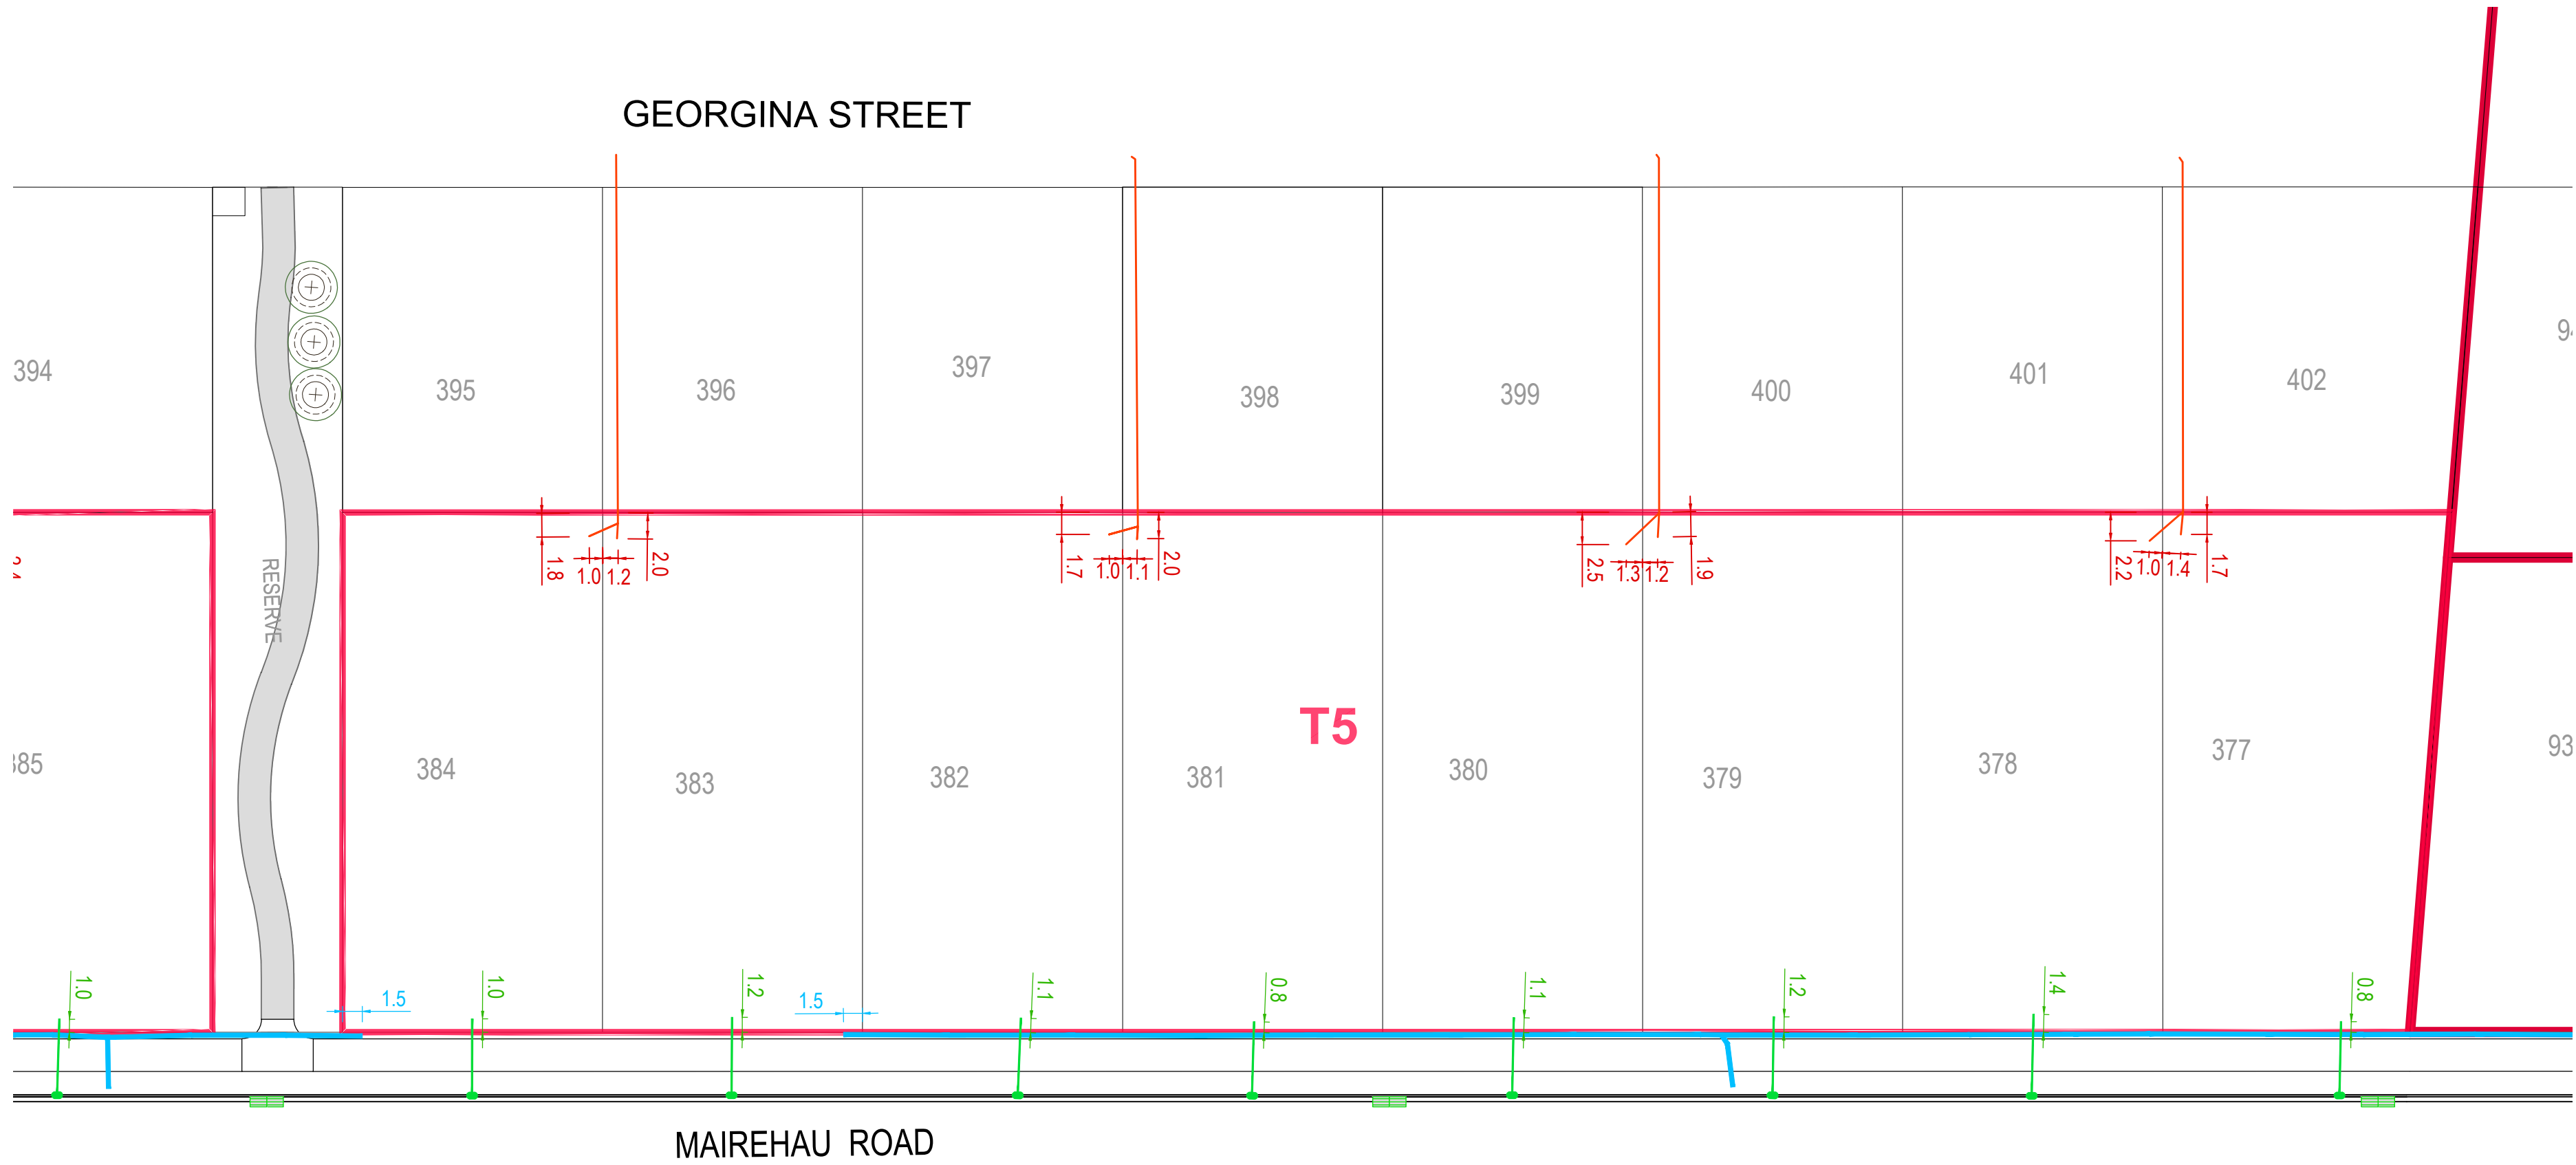

LEGEND

SUB-STAGE BOUNDARY

STORMWATER TO STREET

DOUBLE SUMP


SINGLE SUMP

CORNER SUMP

SEWER LATERAL TO MAINS


WATER SUBMAIN

AS BUILT INFORMATION PROVIDED BY
KB CONTRACTING LTD IN JANUARY 2022

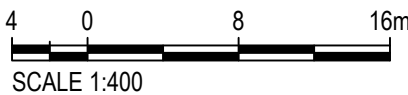

aurecon
www.aurecongroup.com

CLIENT

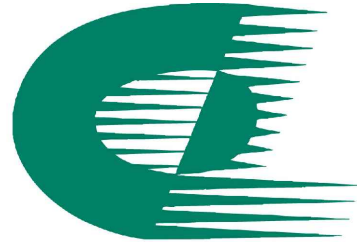

REV	DATE	REVISION DETAILS	APPROVED
A	30/10/24	ISSUE FOR INFORMATION	K ASHBY

PROJECT

PRESTONS PARK

TITLE

AS-BUILT SEWER AND STORMWATER
SUBSTAGE T4 &T5
STAGE 2

DRAWN	DESIGNED	INFORMATION	
T MANNING	C DOHERTY	PROJECT No.	SIZE
CHECKED A COLUMBUS		235361	A1
APPROVED		SCALE	REV
DATE		1:400	A
K ASHBY		DRAWING No.	AB-PS-S2-SP-22