


NOTES:
 AS BUILT INFORMATION HAS BEEN SUPPLIED BY KBs
 CONTRACTING & QUARRIES LTD - AUGUST 2014.
 HEIGHTS ARE IN TERMS OF MEAN SEA LEVEL

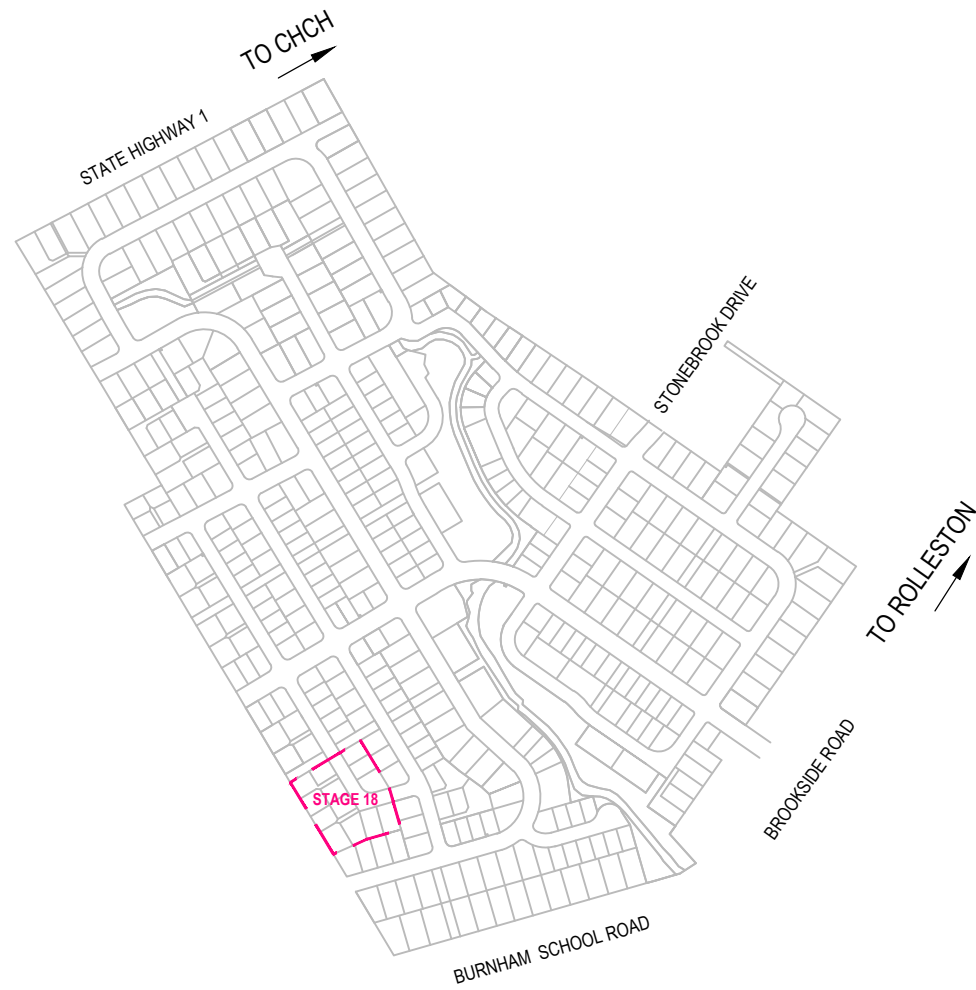



LOCATION PLAN



KEY

- FILL OVER 0.3m
- CUT
- ZERO
- FILL

NOTE:
 1. CONTOUR INTERVALS ARE 0.1m

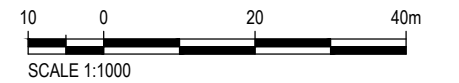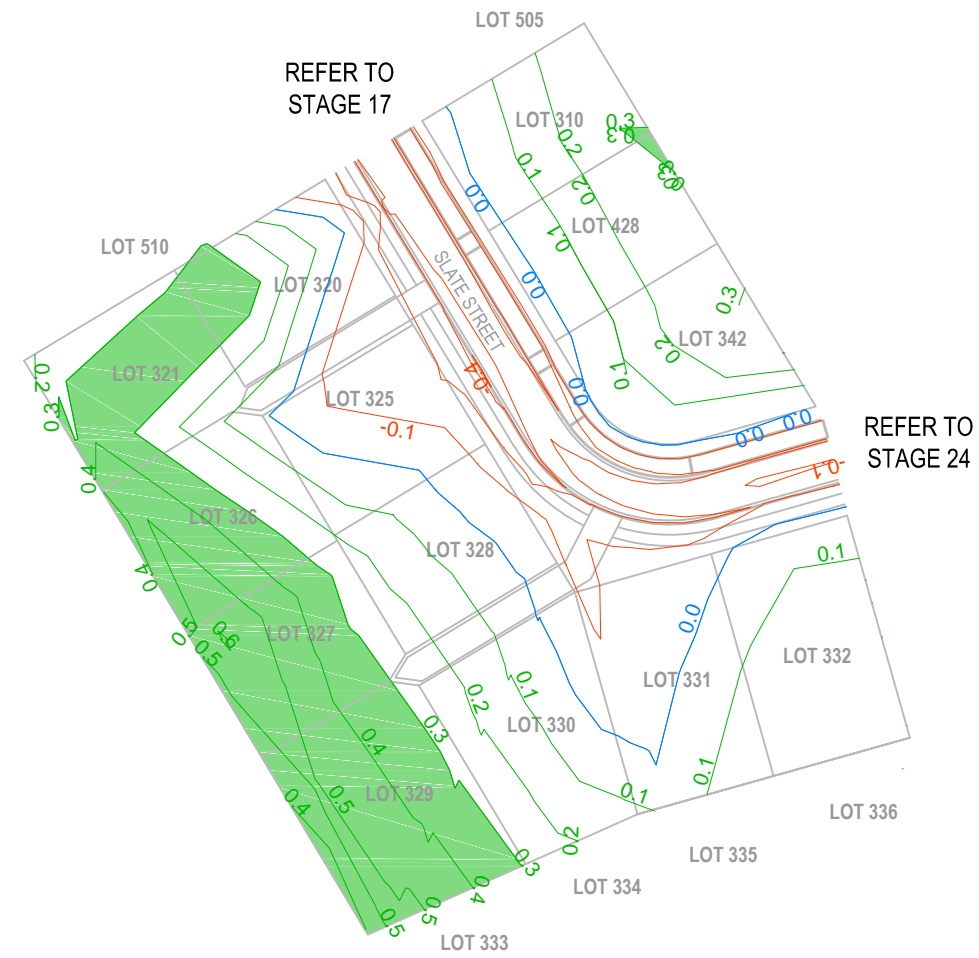

000000



CLIENT		REV	DATE	REVISION DETAILS	APPROVED	DRAWN	DESIGNED	PROJECT		AS BUILT
						A.COLUMBUS	M.CROWE	STONEBROOK ROLLESTON		PROJECT No.
						CHECKED				224926
						D.WATSON		TITLE		SCALE
						APPROVED		STAGE 18 CUT AND FILL AS BUILT		AS SHOWN
						B.TOMS	DATE 25.09.15			A3
						B.TOMS				DRAWING No.
										REV
A	25.09.15			AS BUILTS ISSUED	B.TOMS					DW-LD-S18-AB-CF-01
										A