

LOCATION PLAN




KEY

- FILL OVER 0.3m
- CUT
- ZERO
- FILL

NOTE:
1. CONTOUR INTERVALS ARE 0.1m



NOTES:
AS BUILT INFORMATION HAS BEEN SUPPLIED BY KBs CONTRACTING & QUARRIES LTD - SEPTEMBER 2015.
HEIGHTS ARE IN TERMS OF MEAN SEA LEVEL

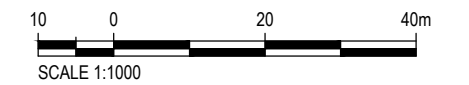

CLIENT		REV	DATE	REVISION DETAILS	APPROVED	DRAWN	DESIGNED	PROJECT		AS BUILT	
						A.COLUMBUS	M.CROWE	STONEBROOK ROLLESTON		PROJECT No. 224926	
						CHECKED D.WATSON		TITLE		SCALE	SIZE
						APPROVED		STAGE 24 CUT AND FILL AS BUILT		AS SHOWN	A3
						B.TOMS	DATE 25.09.15			DRAWING No.	REV
						B.TOMS				DW-LD-S24-AB-CF-01	A
		A	25.09.15	AS BUILTS ISSUED	B.TOMS	B.TOMS					