



AS BUILT INFORMATION HAS BEEN SUPPLIED BY KBs
CONTRACTING & QUARRIES LTD - FEBRUARY 2015.
HEIGHTS ARE IN TERMS OF MEAN SEA LEVEL
ALL LATERALS ARE 100mmØ uPVC SN16

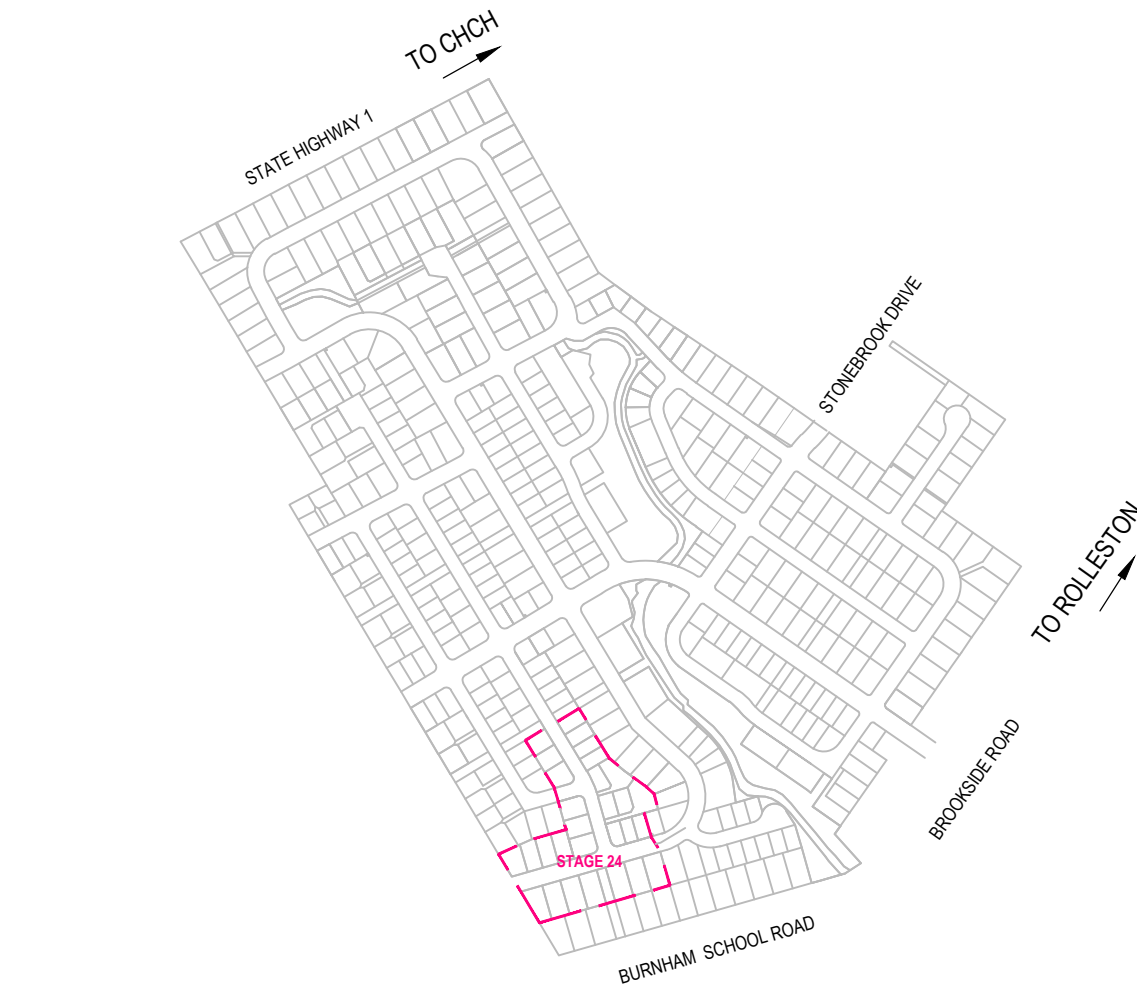

LOCATION PLAN

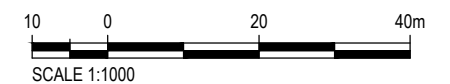

CLIENT	REV	DATE	REVISION DETAILS	APPROVED	DRAWN A.COLUMBUS	DESIGNED M.CROWE	PROJECT		AS BUILT	
					CHECKED D.WATSON		STONEBROOK ROLLESTON		PROJECT No. 224926	
					APPROVED		TITLE		SCALE AS SHOWN	SIZE A3
					DATE 26.09.15		STAGE 24 SEWER AS BUILT		DRAWING No. DW-LD-S24-AB-SS-01	REV A
					B.TOMS					
	A	25.09.15	AS BUILTS ISSUED	B.TOMS						