



NOTES:

AS BUILT INFORMATION HAS BEEN SUPPLIED BY KBs CONTRACTING & QUARRIES LTD - SEPTEMBER 2015.
HEIGHTS ARE IN TERMS OF MEAN SEA LEVEL

RS = SINGLE SUMP IN SDC LOW PROFILE KERB AND CHANNEL
DS = DOUBLE SUMP IN SDC LOW PROFILE KERB AND CHANNEL

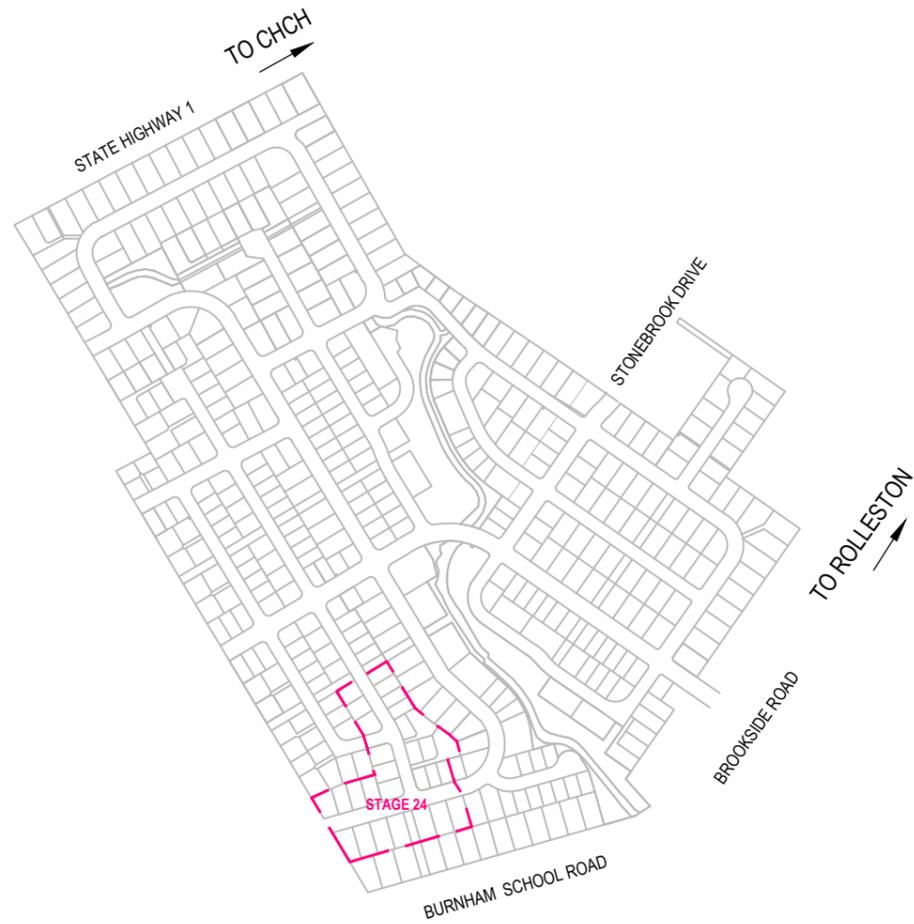

LOCATION PLAN

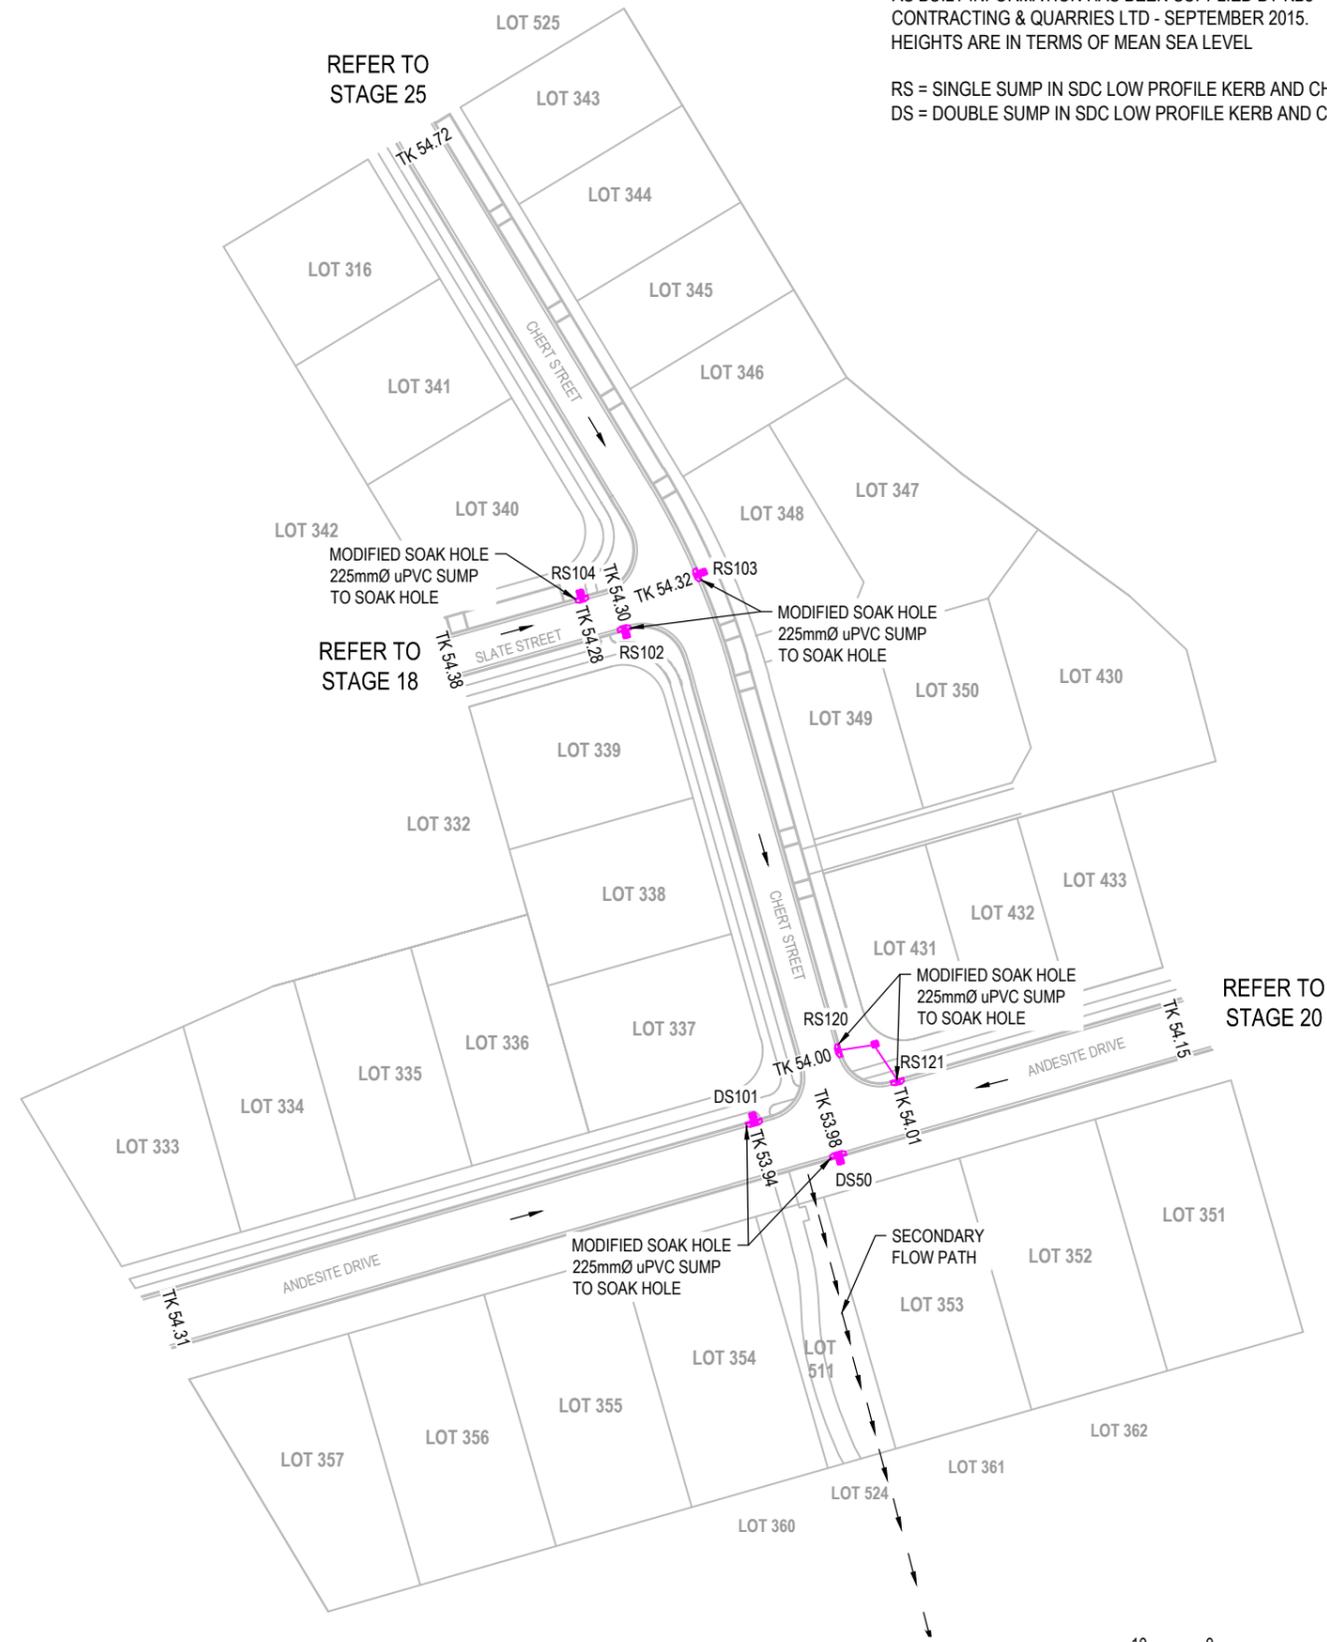

000000



REV	DATE	REVISION DETAILS
A	25.09.15	AS BUILTS ISSUED

APPROVED	DRAWN	DESIGNED
B.TOMS	A.COLUMBUS	M.CROWE
	CHECKED	
	D.WATSON	
	APPROVED	
	B.TOMS	DATE 25.09.15

PROJECT
STONEBROOK ROLLESTON
TITLE
STAGE 24 STORMWATER AS BUILT

AS BUILT
PROJECT No. 224926
SCALE AS SHOWN
DRAWING No. DW-LD-S24-AB-SW-01

AS BUILT	SIZE
PROJECT No. 224926	A3
SCALE AS SHOWN	REV
DRAWING No. DW-LD-S24-AB-SW-01	A