



LOCATION PLAN

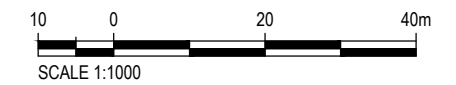

NOTES:
 AS BUILT INFORMATION HAS BEEN SUPPLIED BY KBs
 CONTRACTING & QUARRIES LTD - SEPTEMBER 2015.
 HEIGHTS ARE IN TERMS OF MEAN SEA LEVEL
 ALL LATERALS ARE 20mmØ ID POLY

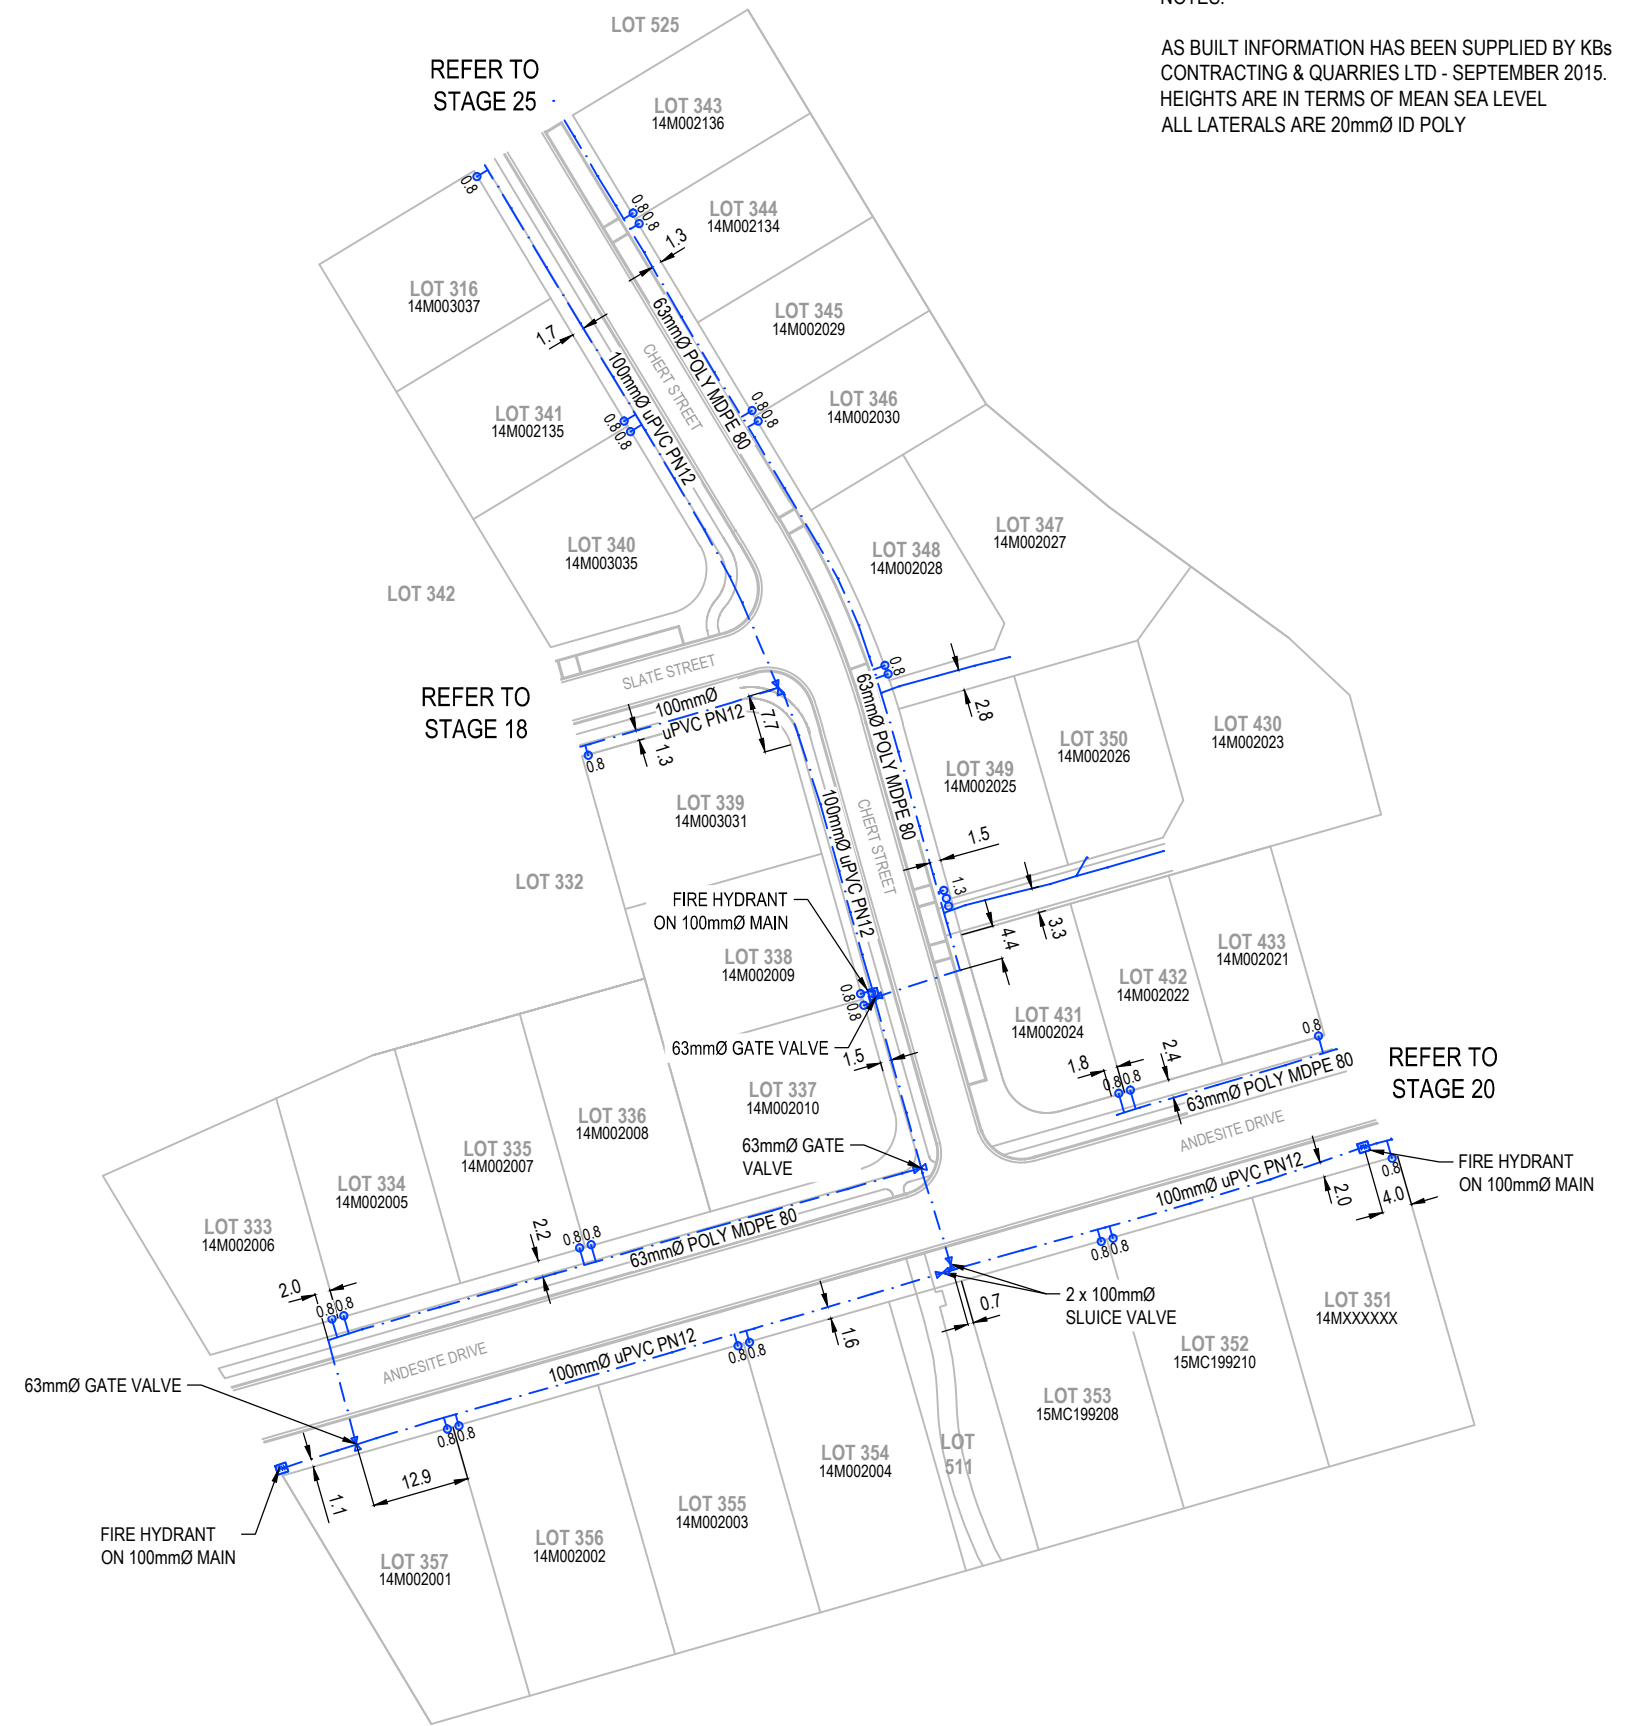

CLIENT		REV	DATE	REVISION DETAILS	APPROVED	DRAWN	DESIGNED	PROJECT		AS BUILT	
						A.COLUMBUS	M.CROWE	STONEBROOK ROLLESTON		PROJECT No. 224926	
						CHECKED D.WATSON		TITLE		SCALE AS SHOWN A3	
						APPROVED		STAGE 24 WATER AS BUILT		DRAWING No. DW-LD-S24-AB-W-01	
						B.TOMS	DATE 25.09.15			SIZE A	
		A	25.09.15	AS BUILTS ISSUED	B.TOMS	B.TOMS				REV A	