



NOTES:  
 AS BUILT INFORMATION HAS BEEN SUPPLIED BY KBs  
 CONTRACTING & QUARRIES LTD - SEPTEMBER 2015.  
 HEIGHTS ARE IN TERMS OF MEAN SEA LEVEL

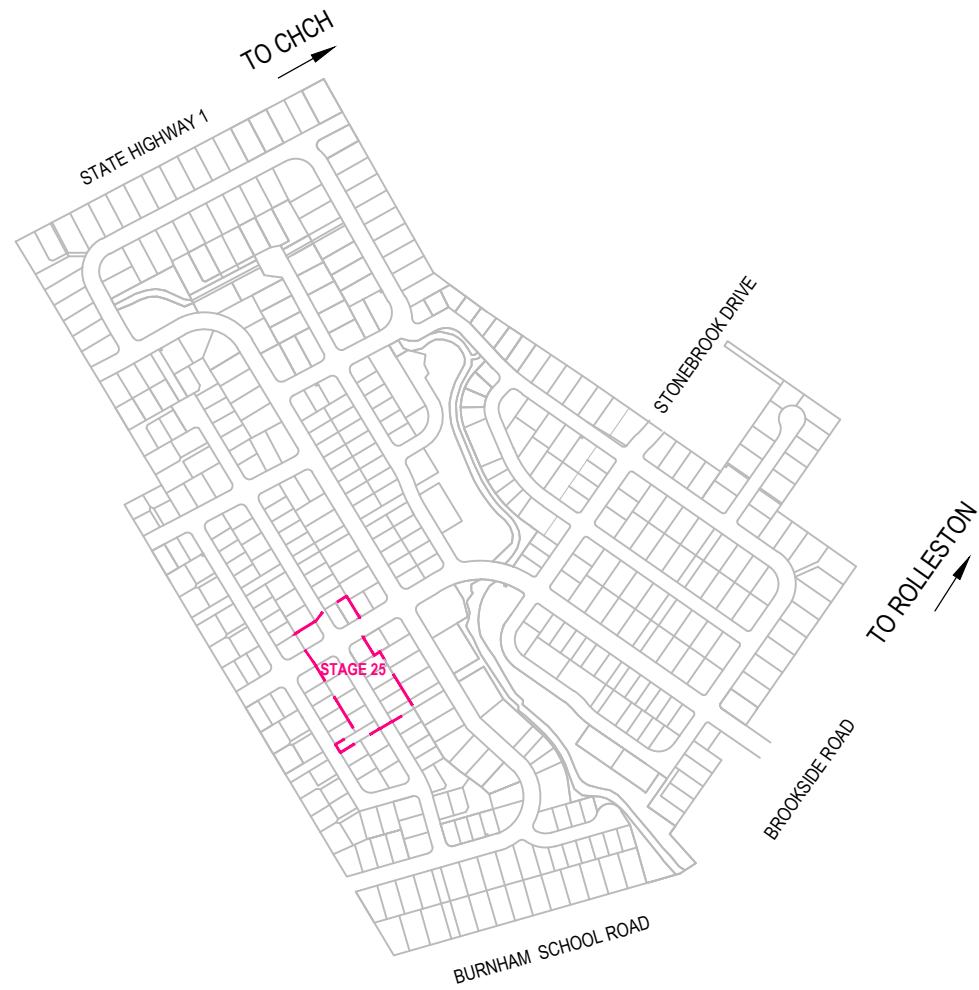


LOCATION PLAN

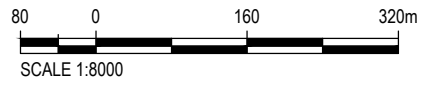

KEY

- FILL OVER 0.3m
- CUT
- ZERO
- FILL

NOTE:  
 1. CONTOUR INTERVALS ARE 0.1m

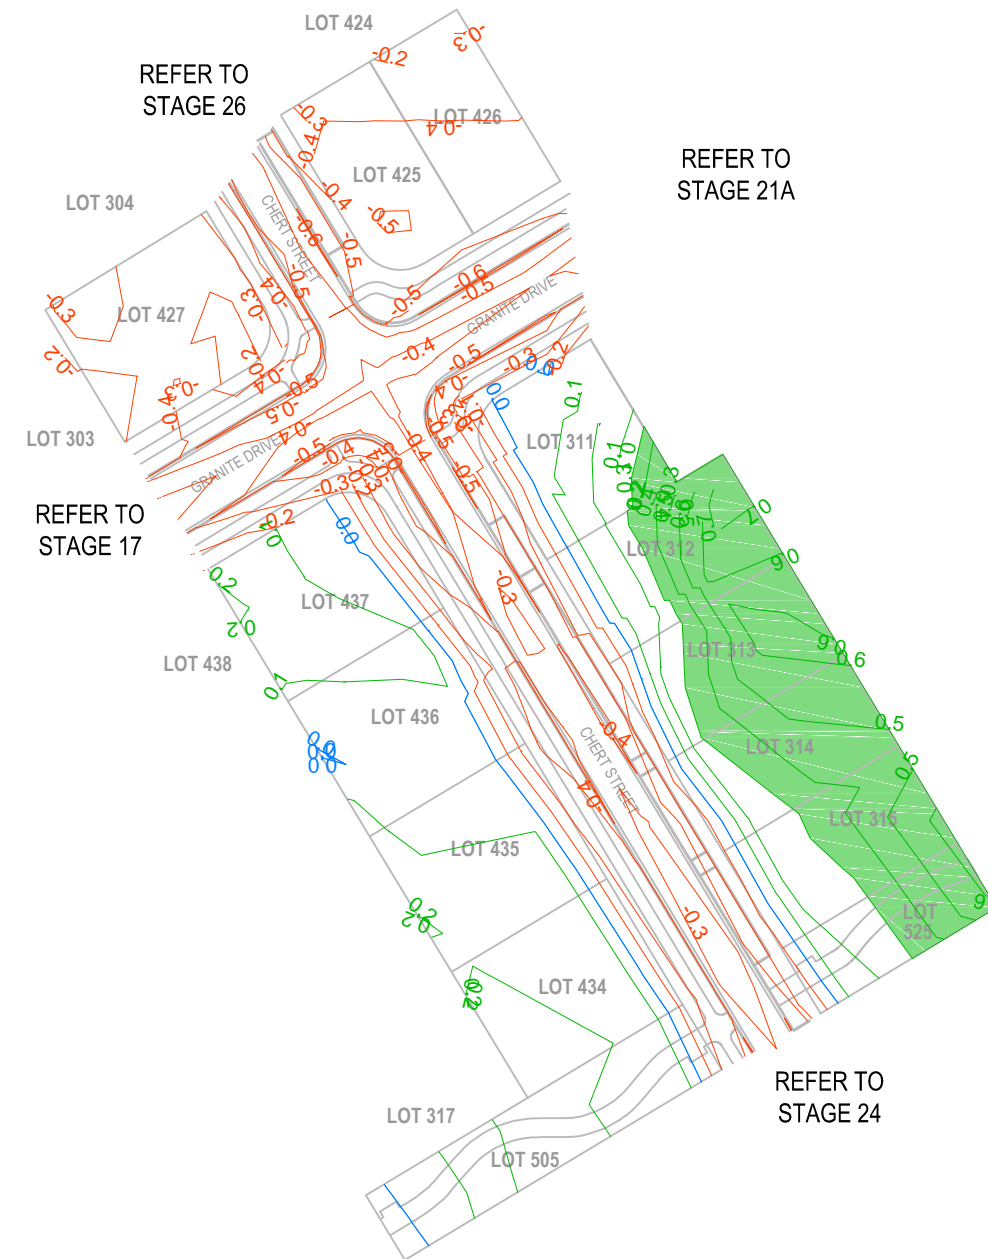

CLIENT		REV	DATE	REVISION DETAILS	APPROVED	DRAWN	DESIGNED	PROJECT	
						A.COLUMBUS	M.CROWE	STONEBROOK ROLLESTON	
						CHECKED		TITLE	
						D.WATSON		STAGE 25	
						APPROVED		CUT AND FILL	
						B.TOMS	DATE	AS BUILT	
							25.09.15	AS BUILT	
						B.TOMS		AS BUILT	
A	25.09.15			AS BUILTS ISSUED	B.TOMS			AS BUILT	PROJECT No.
									224926
								SCALE	SIZE
								AS SHOWN	A3
								DRAWING No.	REV
								DW-LD-S25-AB-CF-01	A