






NOTES:

AS BUILT INFORMATION HAS BEEN SUPPLIED BY KBs CONTRACTING & QUARRIES LTD - FEBRUARY 2015.
 HEIGHTS ARE IN TERMS OF MEAN SEA LEVEL
 ALL LATERALS ARE 100mmØ uPVC SN16

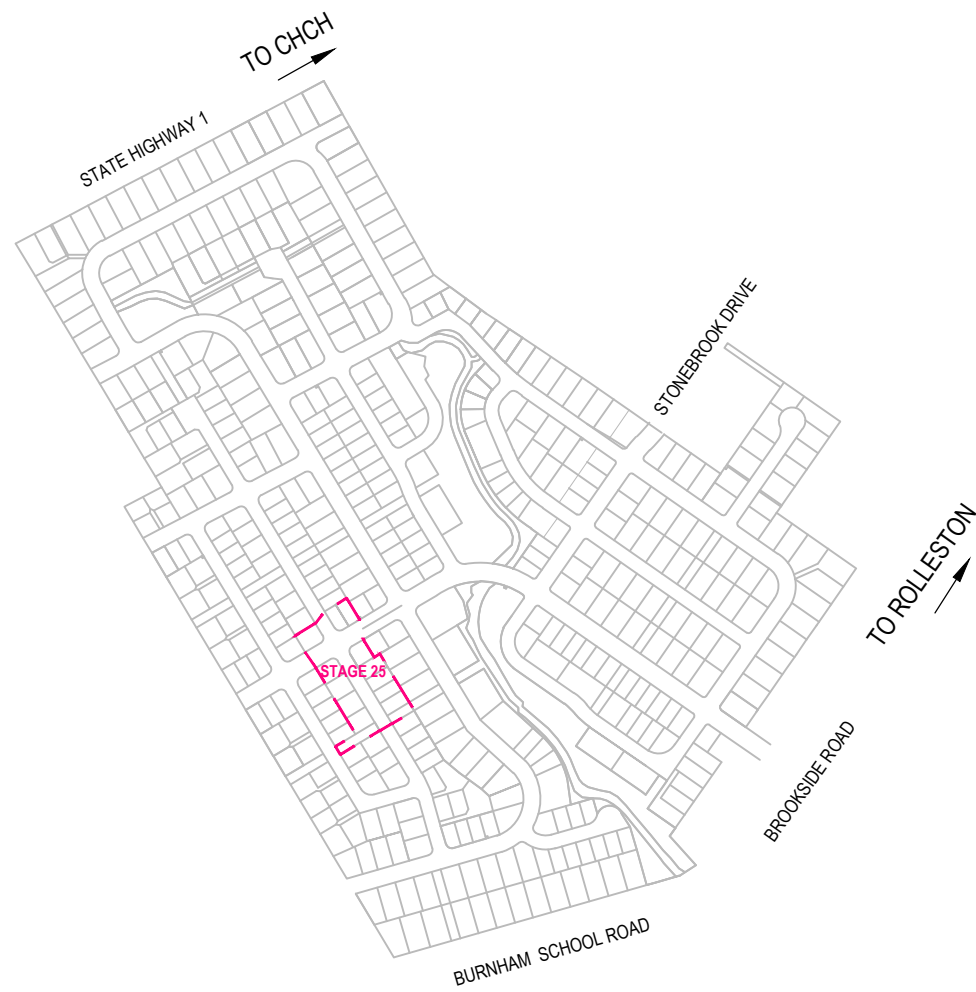

LOCATION PLAN

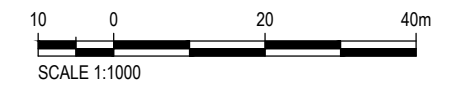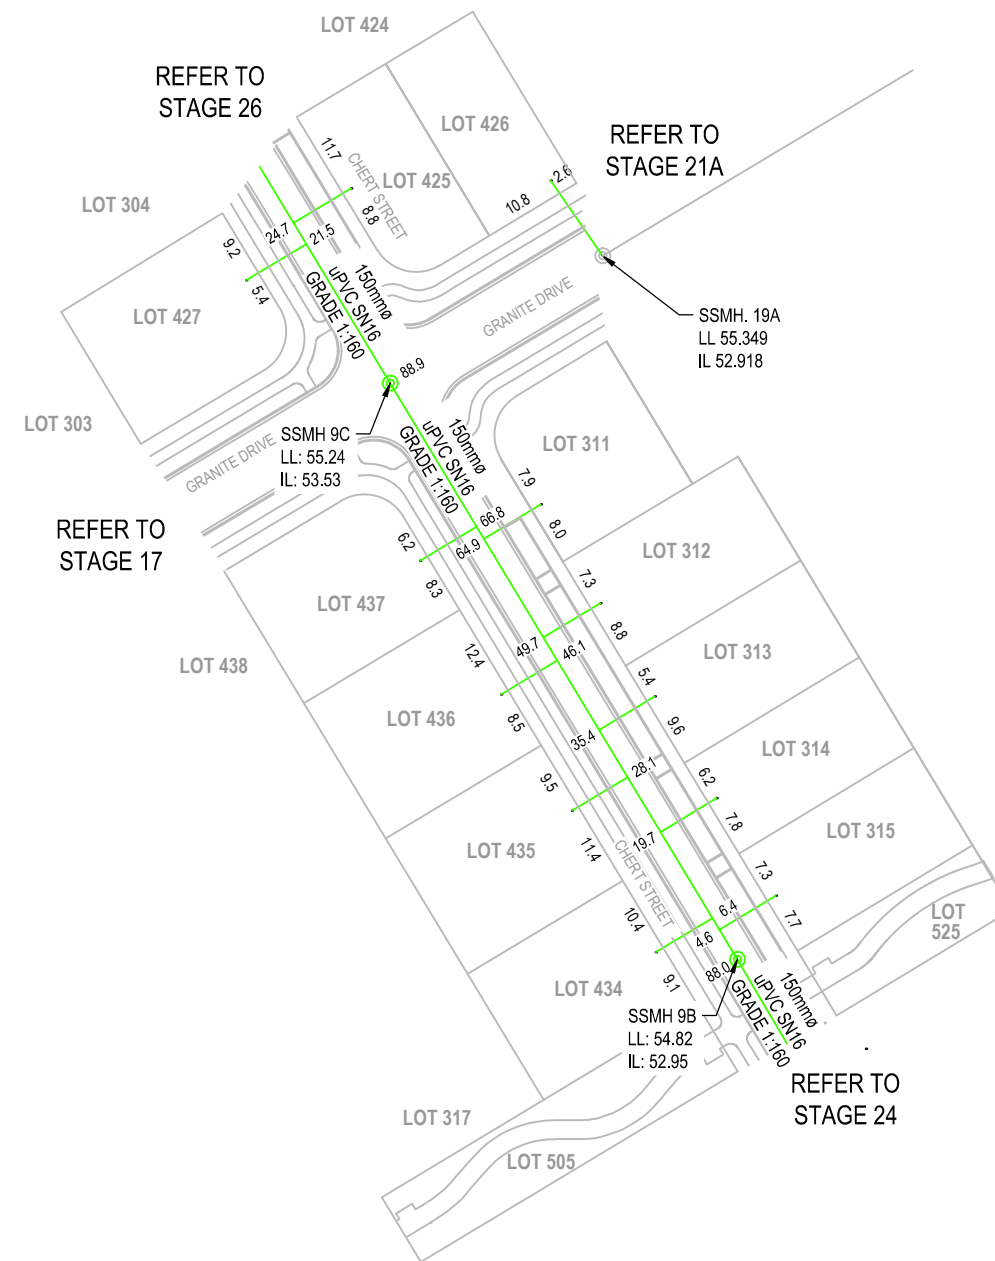

000000



CLIENT		REV	DATE	REVISION DETAILS	APPROVED	DRAWN	DESIGNED	PROJECT	
						A.COLUMBUS	M.CROWE	STONEBROOK ROLLESTON	
						CHECKED		TITLE	
						D.WATSON		STAGE 25 SEWER AS BUILT	
						APPROVED		AS BUILT	
						B.TOMS	DATE 25.09.15	PROJECT No. 224926	
						B.TOMS		SCALE AS SHOWN	SIZE A3
								DRAWING No.	REV
A	25.09.15			AS BUILTS ISSUED	B.TOMS			DW-LD-S25-AB-SS-01	A