





NOTES:

AS BUILT INFORMATION HAS BEEN SUPPLIED BY KBs CONTRACTING & QUARRIES LTD - SEPTEMBER 2015.  
HEIGHTS ARE IN TERMS OF MEAN SEA LEVEL

RS = SINGLE SUMP IN SDC LOW PROFILE KERB AND CHANNEL

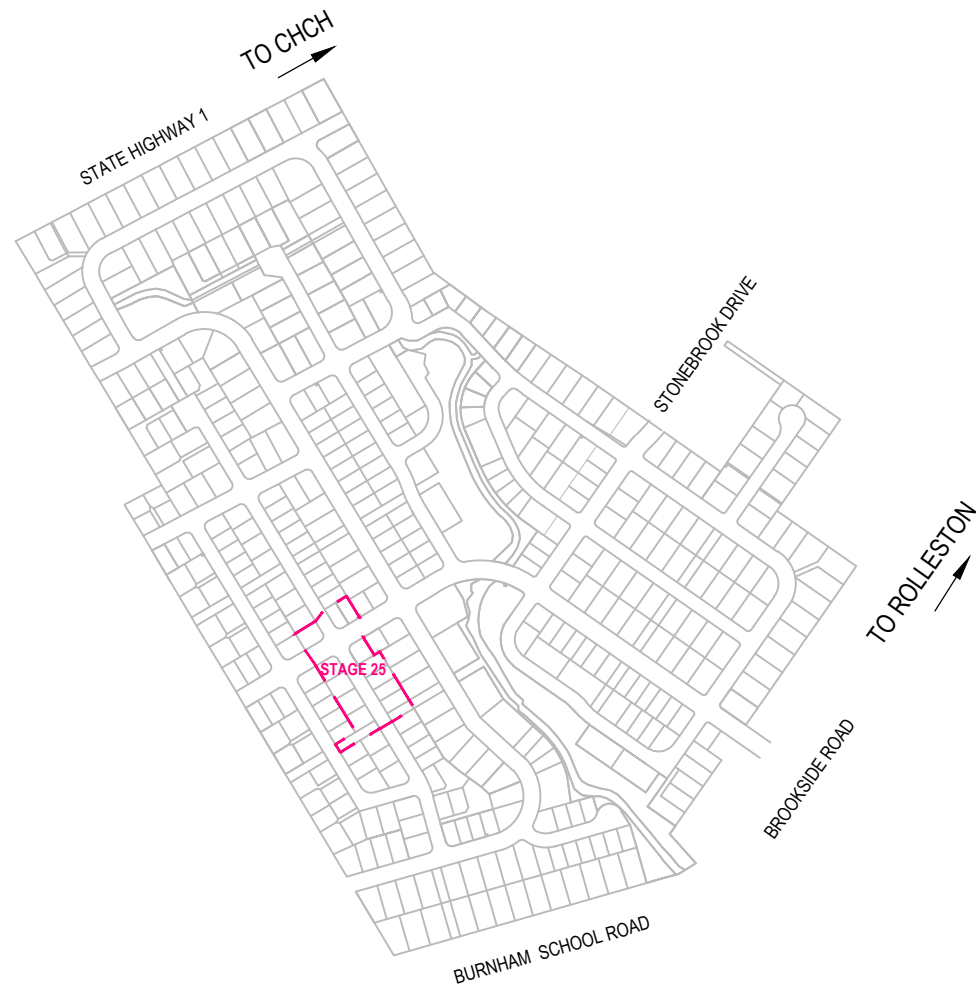

LOCATION PLAN

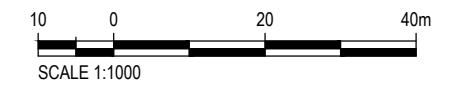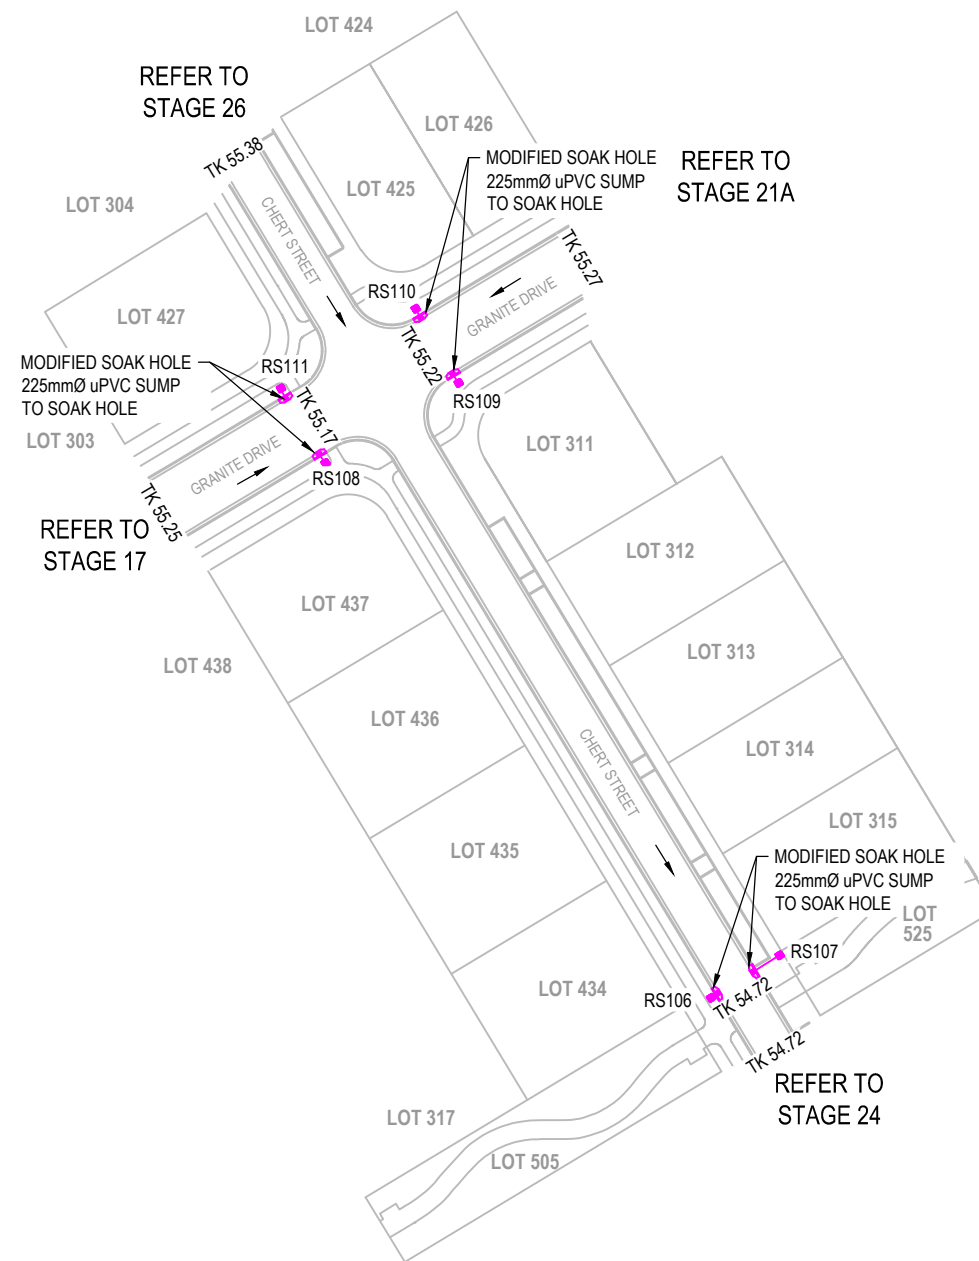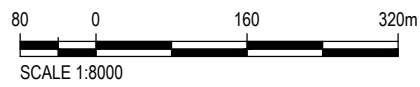

000000

REV	DATE	REVISION DETAILS	APPROVED
A	25.09.15	AS BUILTS ISSUED	B.TOMS

DRAWN	DESIGNED
A.COLUMBUS	M.CROWE
CHECKED	
D.WATSON	
APPROVED	
B.TOMS	
DATE 25.09.15	

PROJECT
STONEBROOK ROLLESTON
TITLE
STAGE 25 STORMWATER AS BUILT

AS BUILT	PROJECT No.	224926
SCALE	AS SHOWN	A3
DRAWING No.	DW-LD-S25-AB-SW-01	REV
		A