



LOCATION PLAN

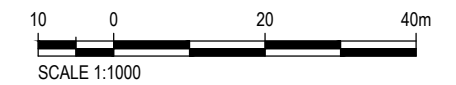

NOTES:
 AS BUILT INFORMATION HAS BEEN SUPPLIED BY KBs CONTRACTING & QUARRIES LTD - SEPTEMBER 2015.
 HEIGHTS ARE IN TERMS OF MEAN SEA LEVEL
 ALL LATERALS ARE 20mmØ ID POLY

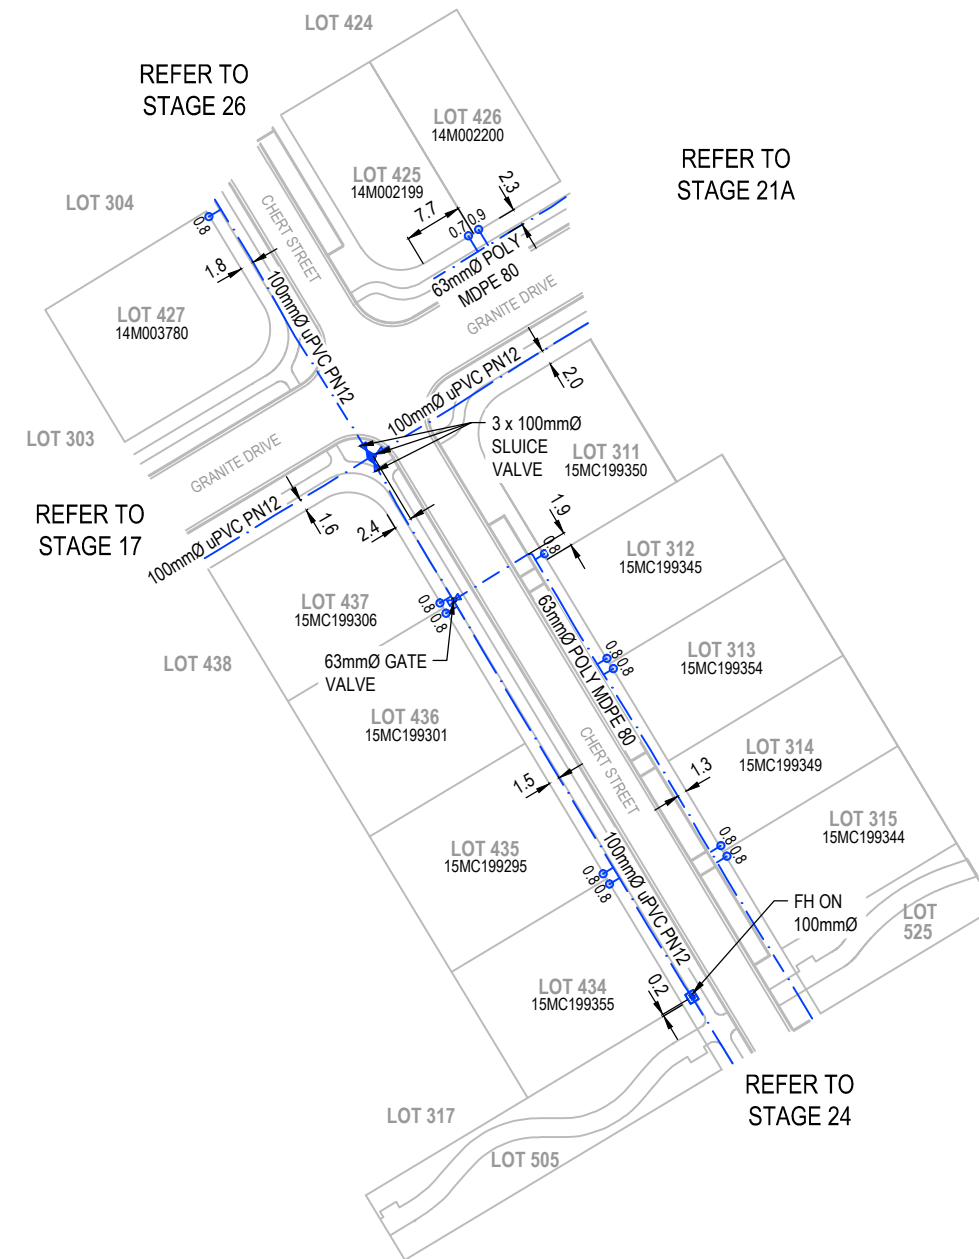

000000



CLIENT		REV	DATE	REVISION DETAILS	APPROVED	DRAWN	DESIGNED	PROJECT	
						A.COLUMBUS	M.CROWE	STONEBROOK ROLLESTON	
						CHECKED		TITLE	
						D.WATSON		STAGE 25	
						APPROVED		WATER	
						B.TOMS	DATE 25.09.15	AS BUILT	
A	25.09.15			AS BUILTS ISSUED	B.TOMS	B.TOMS		AS BUILT	
								PROJECT No.	AS BUILT
								224926	PROJECT No.
								SCALE	SIZE
								AS SHOWN	A3
								DRAWING No.	REV
								DW-LD-S25-AB-W-01	A