



NOTES:

AS BUILT INFORMATION HAS BEEN SUPPLIED BY KBs CONTRACTING & QUARRIES LTD - SEPTEMBER 2015.  
HEIGHTS ARE IN TERMS OF MEAN SEA LEVEL

RS = SINGLE SUMP IN SDC LOW PROFILE KERB AND CHANNEL  
DS = DOUBLE SUMP IN SDC LOW PROFILE KERB AND CHANNEL

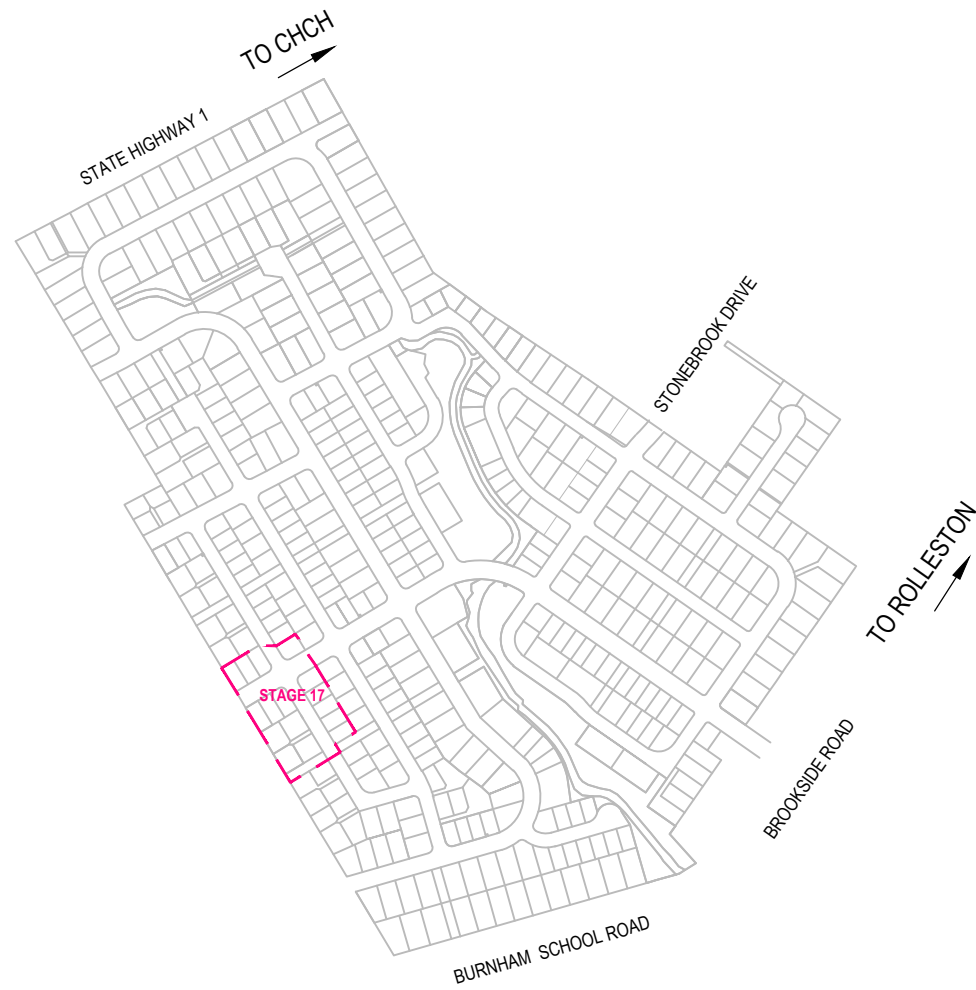

LOCATION PLAN

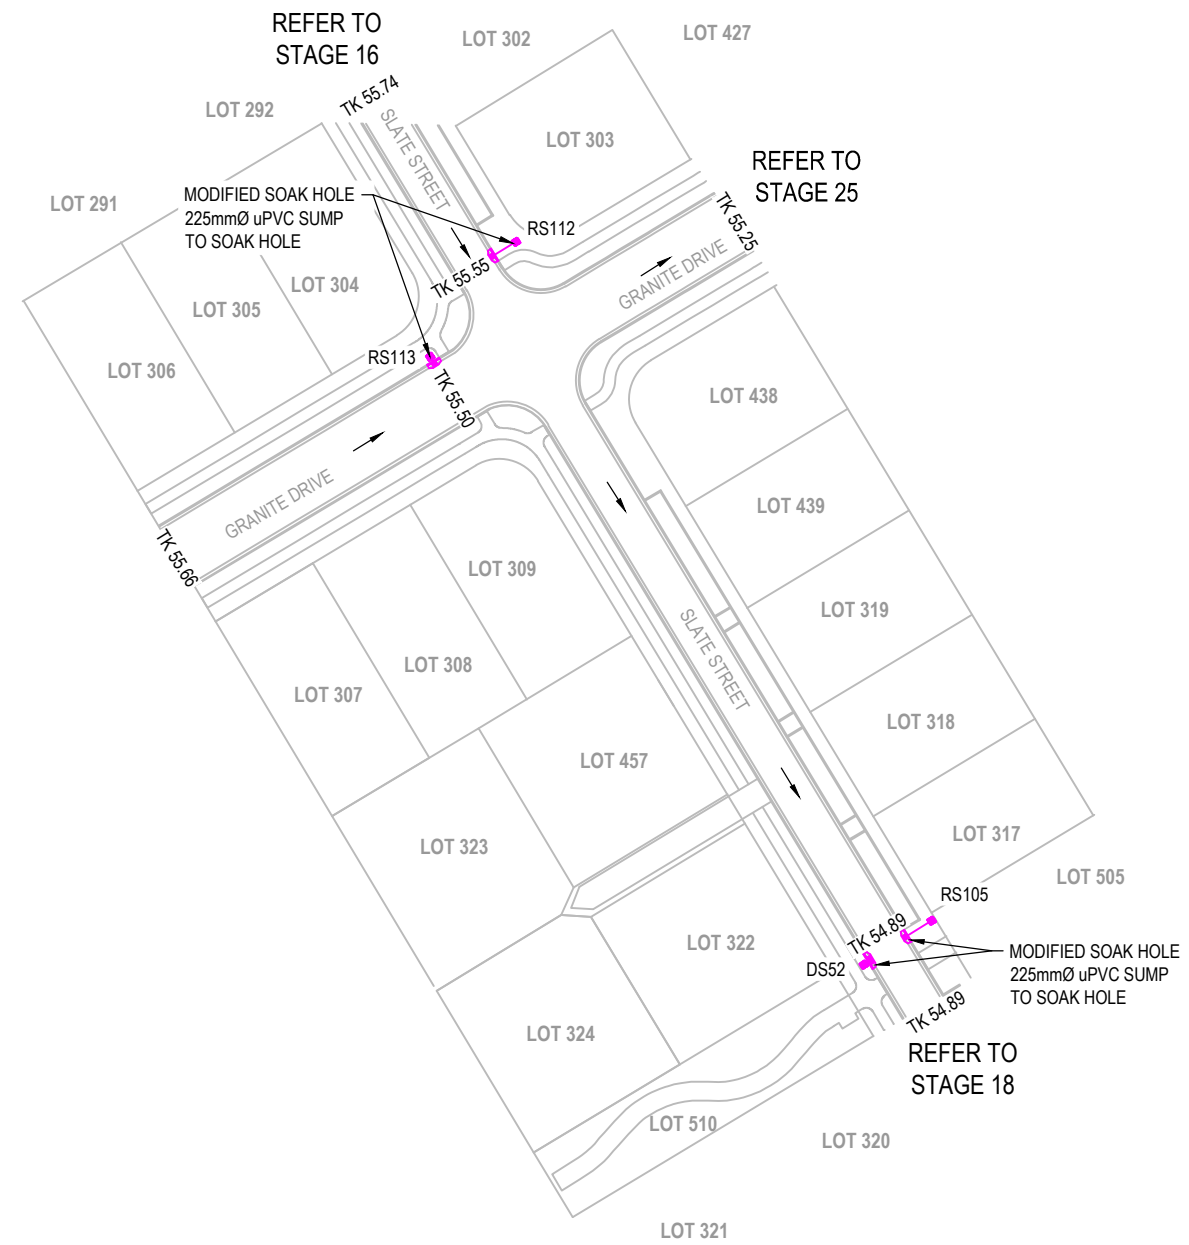

REV	DATE	REVISION DETAILS	APPROVED
B	27.11.15	LOT NUMBER AMENDED	B.TOMS
A	25.09.15	AS BUILTS ISSUED	B.TOMS

APPROVED	DATE
<i>B.TOMS</i>	25.09.15
<i>B.TOMS</i>	

PROJECT
STONEBROOK ROLLESTON
TITLE
STAGE 17 STORMWATER AS BUILT

AS BUILT	PROJECT No.	224926
SCALE	AS SHOWN	A3
DRAWING No.	DW-LD-S17-AB-SW-01	REV
		B