

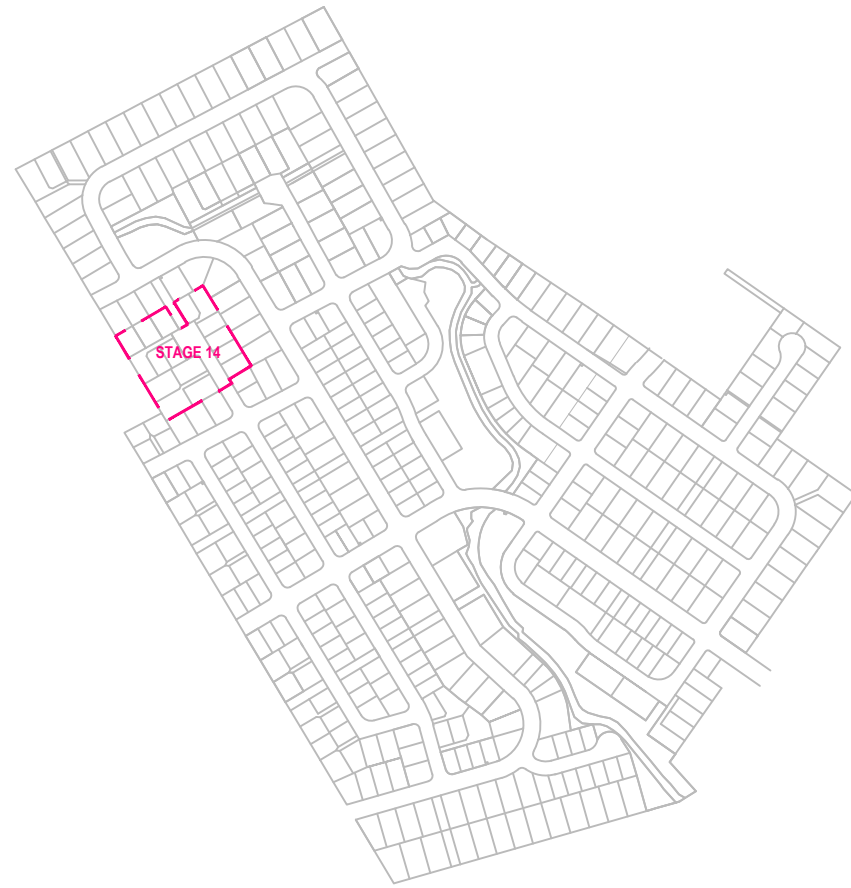


NOTES:

AS BUILT INFORMATION HAS BEEN SUPPLIED BY KBs CONTRACTING & QUARRIES LTD - AUGUST 2014.
 HEIGHTS ARE IN TERMS OF MEAN SEA LEVEL
 ALL LATERALS ARE 100mmØ uPVC SN16

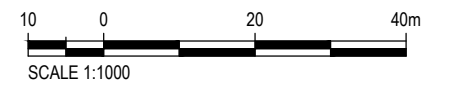

LOCATION PLAN

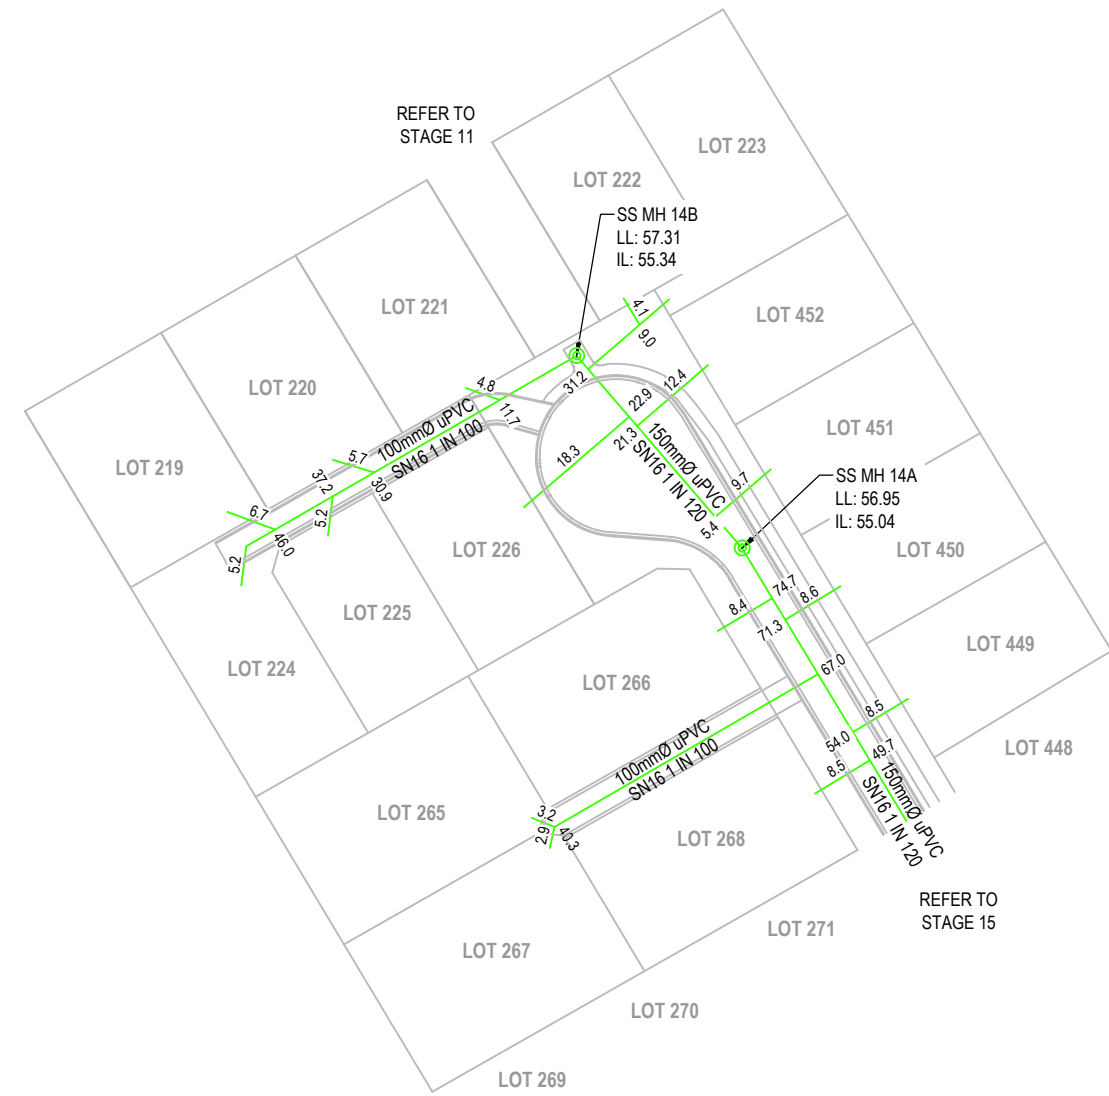

000000



CLIENT

REV	DATE	REVISION DETAILS	APPROVED
A	17.04.15	AS BUILTS ISSUED	B.TOMS

DRAWN	DESIGNED
A.COLUMBUS	M.CROWE
CHECKED	
D.WATSON	
APPROVED	
B.TOMS	DATE 17.04.15
B.TOMS	

PROJECT
STONEBROOK ROLLESTON
TITLE
STAGE 14 SEWER AS BUILT

AS BUILT	
PROJECT No.	224926
SCALE	AS SHOWN
DRAWING No.	DW-LD-S14-AB-SS-01
SIZE	A3
REV	A