







NOTES:

AS BUILT INFORMATION HAS BEEN SUPPLIED BY KBs CONTRACTING & QUARRIES LTD - FEBRUARY 2015.
 HEIGHTS ARE IN TERMS OF MEAN SEA LEVEL
 ALL LATERALS ARE 100mmØ uPVC SN16

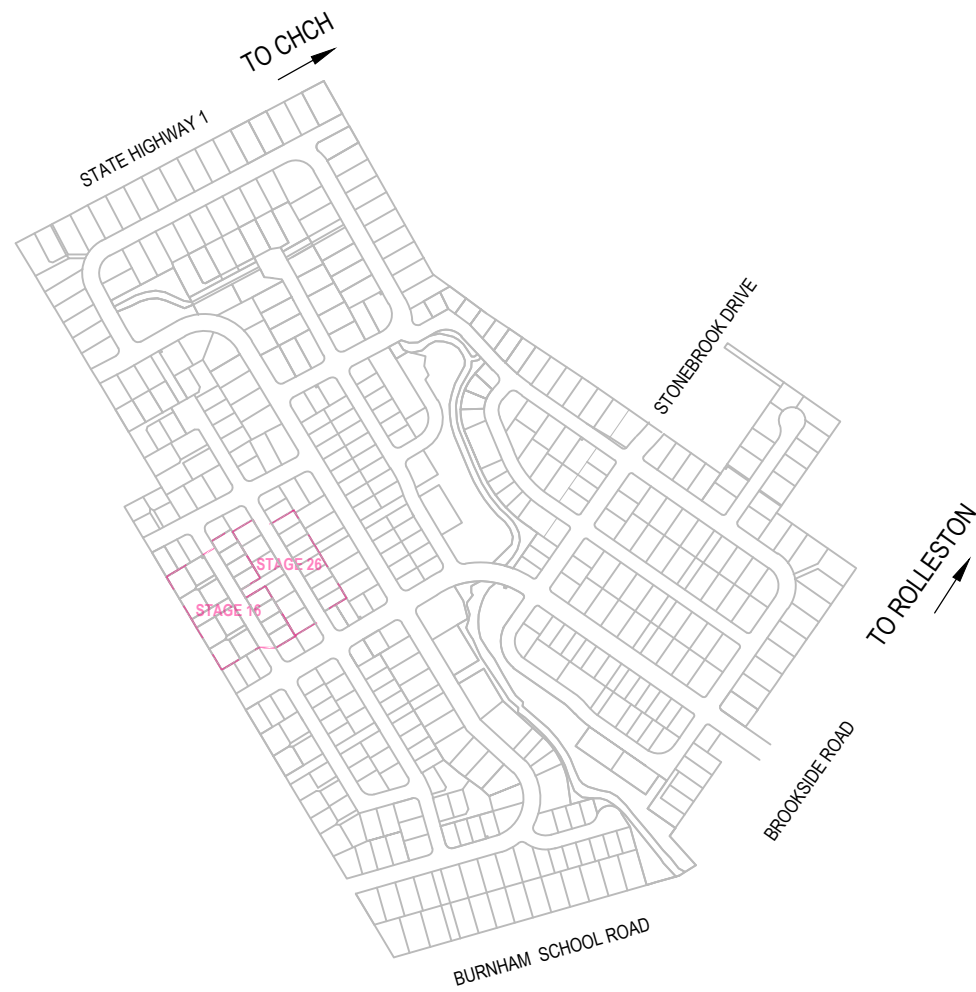

LOCATION PLAN

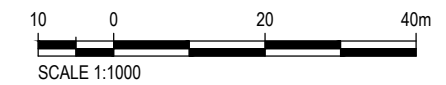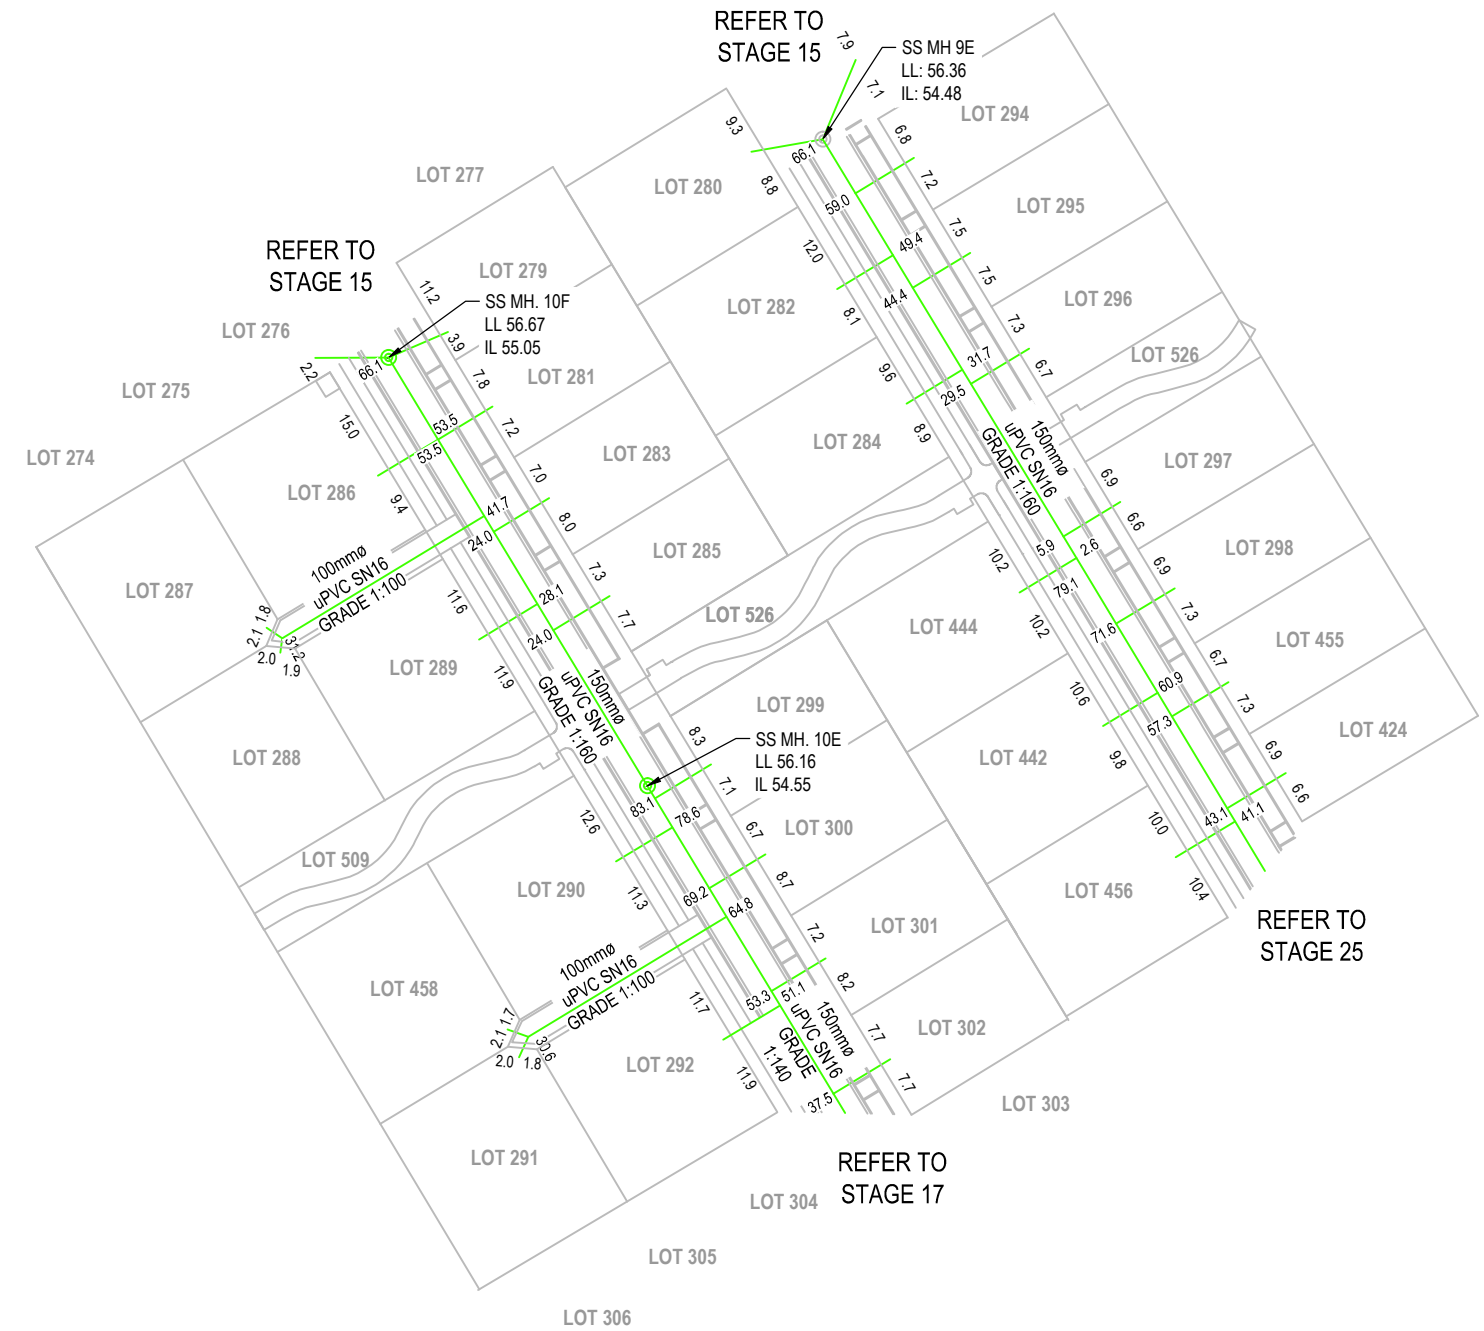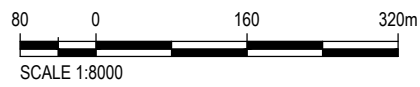

000000



CLIENT

REV	DATE	REVISION DETAILS	APPROVED
A	30.06.15	AS BUILTS ISSUED	B.TOMS

DRAWN	DESIGNED
A.COLUMBUS	M.CROWE
CHECKED	
D.WATSON	
APPROVED	DATE
B.TOMS	

PROJECT
STONEBROOK ROLLESTON
TITLE
STAGE 16 & 26 SEWER AS BUILT

AS BUILT	
PROJECT No.	224926
SCALE	A3
AS SHOWN	
DRAWING No.	DW-LD-S16-AB-SS-01
REV	A