


NOTES:

AS BUILT INFORMATION HAS BEEN SUPPLIED BY KBs CONTRACTING & QUARRIES LTD - DECEMBER 2014.
HEIGHTS ARE IN TERMS OF MEAN SEA LEVEL



RS = ROAD SUMP IN SDC LOW PROFILE KERB AND CHANNEL

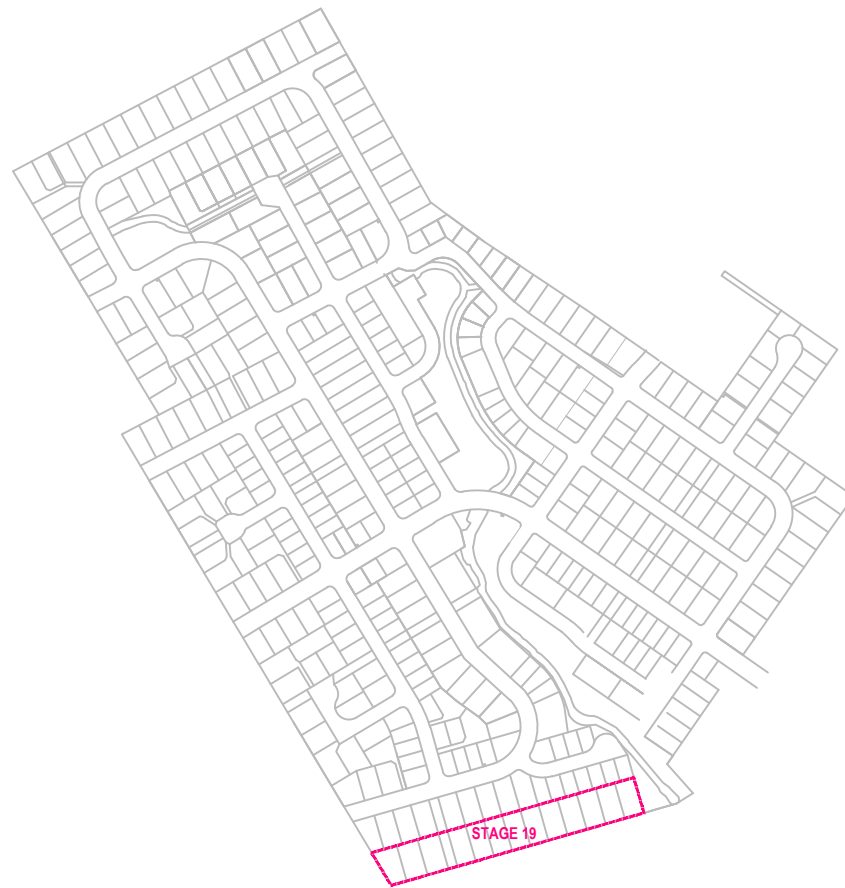

LOCATION PLAN



CLIENT		REV	DATE	REVISION DETAILS	APPROVED	DRAWN	DESIGNED	PROJECT	
						A.COLUMBUS	M.CROWE	STONEBROOK ROLLESTON	
						CHECKED		TITLE	
						D.WATSON		STAGE 19	
						APPROVED		SEWER	
							DATE	AS BUILT	
						B.TOMS		AS BUILT	
								PROJECT No.	AS BUILT
								224926	PROJECT No.
								SCALE	SIZE
								AS SHOWN	A3
								DRAWING No.	REV
								DW-LD-S19-AB-SS-01	A