






NOTES:

AS BUILT INFORMATION HAS BEEN SUPPLIED BY KBs CONTRACTING & QUARRIES LTD - FEBRUARY 2015.
 HEIGHTS ARE IN TERMS OF MEAN SEA LEVEL
 ALL LATERALS ARE 100mmØ uPVC SN16

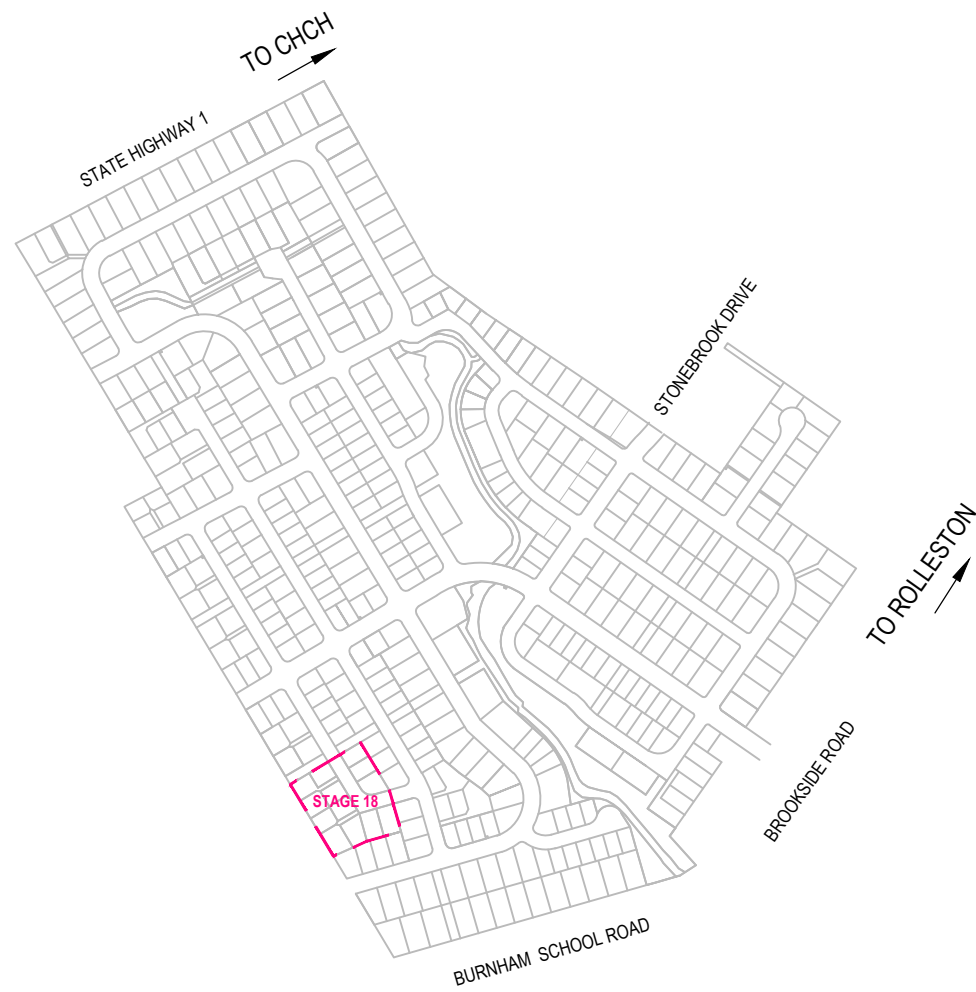

LOCATION PLAN

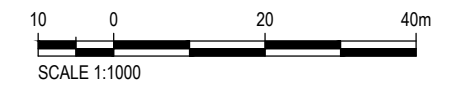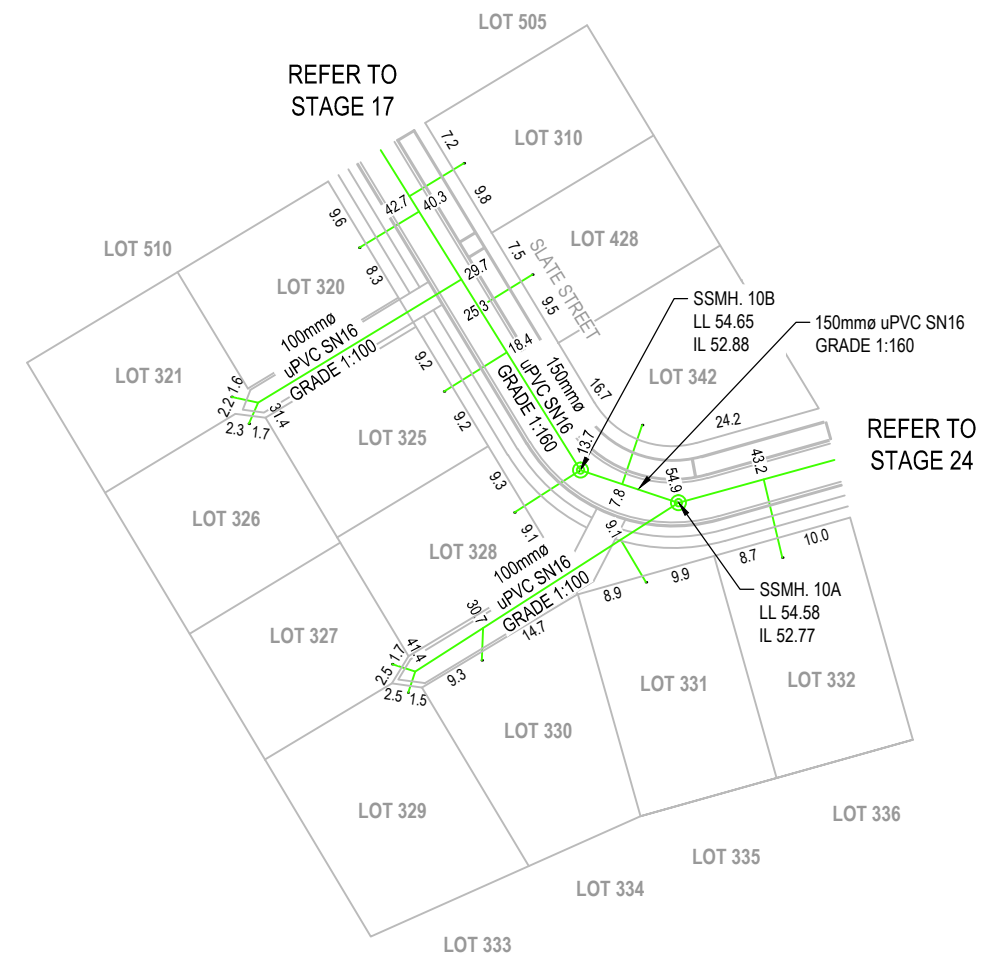

000000



CLIENT

REV	DATE	REVISION DETAILS	APPROVED
A	25.09.15	AS BUILTS ISSUED	B.TOMS

DRAWN	DESIGNED
A.COLUMBUS	M.CROWE
CHECKED	
D.WATSON	
APPROVED	
B.TOMS	DATE 25.09.15
B.TOMS	

PROJECT
STONEBROOK ROLLESTON
TITLE
STAGE 18 SEWER AS BUILT

AS BUILT	
PROJECT No.	224926
SCALE	A3
AS SHOWN	
DRAWING No.	DW-LD-S18-AB-SS-01
REV	A