




NOTES:

AS BUILT INFORMATION HAS BEEN SUPPLIED BY KBs  
 CONTRACTING & QUARRIES LTD - SEPTEMBER 2015.  
 HEIGHTS ARE IN TERMS OF MEAN SEA LEVEL

RS = SINGLE SUMP IN SDC LOW PROFILE KERB AND CHANNEL

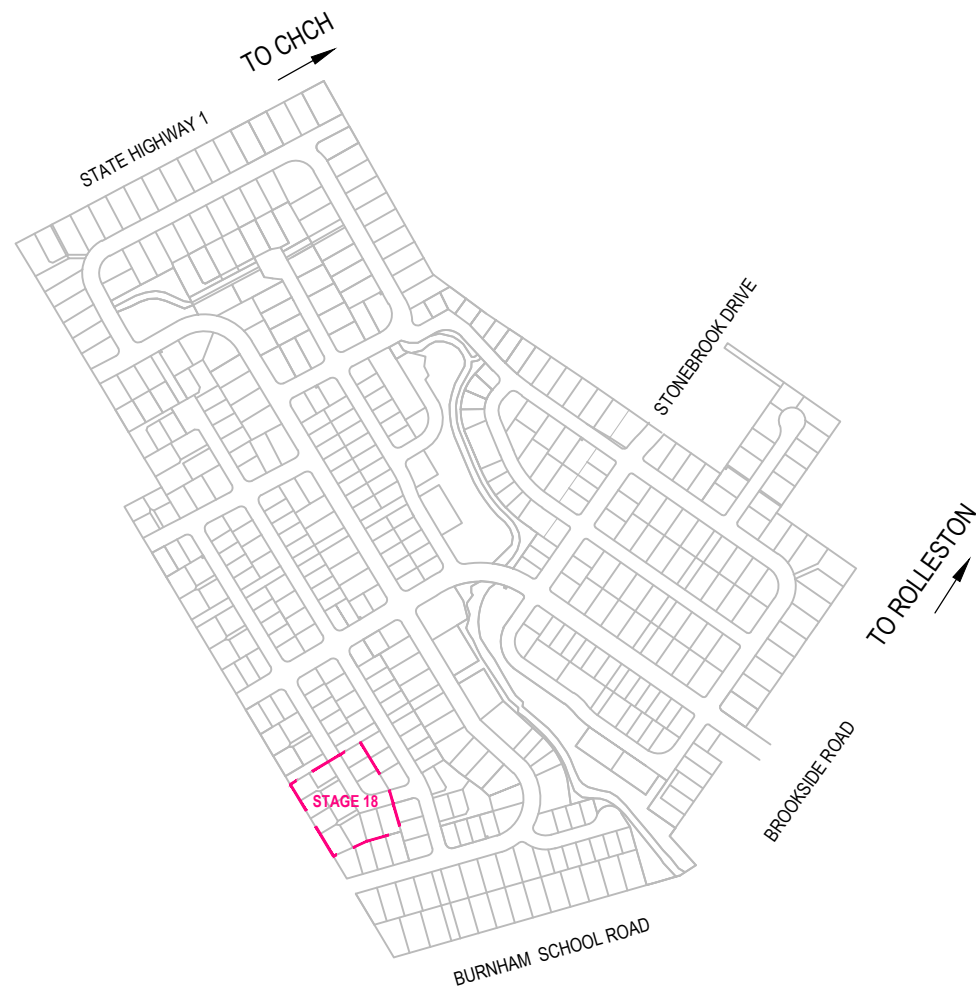

LOCATION PLAN

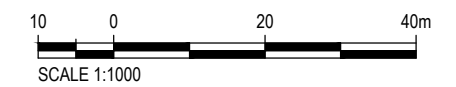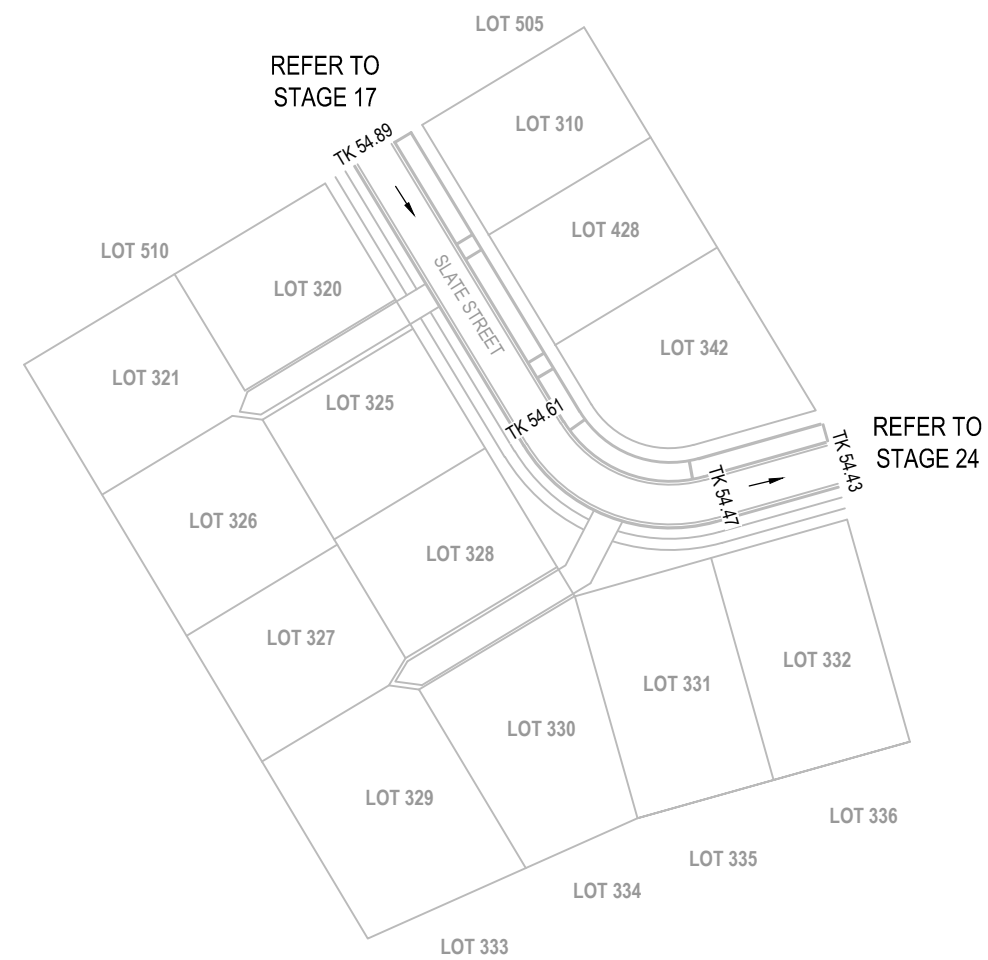

000000

CLIENT		REV	DATE	REVISION DETAILS	APPROVED	DRAWN	DESIGNED	PROJECT	
						A.COLUMBUS	M.CROWE	STONEBROOK ROLLESTON	
						CHECKED		TITLE	
						D.WATSON		STAGE 18	
						APPROVED		STORMWATER	
						<i>B.TOMS</i>	DATE	AS BUILT	
						<i>B.TOMS</i>	25.09.15	AS BUILT	
A	25.09.15			AS BUILTS ISSUED	B.TOMS			PROJECT No.	AS BUILT
								224926	PROJECT No.
								SCALE	SIZE
								AS SHOWN	A3
								DRAWING No.	REV
								DW-LD-S18-AB-SW-01	A