



# Appendix A

## Figures

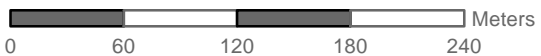

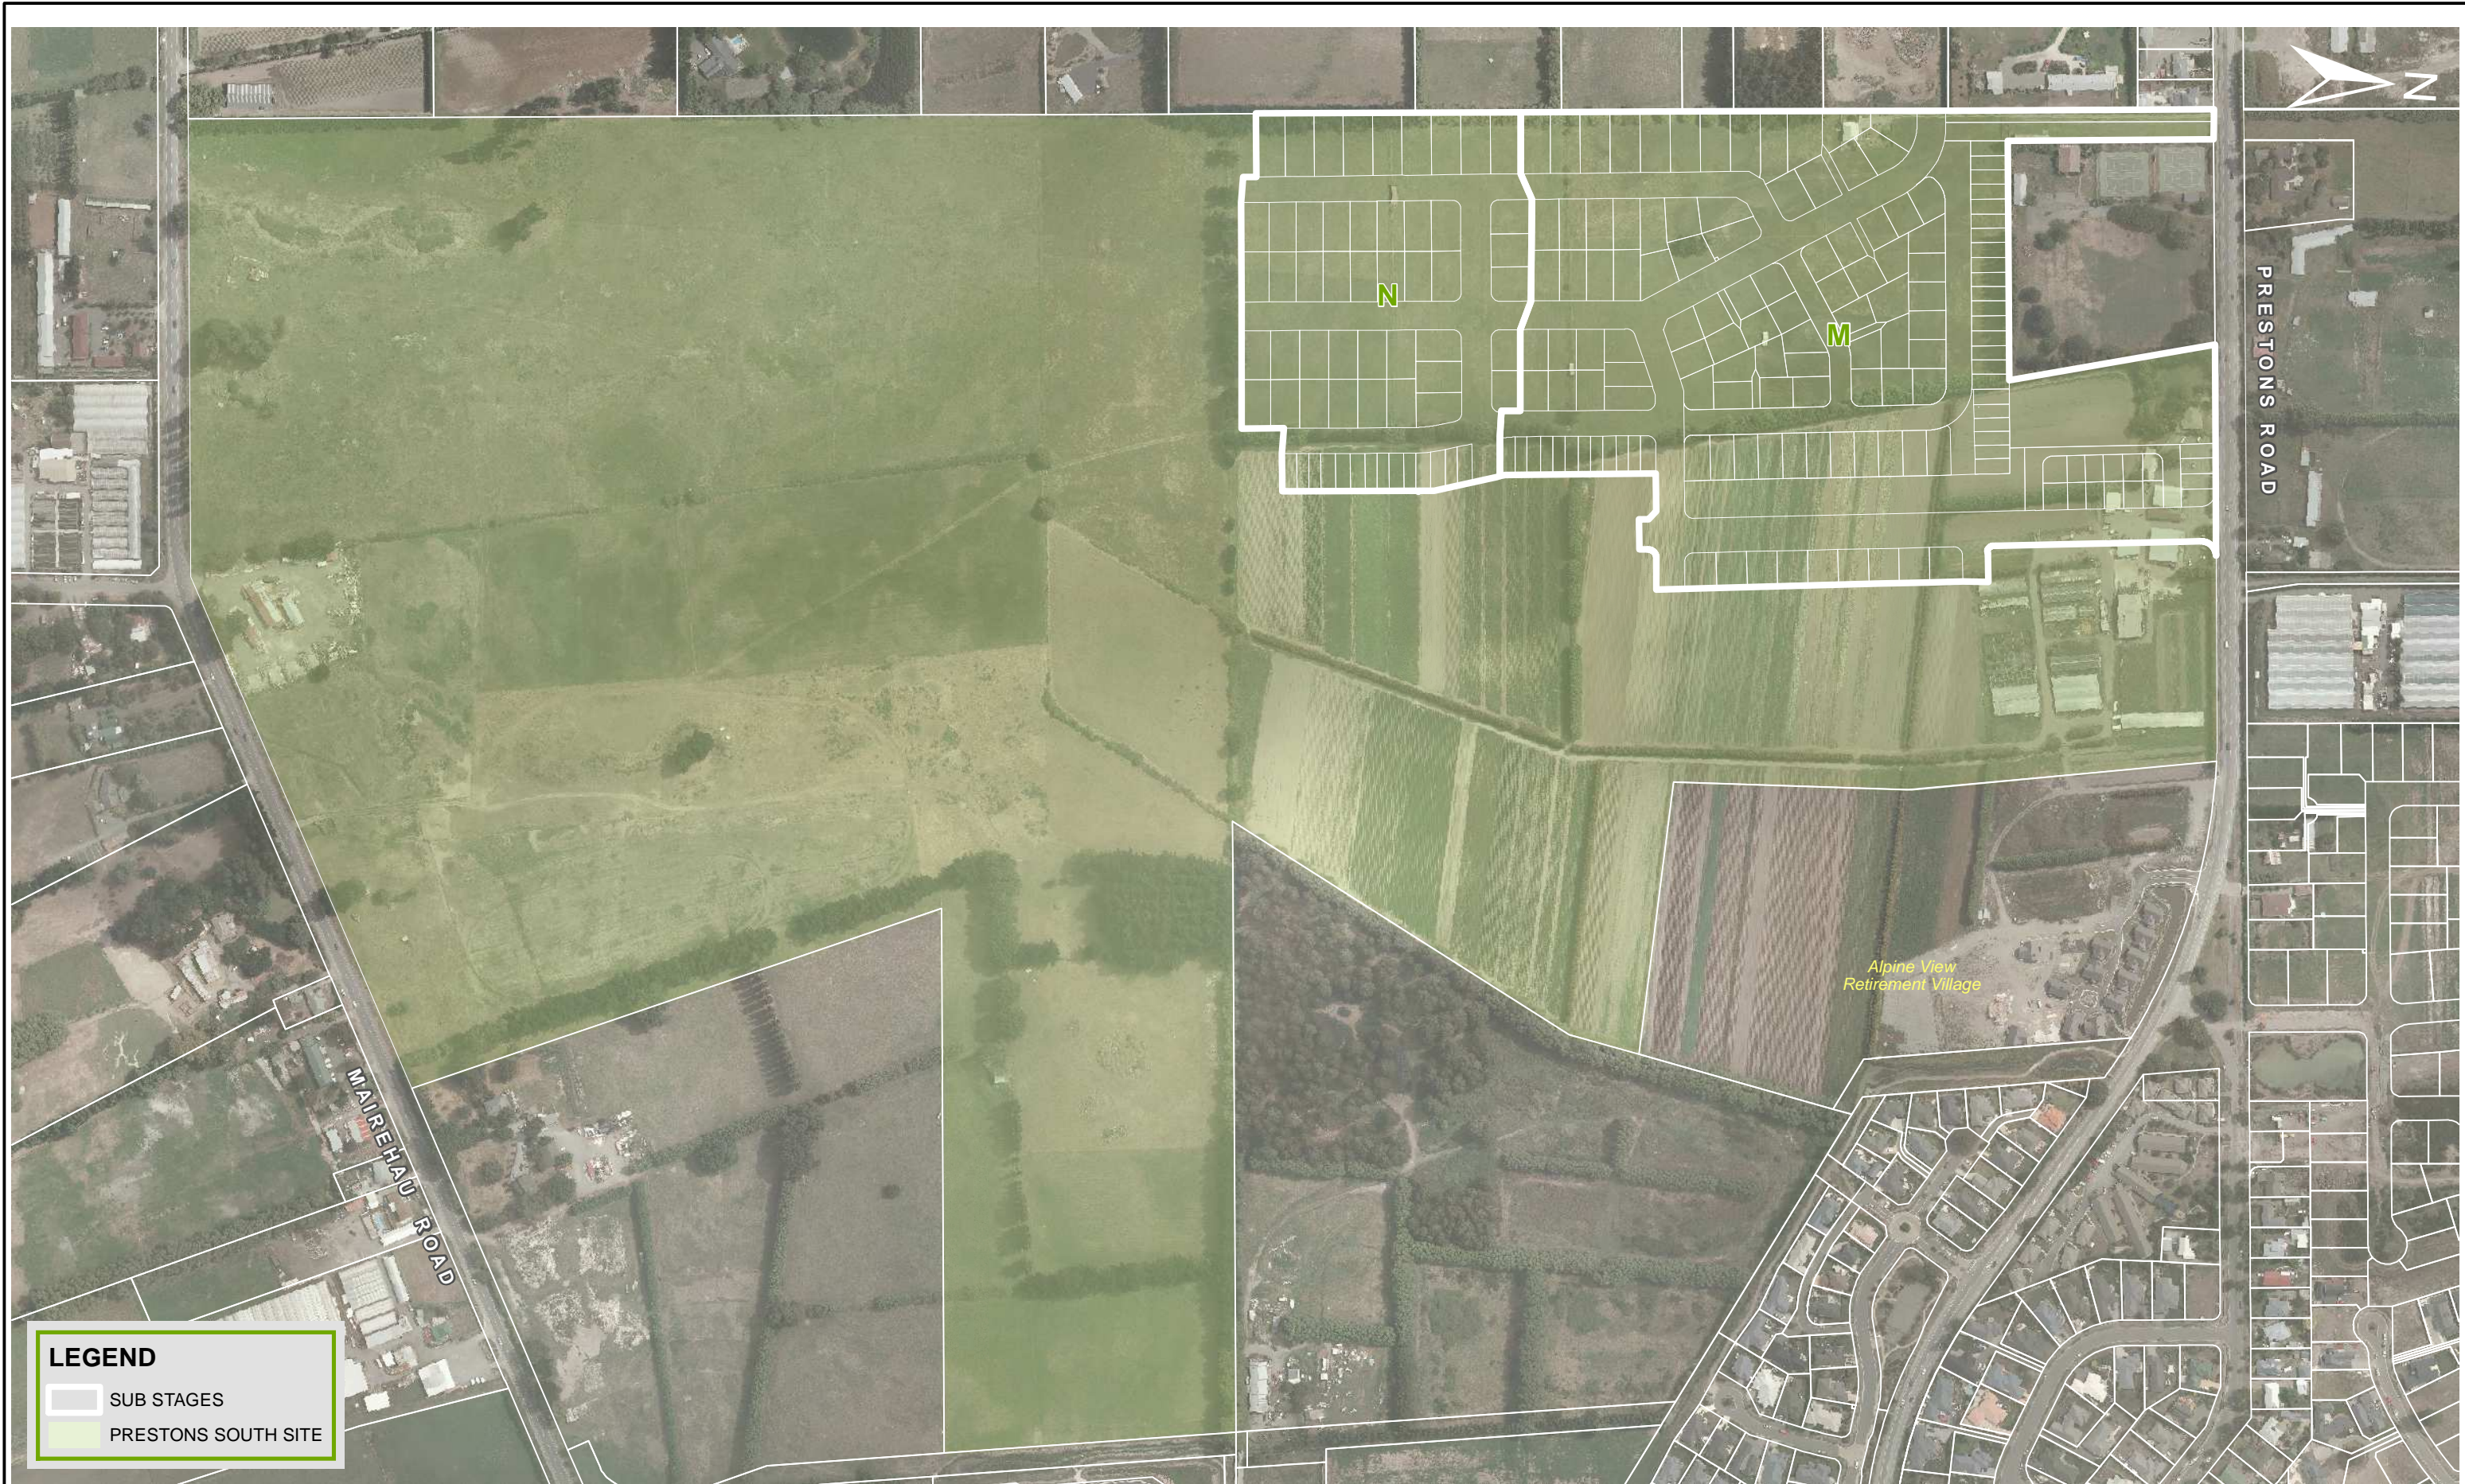

**NOTES** - PROPERTY DATA FROM LINZ  
 - AERIAL IMAGE FROM CCC POST 2011 EQ




REV	DATE	REVISION DETAILS	APPROVED
A	03.15	ISSUE	T.BROWNE

DRAWN	DESIGNED
R.Dawson	J.Muirson
CHECKED	
J.Kupec	
APPROVED	
DATE	
T. Browne March 2015	

PROJECT
PRESTONS SOUTH STAGES 1M & 1N
TITLE
SITE LOCATION PLAN

PROJECT No.	235361
SCALE	AS SHOWN
DRAWING No.	FIG 1
SIZE	A3
REV	A



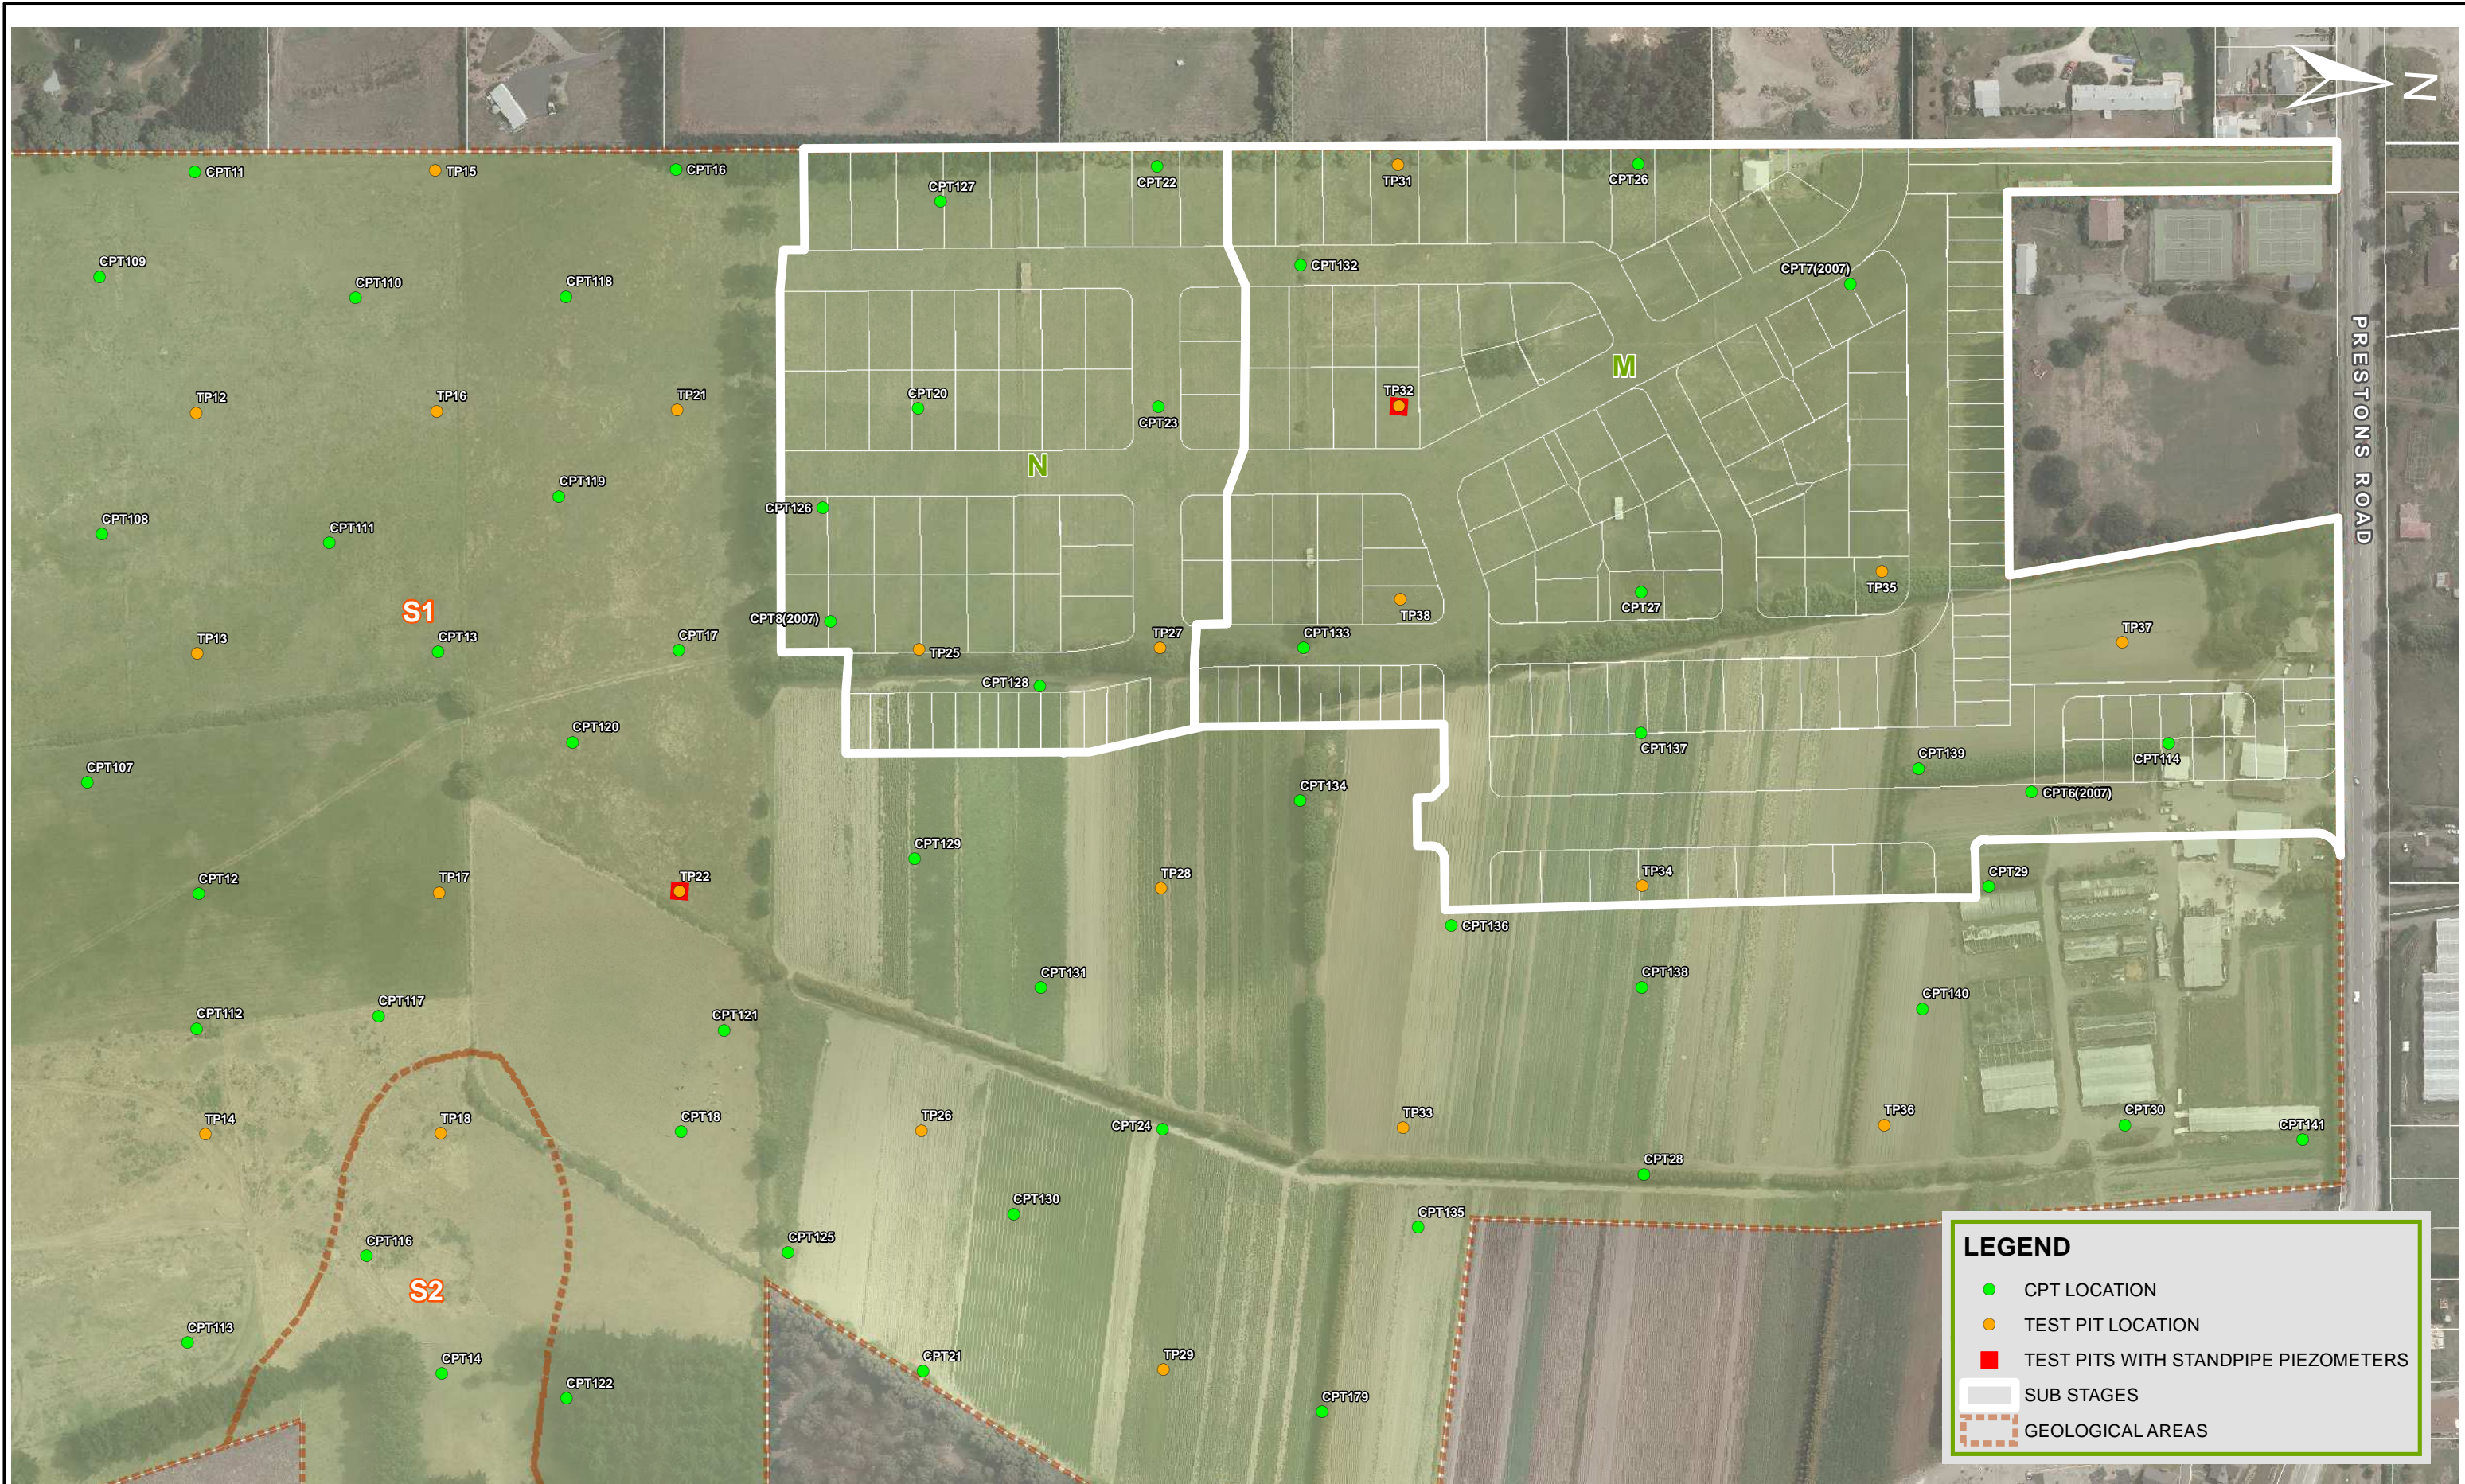

**LEGEND**

- CPT LOCATION
- TEST PIT LOCATION
- TEST PITS WITH STANDPIPE PIEZOMETERS
- SUB STAGES
- GEOLOGICAL AREAS



**NOTES** - PROPERTY DATA FROM LINZ  
 - AERIAL IMAGE FROM CCC POST 2011 EQ




REV	DATE	REVISION DETAILS	APPROVED
A	03.15	ISSUE	T.BROWNE

DRAWN	DESIGNED
R.Dawson	J.Muirson
CHECKED	
J.Kupec	
APPROVED	
DATE	
T. Browne	March 2015

PROJECT
PRESTONS SOUTH STAGES 1M & 1N
TITLE
PREVIOUS INVESTIGATIONS

PROJECT No.	235361
SCALE	AS SHOWN
SIZE	A3
DRAWING No.	FIG 2
REV	A



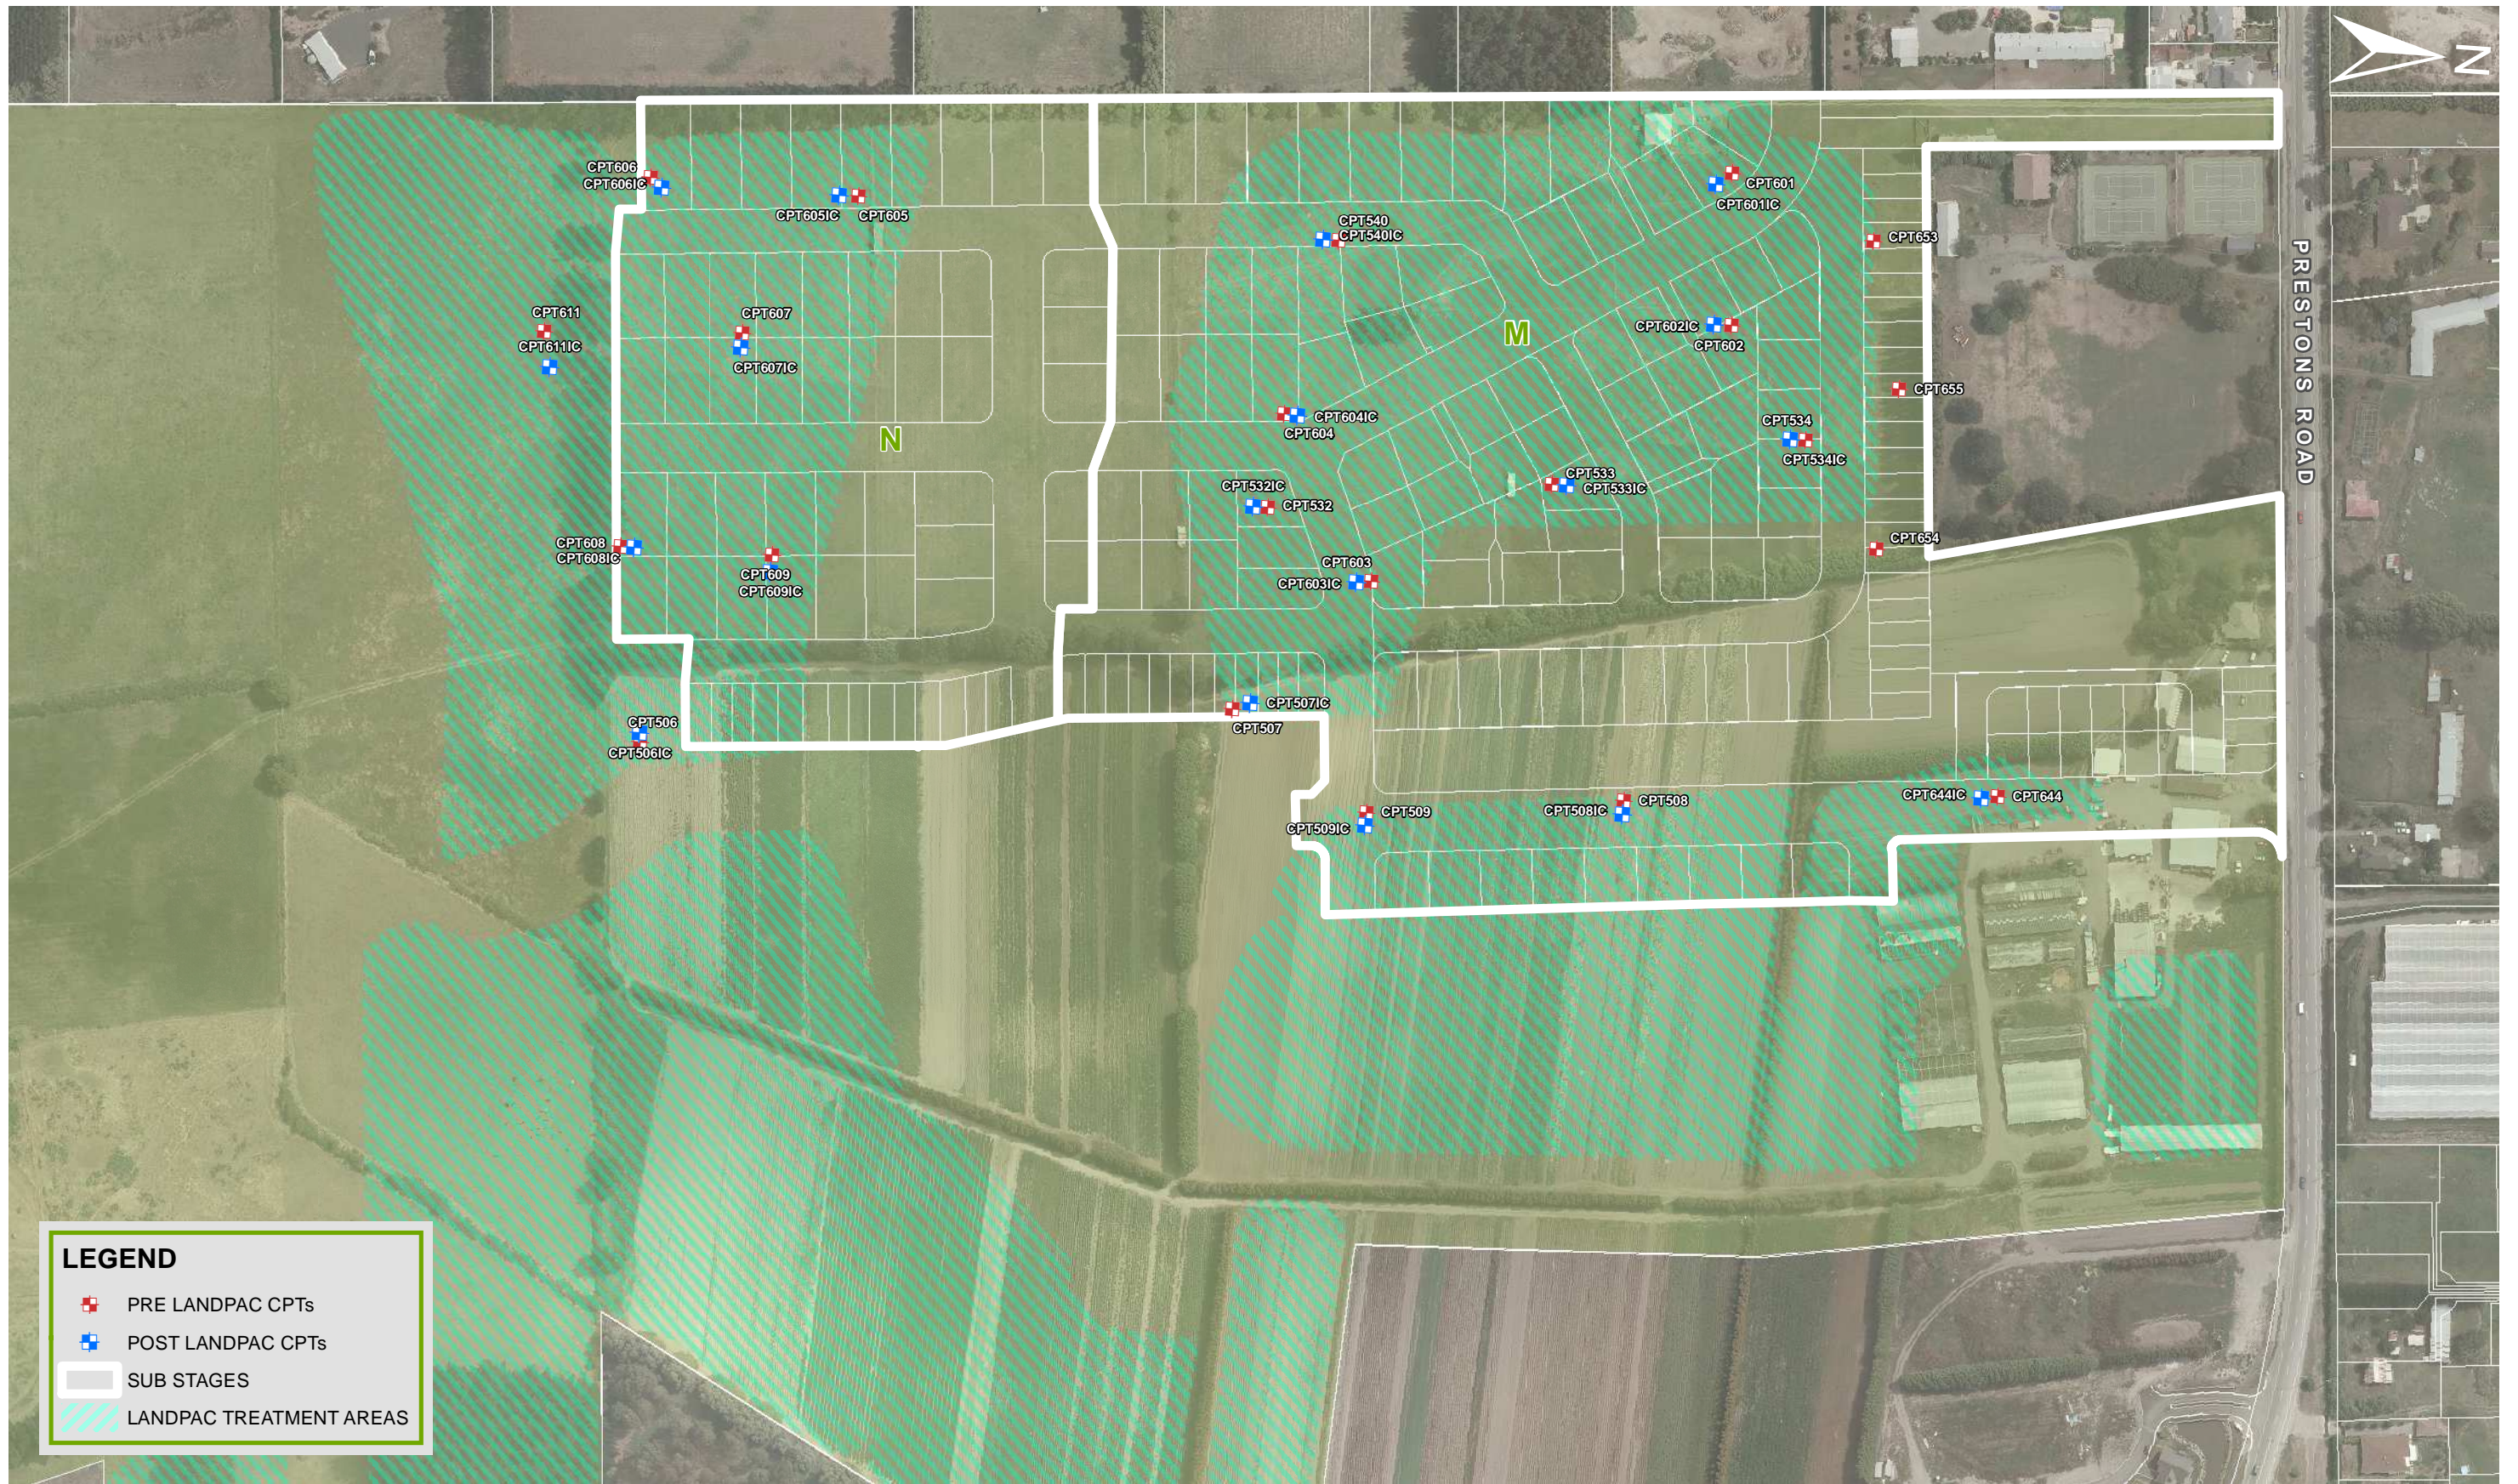

**LEGEND**

- PRE LANDPAC CPTs
- POST LANDPAC CPTs
- ▭ SUB STAGES
- ▨ LANDPAC TREATMENT AREAS



**NOTES** - PROPERTY DATA FROM LINZ  
- AERIAL IMAGE FROM CCC POST 2011 EQ





REV	DATE	REVISION DETAILS	APPROVED
A	03.15	ISSUE	T.BROWNE

DRAWN	DESIGNED
R.Dawson	J.Muirson
CHECKED	
J.Kupec	
APPROVED	
DATE	
T. Browne	March 2015

PROJECT
PRESTONS SOUTH STAGES 1M & 1N
TITLE
GROUND IMPROVEMENT

PROJECT No.	235361
SCALE	AS SHOWN
DRAWING No.	FIG 3
SIZE	A3
REV	A



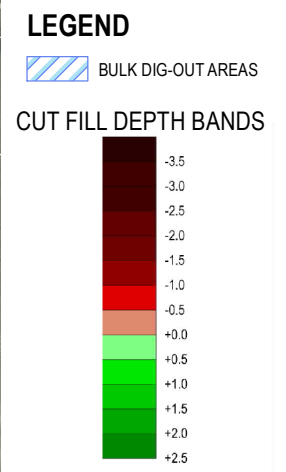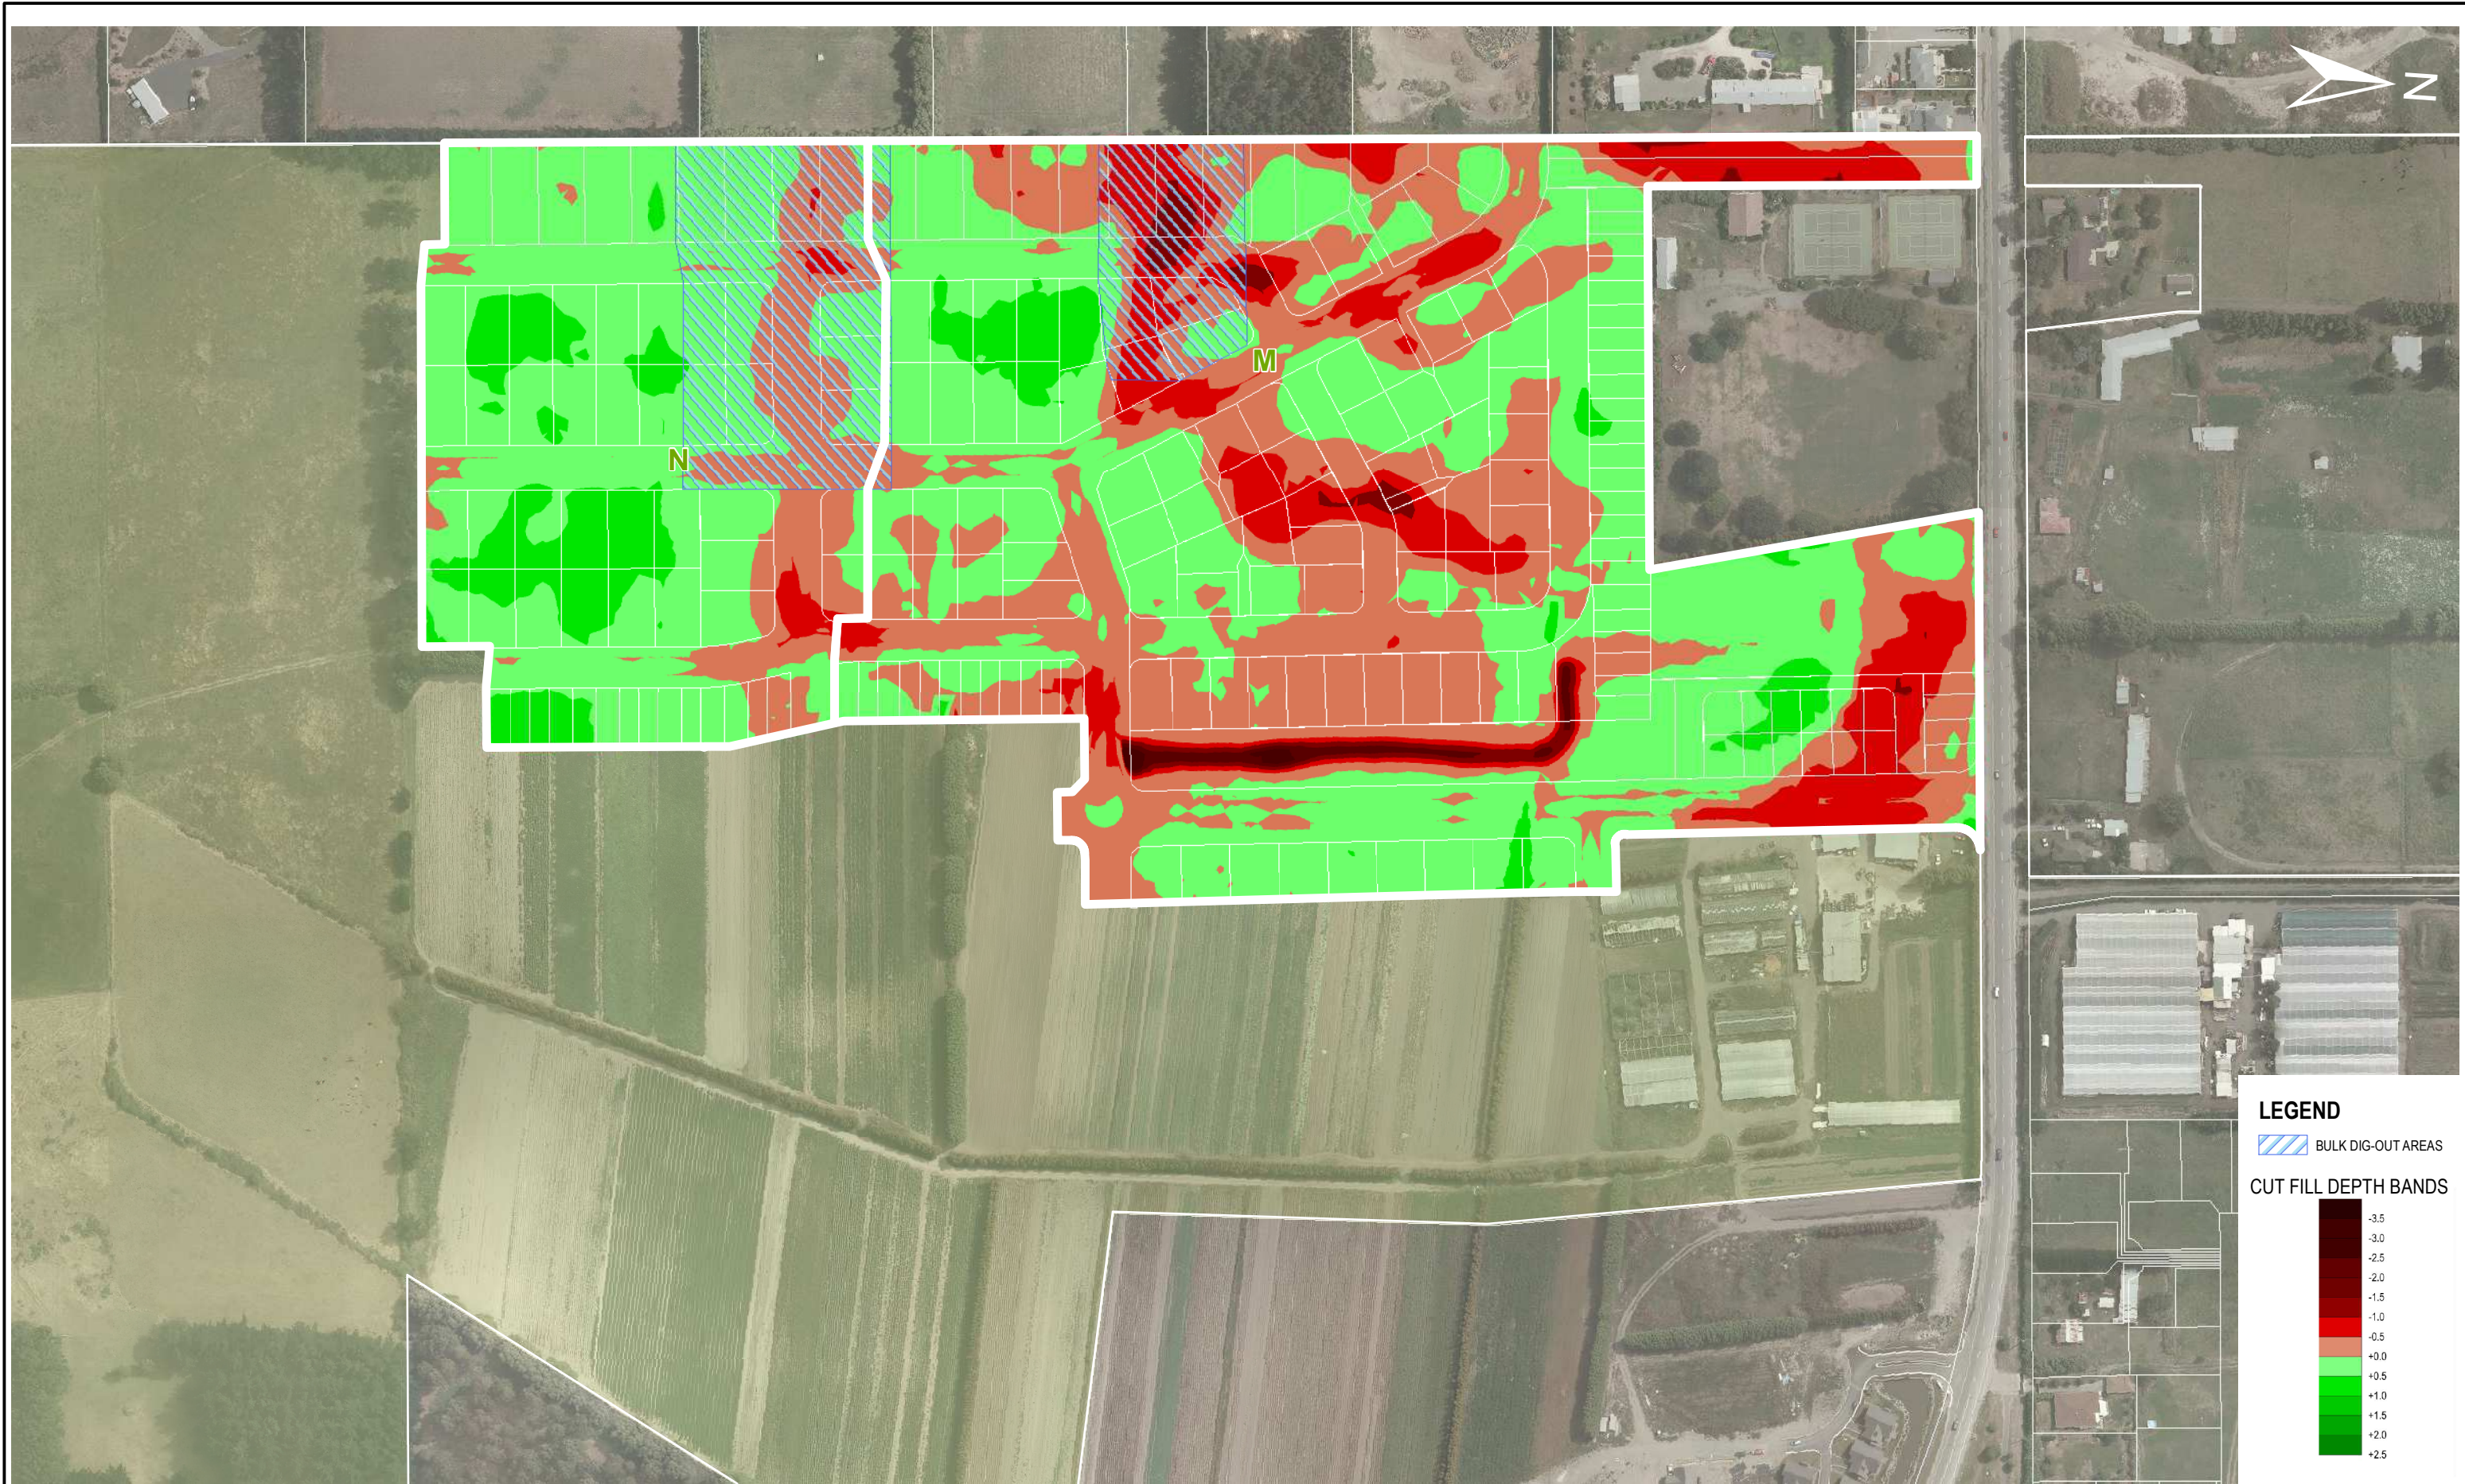

**NOTES** - PROPERTY DATA FROM LINZ  
 - AERIAL IMAGE FROM CCC POST 2011 EQ



REV	DATE	REVISION DETAILS	APPROVED
A	03.15	ISSUE	T.BROWNE

DRAWN	DESIGNED
R.Dawson	J.Muirson
CHECKED	
J.Kupec	
APPROVED	
DATE	
T. Browne	March 2015

PROJECT
PRESTONS SOUTH STAGES 1M & 1N
TITLE
CUT FIL BANDING

PROJECT No.	235361
SCALE	AS SHOWN
SIZE	A3
DRAWING No.	FIG 4
REV	A


Path: P:\223488\GIS\MXD\geotech figs\detailed design\SOUTH STAGE 1 M AND N COMP MAR 2015\FIG 4 CUT FIL BANDING.mxd





**LEGEND**

- NDM LOCATION
- SUB STAGES

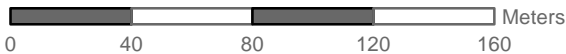

**NOTES** - PROPERTY DATA FROM LINZ  
- AERIAL IMAGE FROM CCC POST 2011 EQ



CLIENT



REV	DATE	REVISION DETAILS	APPROVED
A	03.15	ISSUE	T.BROWNE

DRAWN	DESIGNED
R.Dawson	J.Muirson
CHECKED	
J.Kupec	
APPROVED	
DATE	
T. Browne	March 2015

PROJECT
PRESTONS SOUTH STAGES 1M & 1N
TITLE
NDM TESTING LOCATIONS

PROJECT No.	235361
SCALE	AS SHOWN
DRAWING No.	FIG 5
SIZE	A3
REV	A





**LEGEND**

- POST FILL CPT
- VERIFICATION CPT
- ▭ SUB STAGES



**NOTES** - PROPERTY DATA FROM LINZ  
- AERIAL IMAGE FROM CCC POST 2011 EQ



REV	DATE	REVISION DETAILS	APPROVED
A	03.15	ISSUE	T.BROWNE

DRAWN	DESIGNED
R.Dawson	J.Muirson
CHECKED	
J.Kupec	
APPROVED	
DATE	
T. Browne	March 2015

PROJECT
PRESTONS SOUTH STAGES 1M & 1N
TITLE
POST EARTHWORKS CPTS

PROJECT No.	235361
SCALE	AS SHOWN
DRAWING No.	FIG 6
SIZE	A3
REV	A