SUBJECT TO FINAL COUNCIL APPROVAL

SHEET LAYOUT:

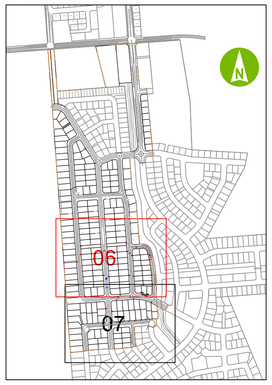


LEGEND:

- STAGE BOUNDARY
- STAGE O BOUNDARIES
- VACUUM MAINS PE100 PN12.5 SDR13.6
  - 90OD
  - 125OD
  - 160OD
  - 200OD
  - 250OD
  - 280OD
- FLOVAC VACUUM INTERFACE VALVE — VX-XX
- ECCENTRIC REDUCER
- DIVISION VALVE
- MAINTENANCE RISER
- VACUUM SEWER VENT INTAKE PILLAR
- CONCRETE CAPPING
- LIFT

*This AS BUILT drawing has been prepared based on Information provided by the contractor.*

VAC MAIN CAPPED AT CHAINAGE 370m

DS 11.81
US 12.11

VAC MAIN 5-3.1

DS 11.66
US 11.99

DS 11.60
US 11.92

DS 11.64
US 11.95

VC-13

VA-11

VB-10

VB-11

VA-12

VC-14

VG-01

DS 11.83
US 12.13

VAC MAIN 5-2

VAC MAIN 5-0

VAC MAIN 5-3

VA-13

VC-15

VA-14

VC-16

VG-02

HEAD LOSS 1.962m

DS 11.49
US 11.85

HEAD LOSS 1.772m

DS 11.31
US 11.62

ROAD T2

ROAD S2

ROAD T1

ROAD N1

VH-01

VI-02

VI-04

DS 11.59
US 11.99

DS 11.38
US 11.70

DOUBLE CROSS FALL

SINGLE CROSS FALL

SCALE 1:500

aurecon
www.aurecongroup.com

CLIENT

CDL LAND
NEW ZEALAND LIMITED

| REV | DATE | REVISION DETAILS | APPROVED |
|---|---|---|---|
| 1 | 18/07/16 | AS BUILT | K.ASHBY |

| DRAWN | DESIGNED |
|---|---|
| J.WARLICH-KOOLE | C.CHOW |

CHECKED: J.WHITE

APPROVED: *K.ASHBY* DATE *10/08/16*

K.ASHBY

PROJECT: PRESTONS PARK

TITLE: PRESTONS SOUTH - STAGE 1 - SUBSTAGE O
VACUUM SEWER AS BUILT LAYOUT PLAN
SHEET 1 OF 2

AS BUILT

PROJECT No.: 235361

| SCALE | SIZE |
|---|---|
| 1:500 | A1 |

| DRAWING No. | REV |
|---|---|
| AB-PS-S1-VS-06 | 1 |