



Appendix A

Figures

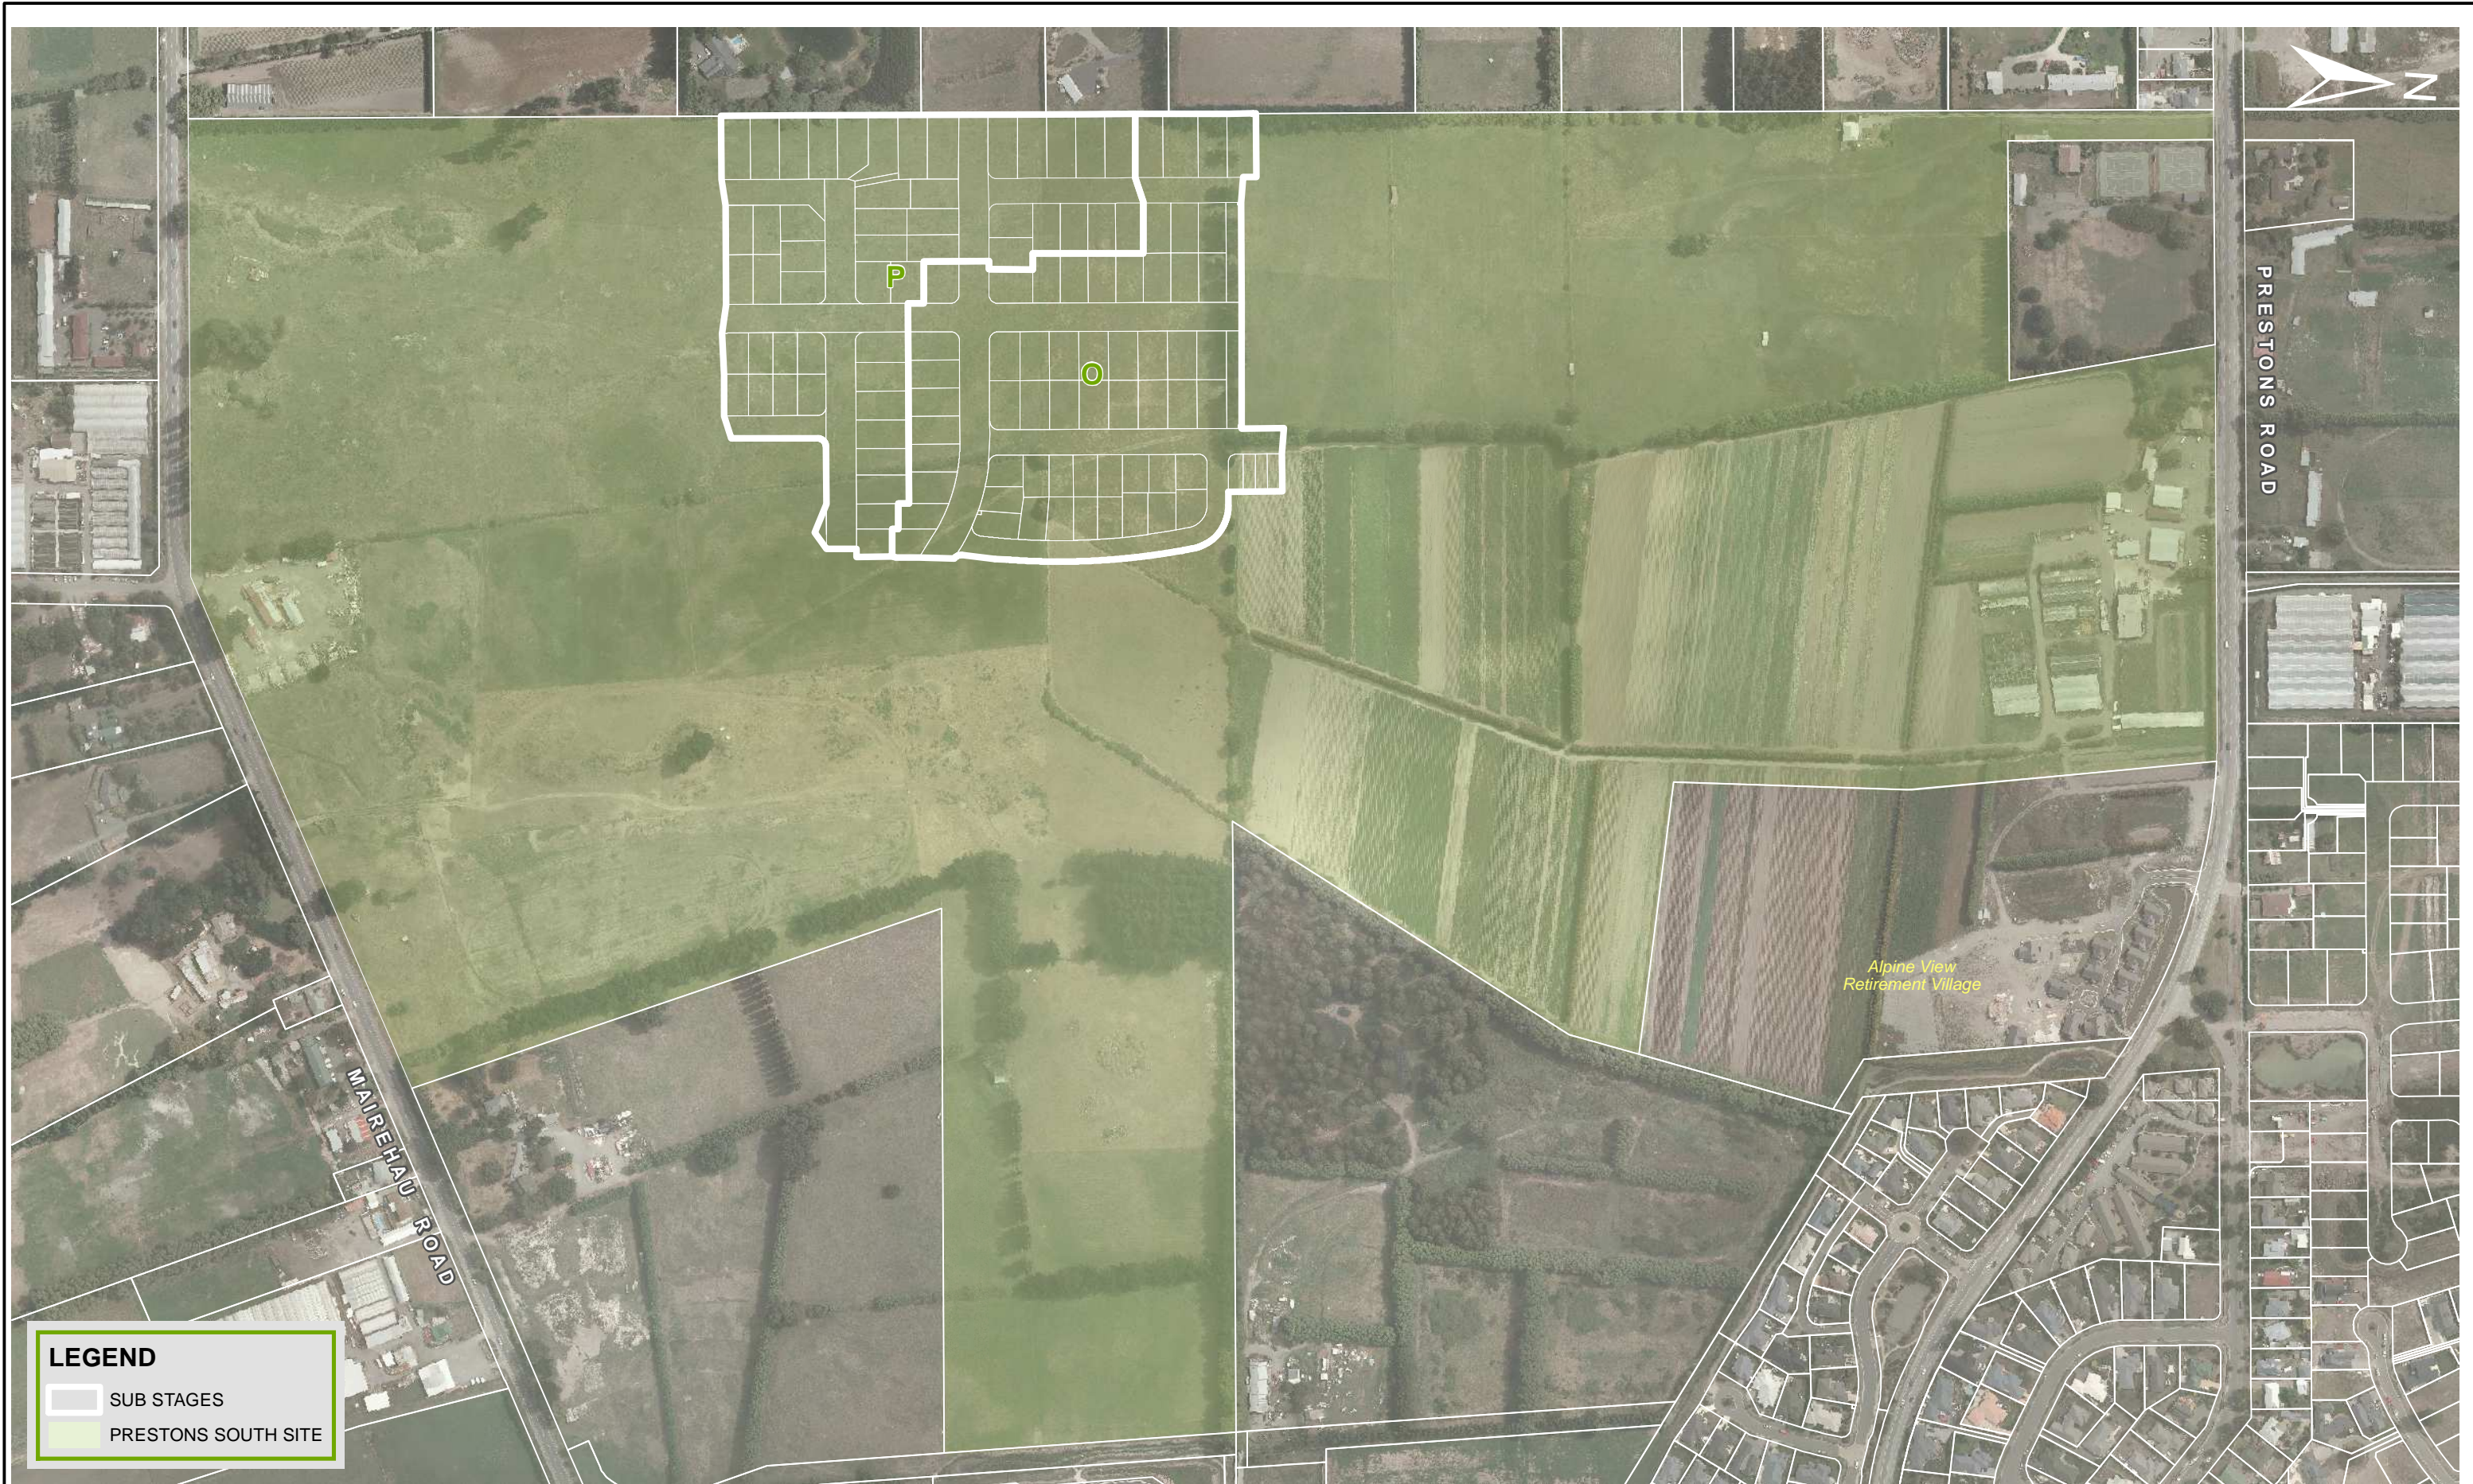

LEGEND

- SUB STAGES
- PRESTONS SOUTH SITE

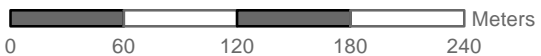

NOTES - PROPERTY DATA FROM LINZ
- AERIAL IMAGE FROM CCC POST 2011 EQ




REV	DATE	REVISION DETAILS	APPROVED
A	04.16	ISSUE	T.BROWNE

DRAWN	DESIGNED
R.Dawson	J.Muirson
CHECKED	
J.Kupec	
APPROVED	
DATE	
T. Browne	April 2016

PROJECT
PRESTONS SOUTH STAGES 10 & 1P
TITLE
SITE LOCATION PLAN


PROJECT No.	235361
SCALE	AS SHOWN
DRAWING No.	FIG 1
SIZE	A3
REV	A

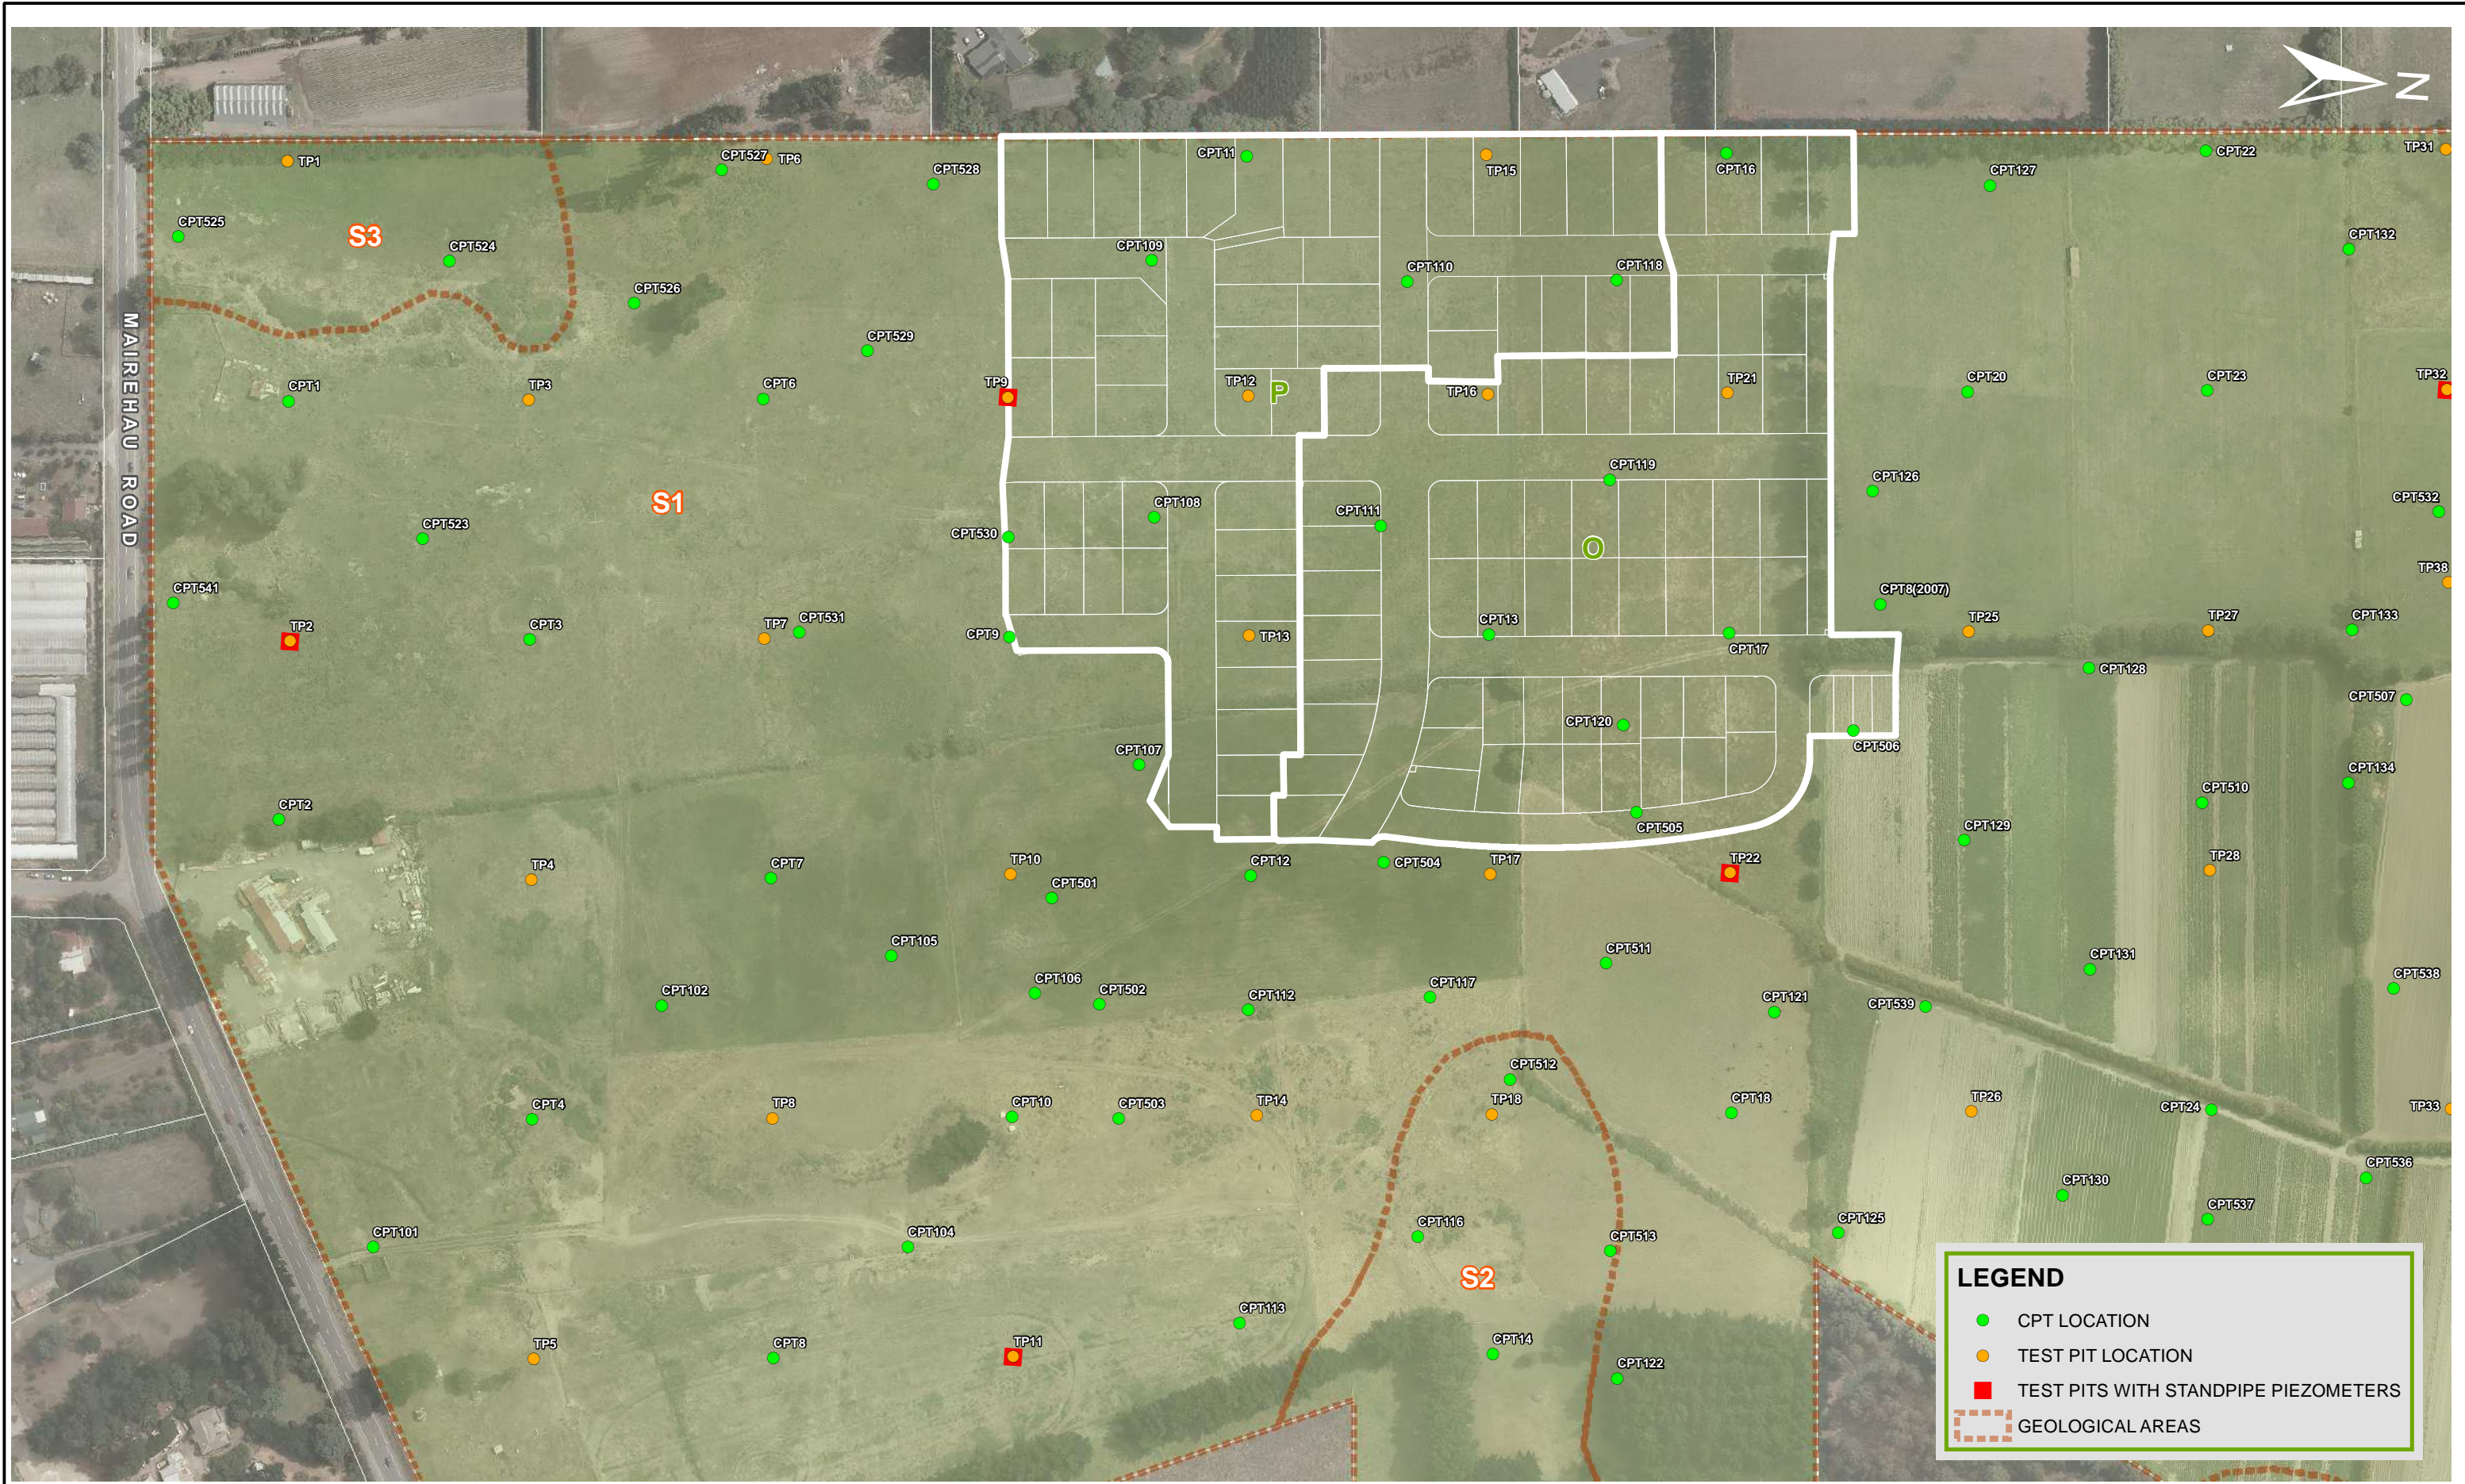

LEGEND

- CPT LOCATION
- TEST PIT LOCATION
- TEST PITS WITH STANDPIPE PIEZOMETERS
- GEOLOGICAL AREAS

NOTES - PROPERTY DATA FROM LINZ
 - AERIAL IMAGE FROM CCC POST 2011 EQ

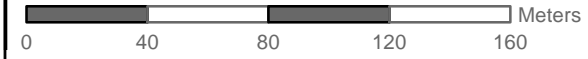


REV	DATE	REVISION DETAILS	APPROVED
A	04.16	ISSUE	T.BROWNE

DRAWN	DESIGNED
R.Dawson	J.Muirson
CHECKED	
J.Kupec	
APPROVED	
DATE	
T. Brown April 2016	

PROJECT
PRESTONS SOUTH STAGES 10 & 1P
TITLE
PREVIOUS INVESTIGATIONS

PROJECT No.	235361
SCALE	AS SHOWN
DRAWING No.	FIG 2
SIZE	A3
REV	A

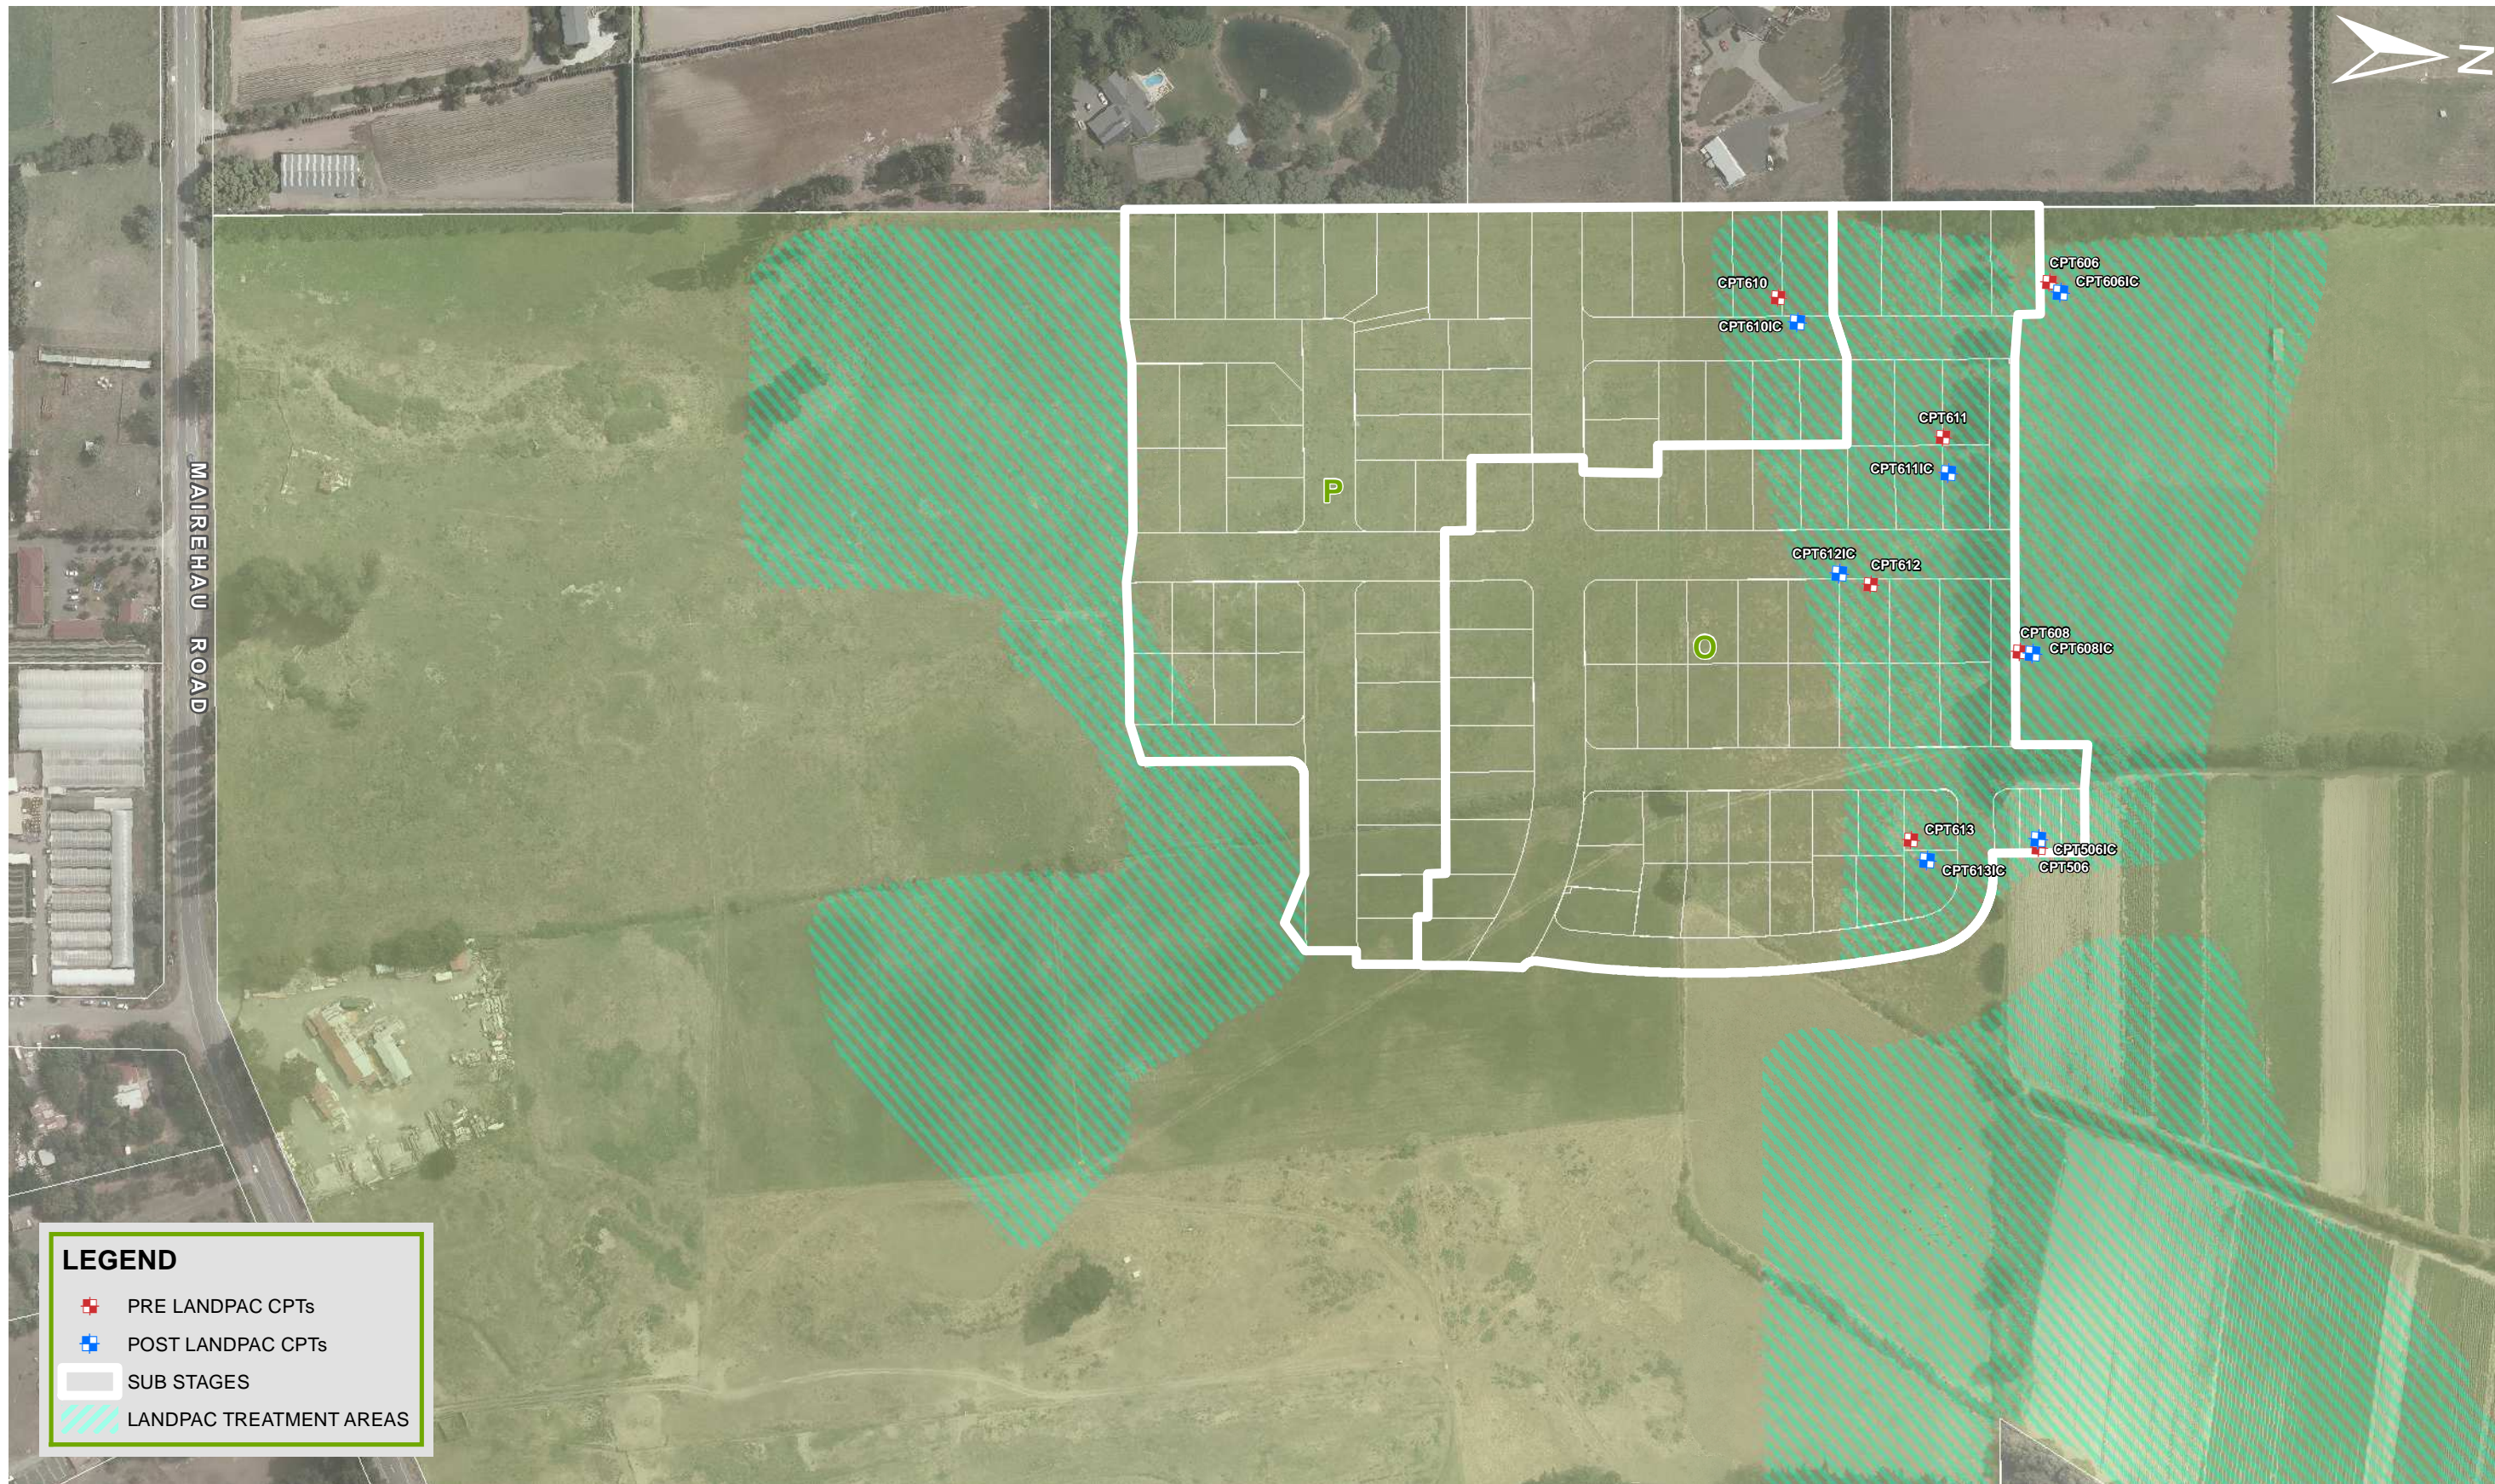

LEGEND

- + PRE LANDPAC CPTs
- + POST LANDPAC CPTs
- ▭ SUB STAGES
- ▨ LANDPAC TREATMENT AREAS



NOTES - PROPERTY DATA FROM LINZ
- AERIAL IMAGE FROM CCC POST 2011 EQ




REV	DATE	REVISION DETAILS	APPROVED
A	04.16	ISSUE	T.BROWNE


DRAWN	DESIGNED
R.Dawson	J.Muirson
CHECKED	
J.Kupec	
APPROVED	
DATE	
T. Browne	April 2016

PROJECT
PRESTONS SOUTH STAGES 10 & 1P
TITLE
GROUND IMPROVEMENT

PROJECT No.	235361
SCALE	AS SHOWN
DRAWING No.	FIG 3
SIZE	A3
REV	A

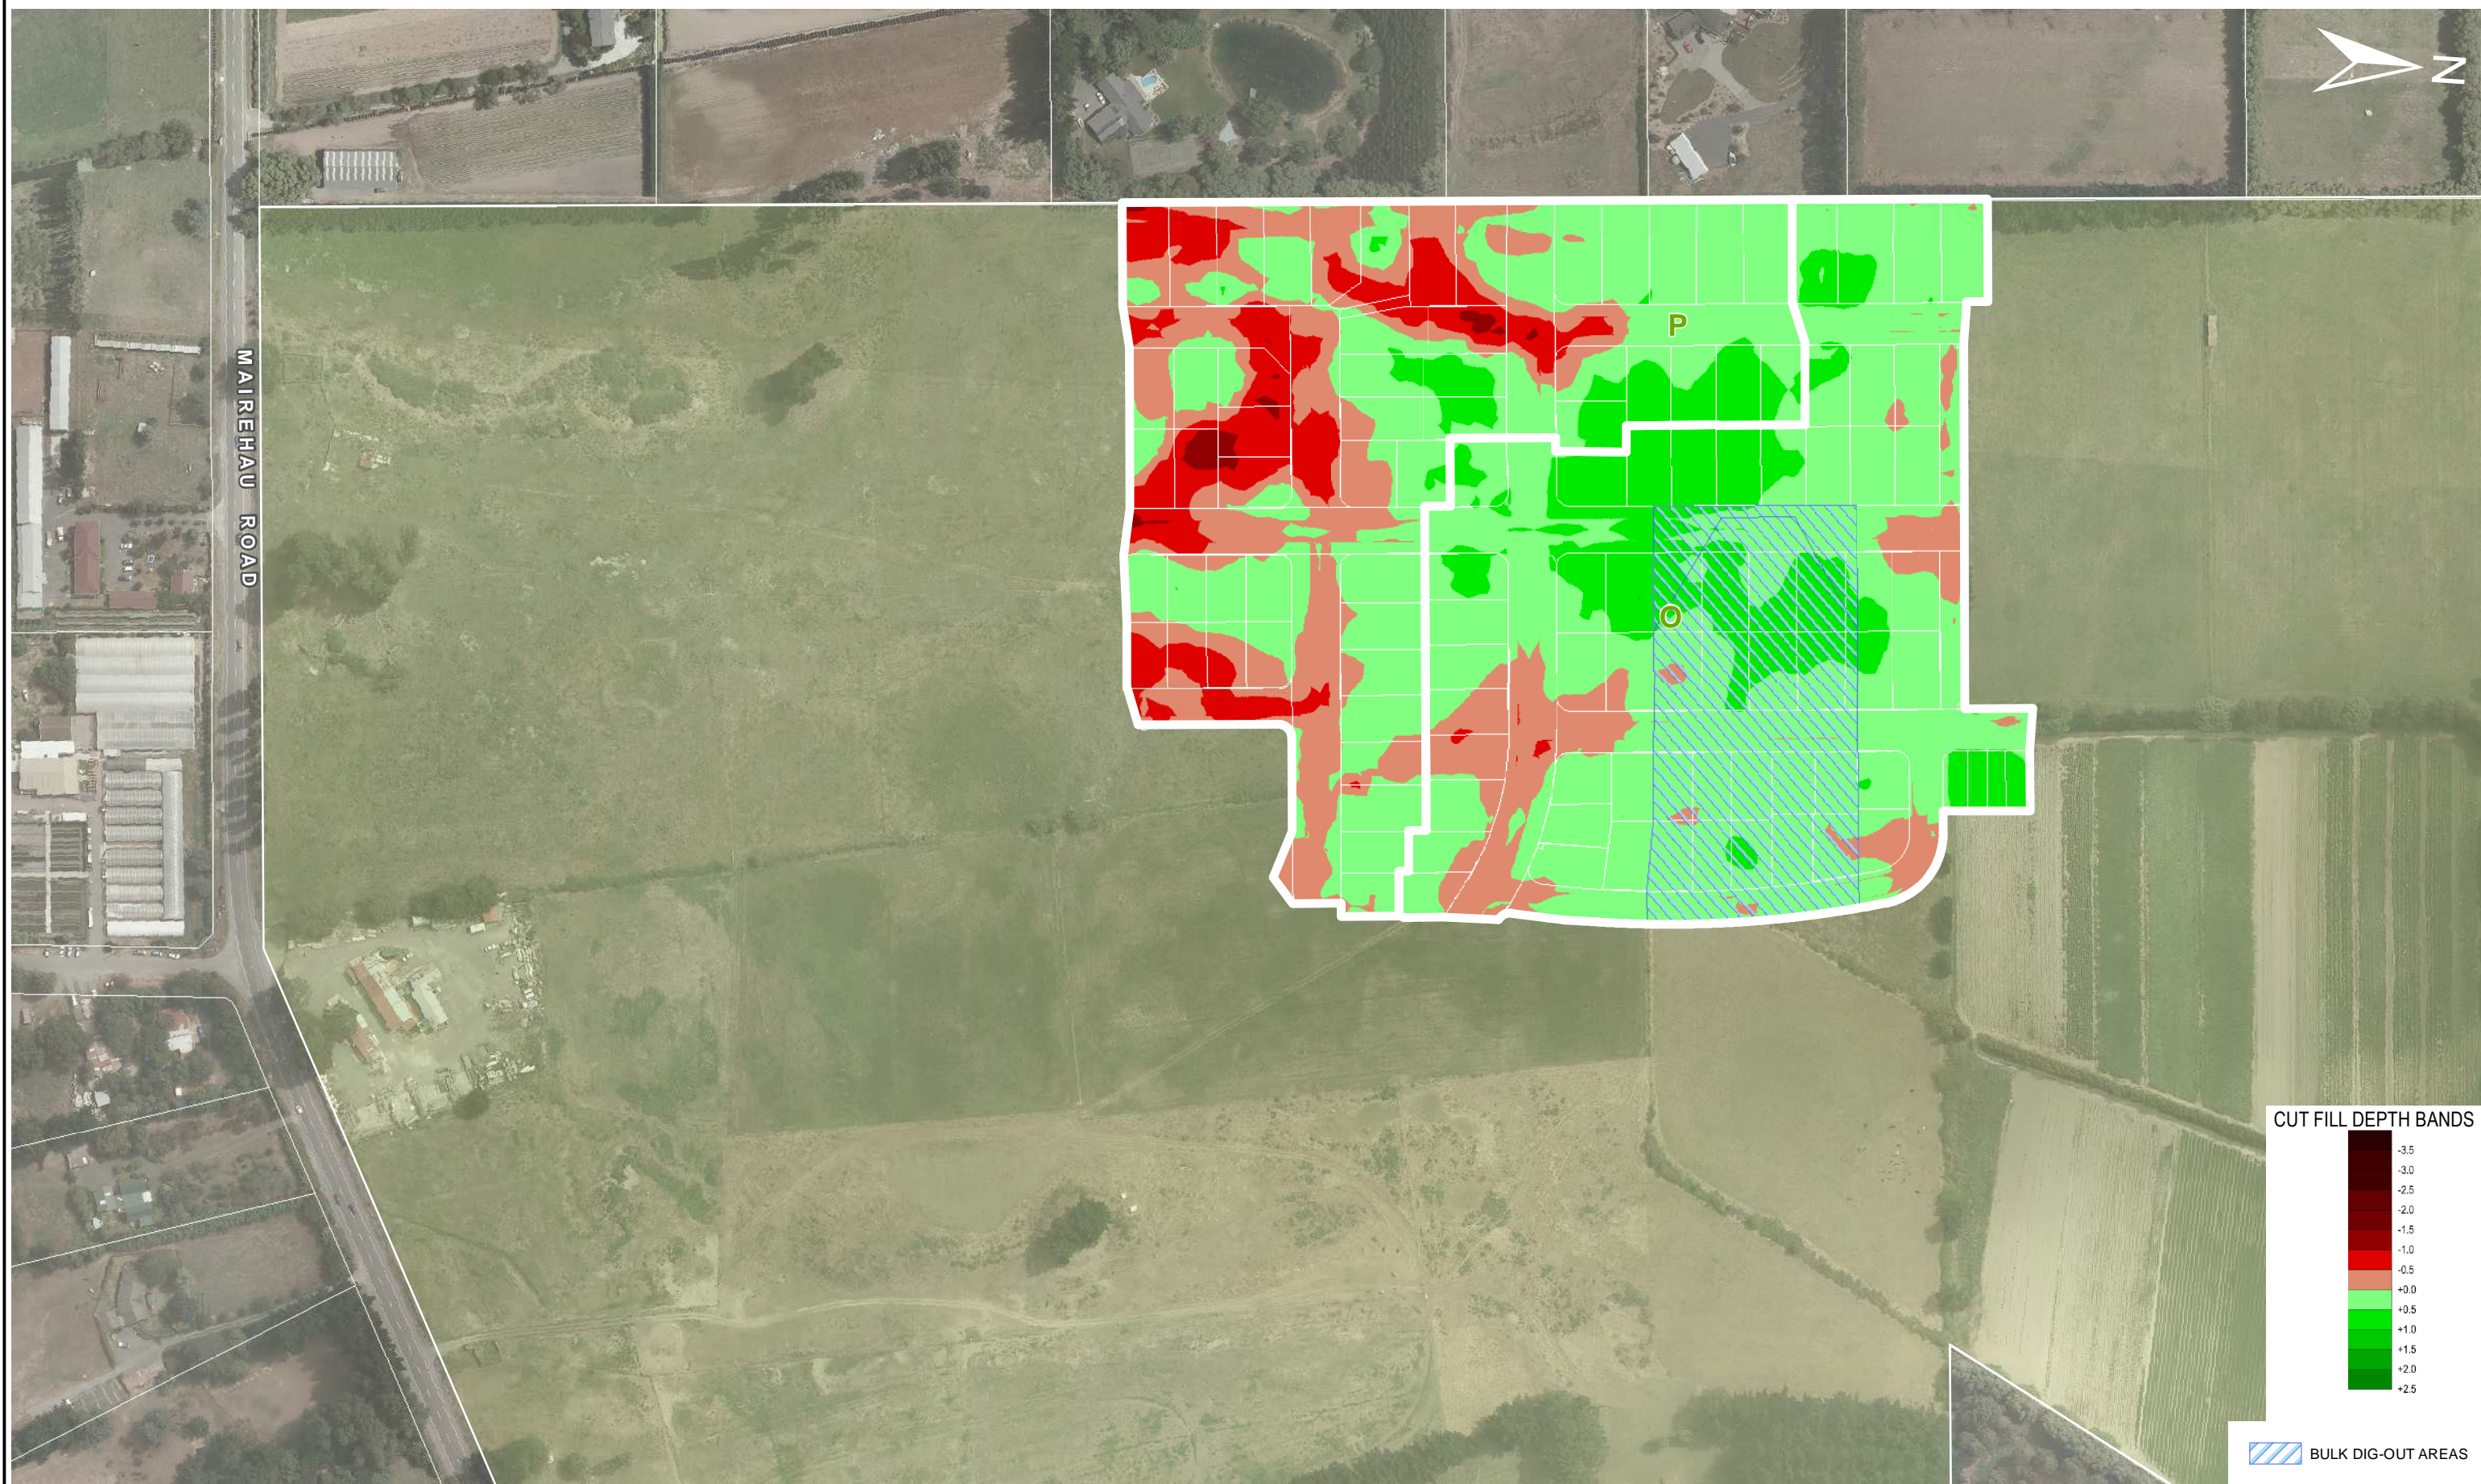

CUT FILL DEPTH BANDS

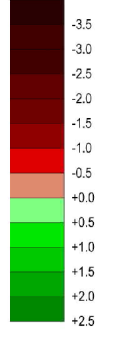

BULK DIG-OUT AREAS



NOTES - PROPERTY DATA FROM LINZ
 - AERIAL IMAGE FROM CCC POST 2011 EQ



REV	DATE	REVISION DETAILS	APPROVED
A	04.16	ISSUE	T.BROWNE

DRAWN	DESIGNED
R.Dawson	J.Muirson
CHECKED	
J.Kupec	
APPROVED	
DATE	
T. Browne	April 2016


PROJECT
PRESTONS SOUTH STAGES 10 & 1P
TITLE
CUT FIL BANDING

PROJECT No.	235361
SCALE	AS SHOWN
DRAWING No.	FIG 4
SIZE	A3
REV	A



LEGEND

- ◆ GRAVEL EMBANKMENT NDM TEST LOCATION
- ◆ NDM LOCATION
- ▭ SUB STAGES

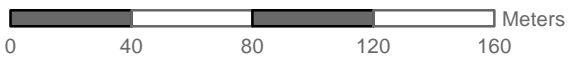

NOTES - PROPERTY DATA FROM LINZ
- AERIAL IMAGE FROM CCC POST 2011 EQ




REV	DATE	REVISION DETAILS	APPROVED
A	04.16	ISSUE	T.BROWNE

DRAWN	DESIGNED
R.Dawson	J.Muirson
CHECKED	
J.Kupec	
APPROVED	
DATE	
T. Browne	April 2016


PROJECT
PRESTONS SOUTH STAGES 10 & 1P
TITLE
NDM TESTING LOCATIONS

PROJECT No.	235361
SCALE	AS SHOWN
DRAWING No.	FIG 5
SIZE	A3
REV	A

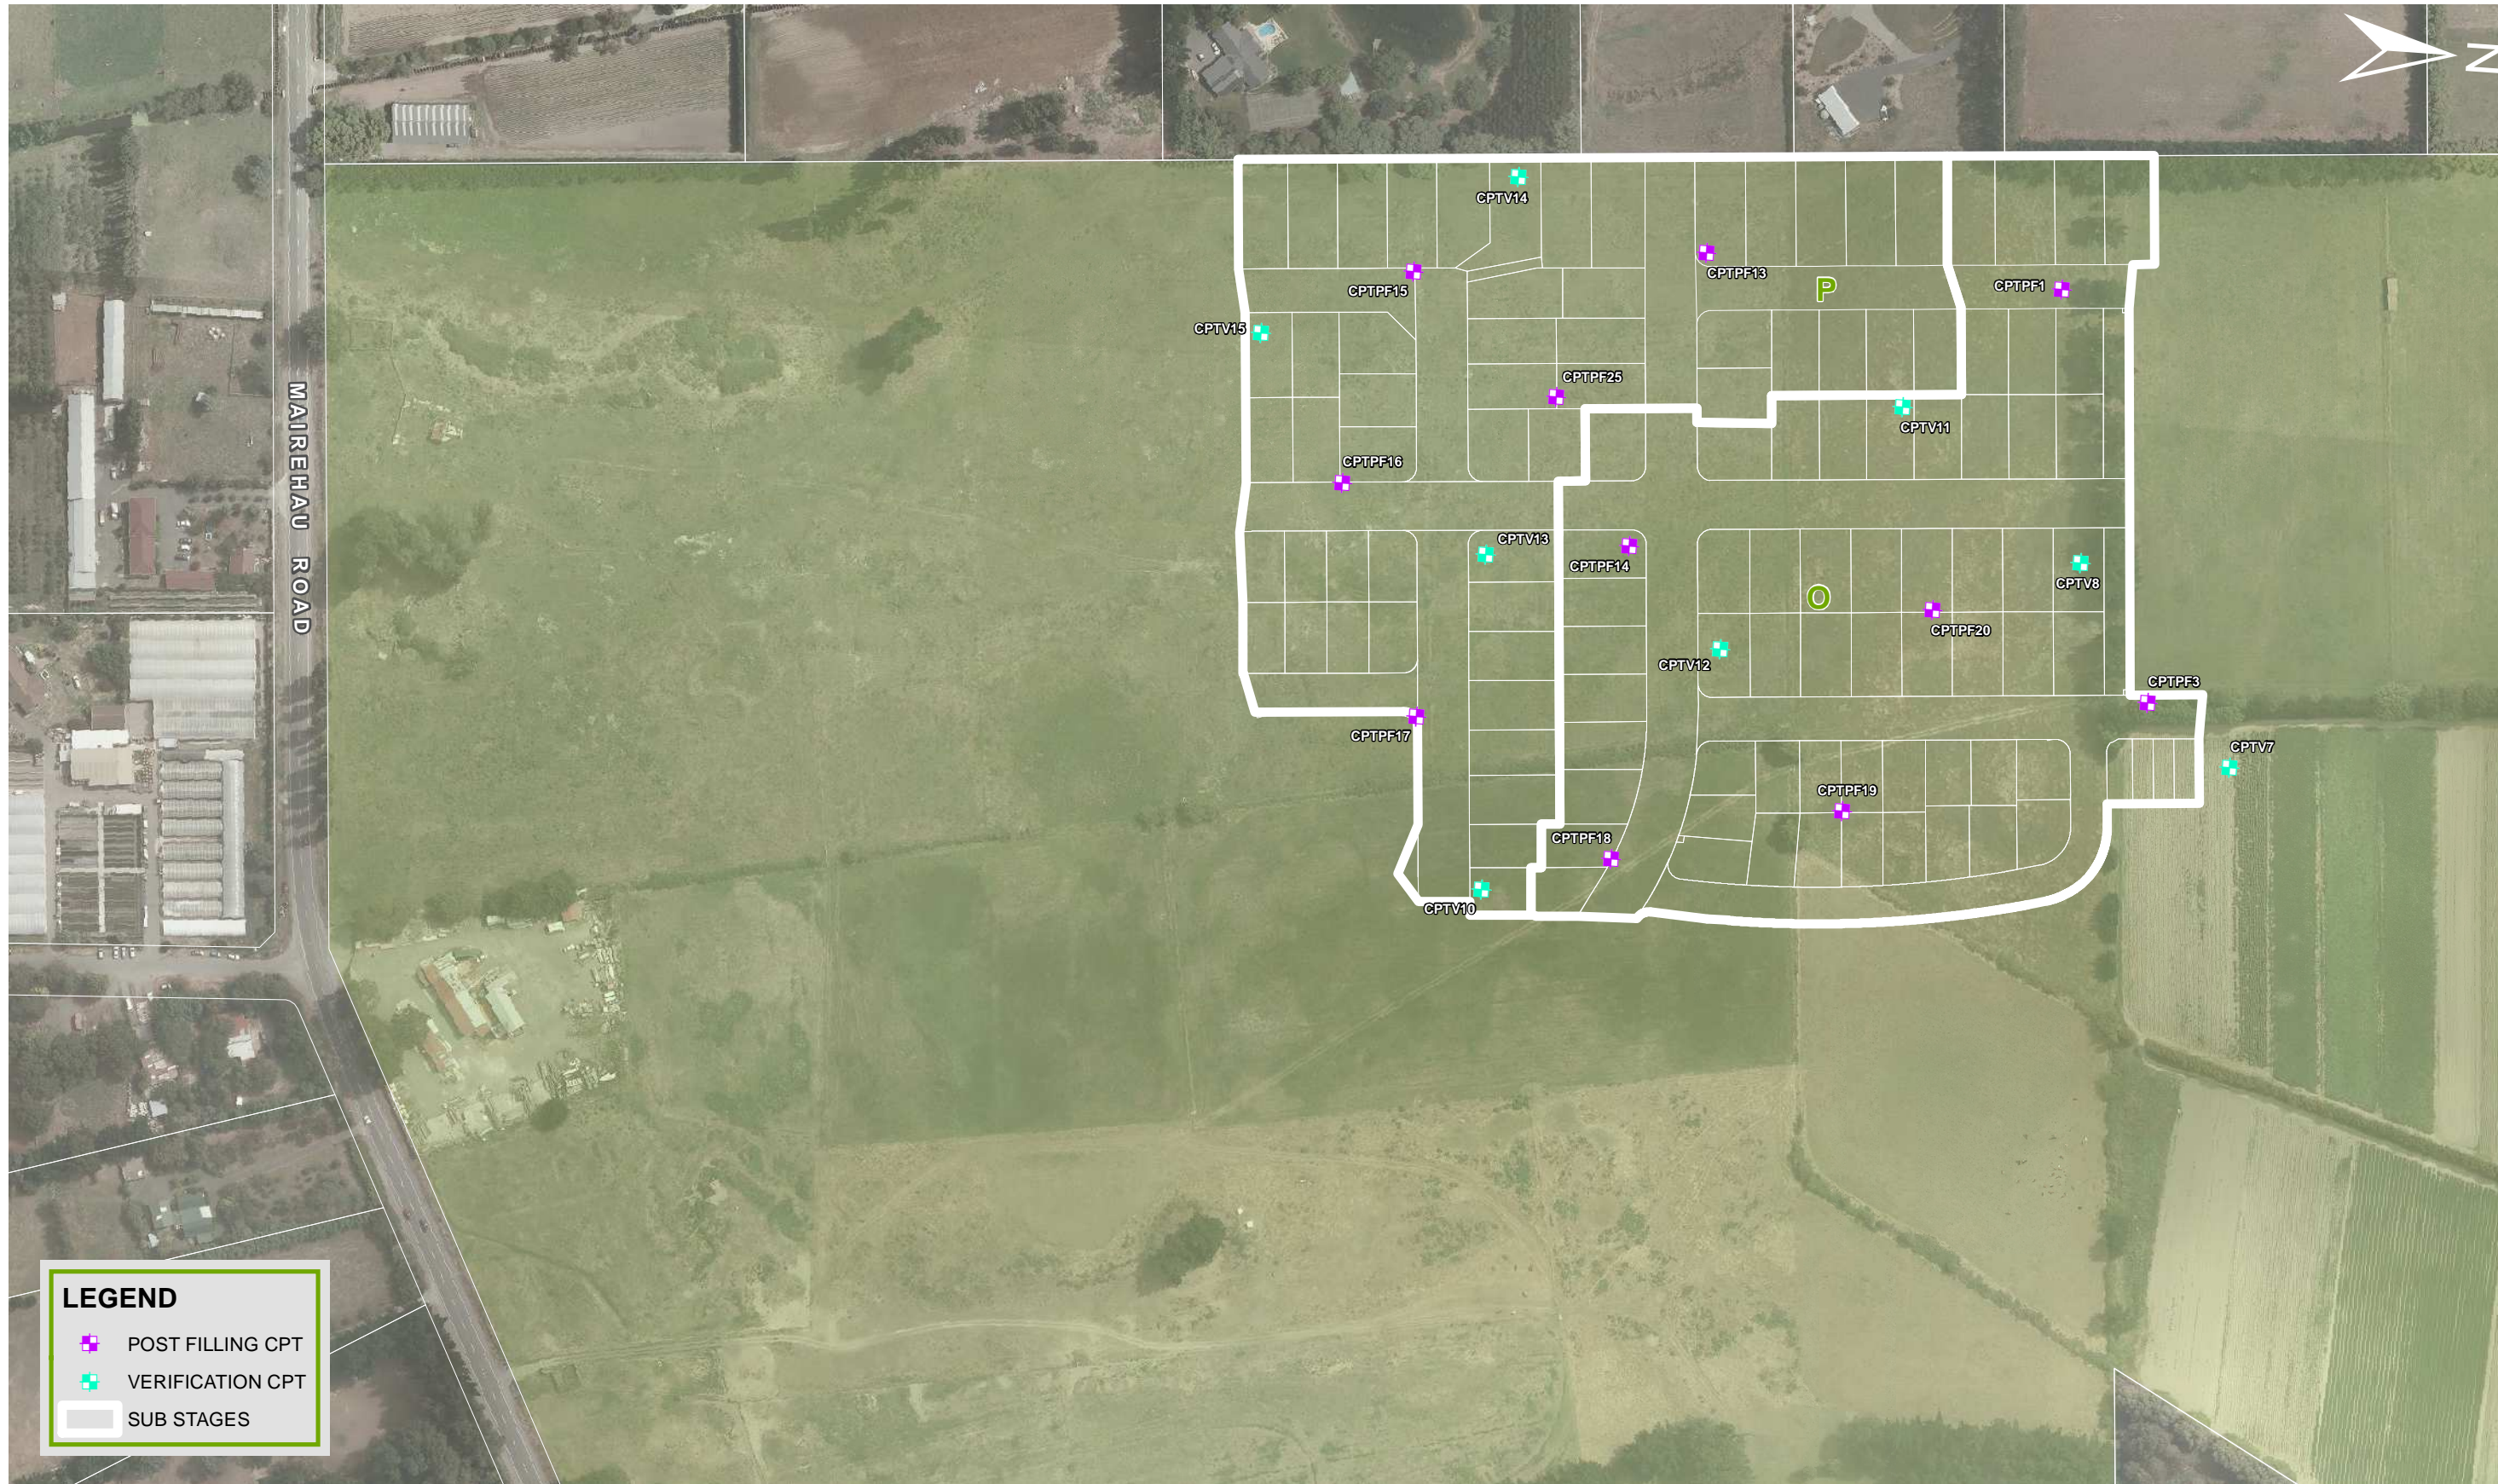

LEGEND

- POST FILLING CPT
- VERIFICATION CPT
- SUB STAGES

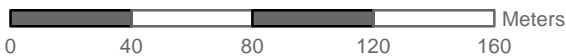

NOTES - PROPERTY DATA FROM LINZ
- AERIAL IMAGE FROM CCC POST 2011 EQ




REV	DATE	REVISION DETAILS	APPROVED
A	04.16	ISSUE	T.BROWNE

DRAWN	DESIGNED
R.Dawson	J.Muirson
CHECKED	
J.Kupec	
APPROVED	
DATE	
T. Browne	April 2016


PROJECT
PRESTONS SOUTH STAGES 10 & 1P
TITLE
POST EARTHWORKS CPTS

PROJECT No.	235361
SCALE	AS SHOWN
DRAWING No.	FIG 6
SIZE	A3
REV	A

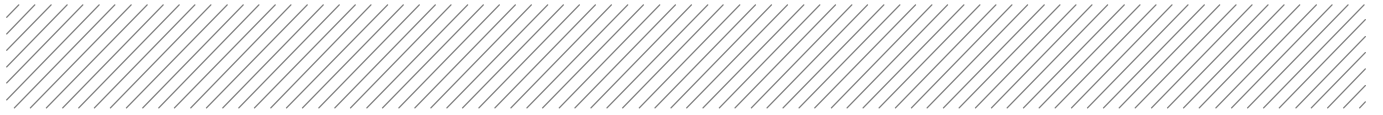

Appendix B

Landpac CIR

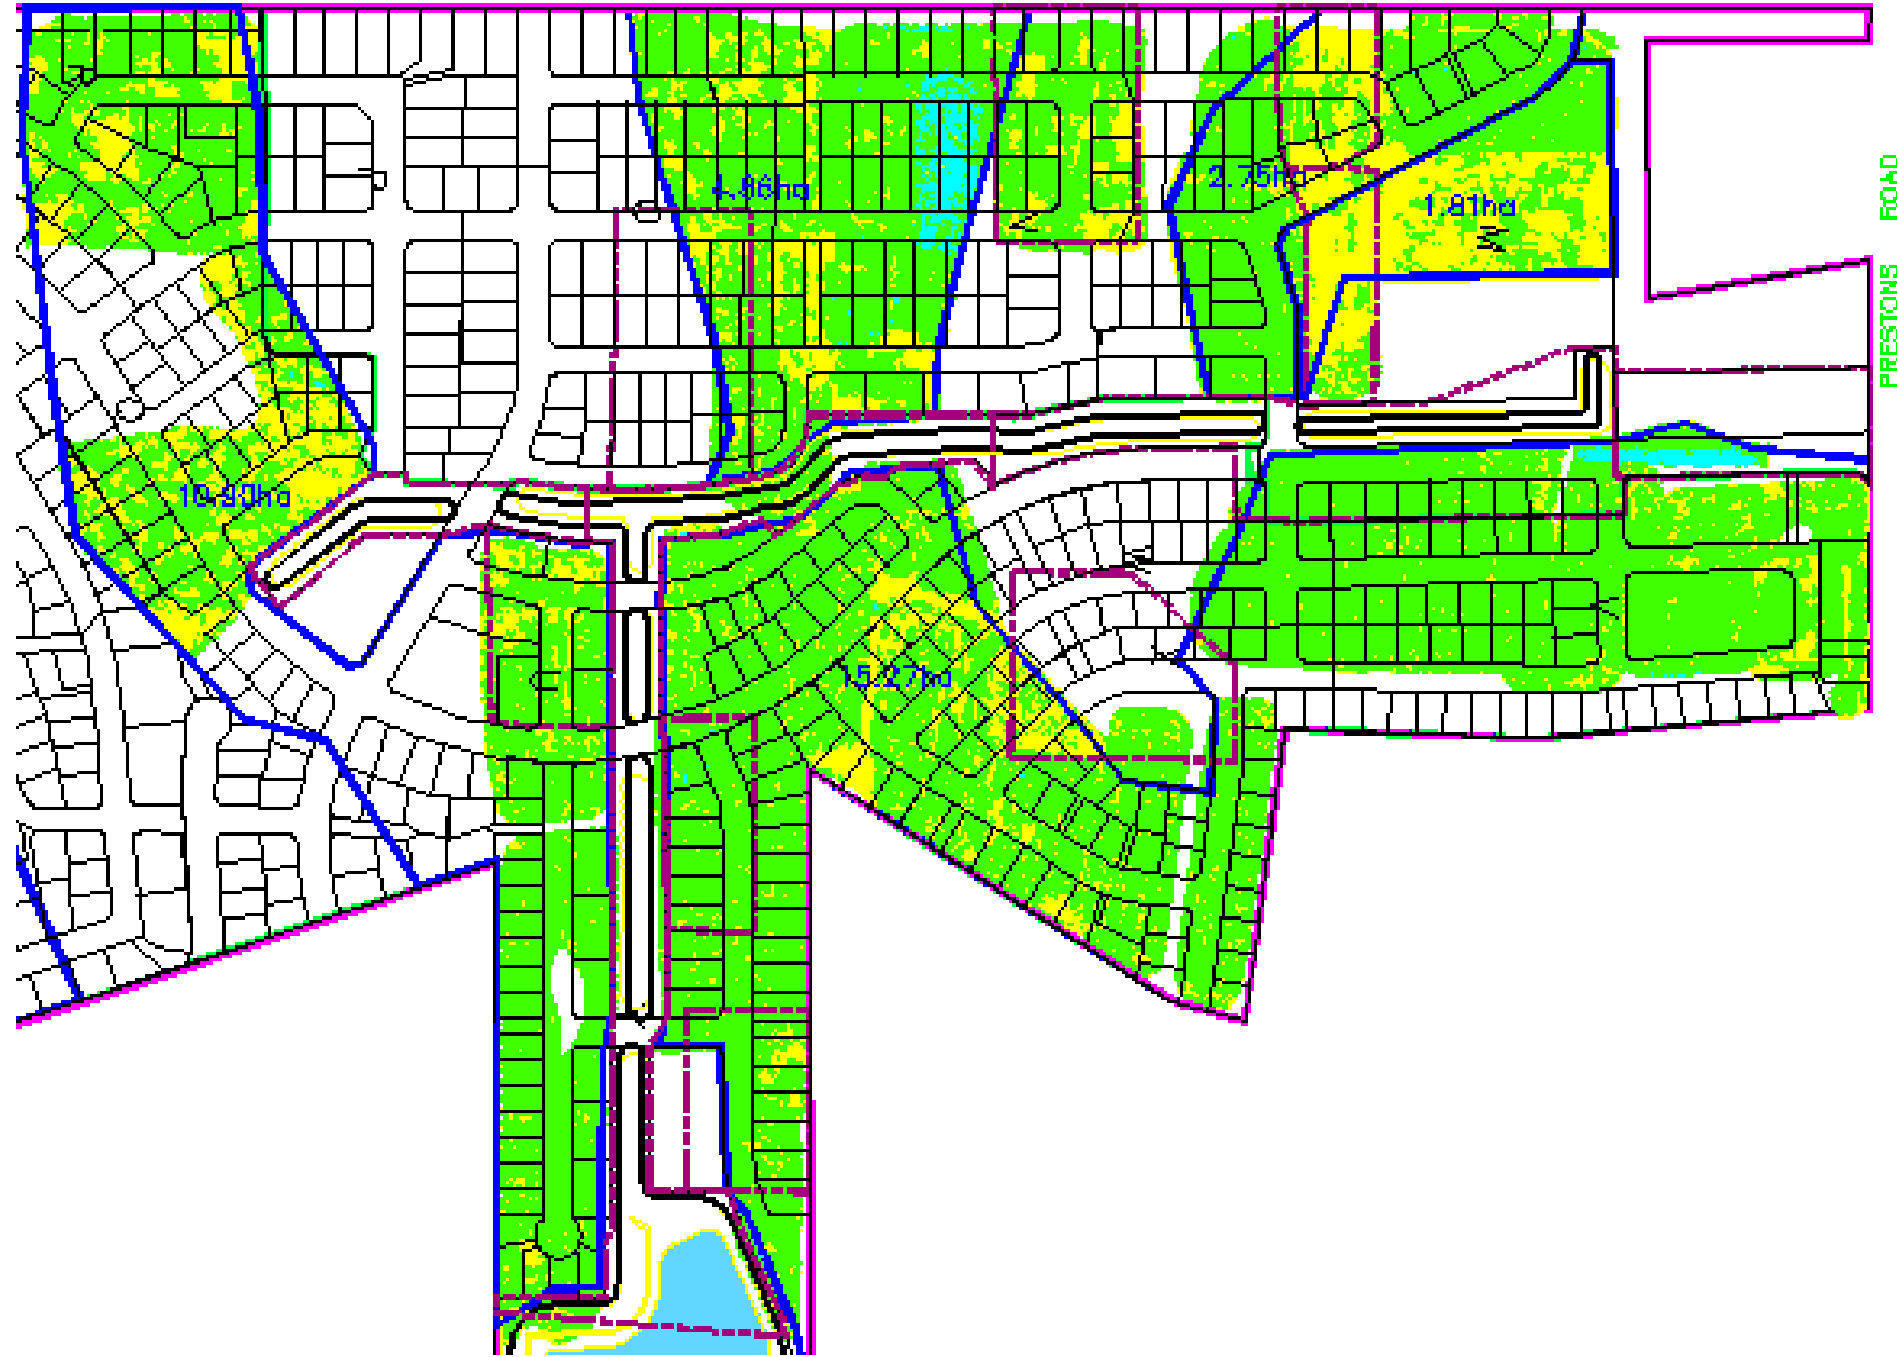

CIR SOIL RESPONSE

- **Low**
- **Medium**
- **High**
- **Very High**

Notes:

The CIR plot indicates the relative soil response to the dynamic loads imposed by the impact drums. The plot is derived from the recorded deceleration of the impact drums and the GPS locations of each impact point. High response values are typically a function of the sub-grade stiffness to a depth of the strain induced by the impact drums. The low and medium response values can be influenced by near surface soil conditions and do not necessarily indicate weaker sub-grade stiffness to a comparative depth. The low and medium response areas should be further investigated by a geotechnical engineer to confirm the suitability of the sub-grade.



PO BOX 132, Seven Hills, NSW 1730
(02) 9838 7044; 1300 237 045

Drawn: SD Date: 08/11/2015
Ckd: SD Date: 10/11/2015

This document is subject to the copyright of Landpac Technologies and its contents should not be used without written permission from Landpac


Project:
PRESTONS SOUTH

Drawing Title
INITIAL CIR (Soil Response) Plot

Drg. No: Prestons-028

REV-A



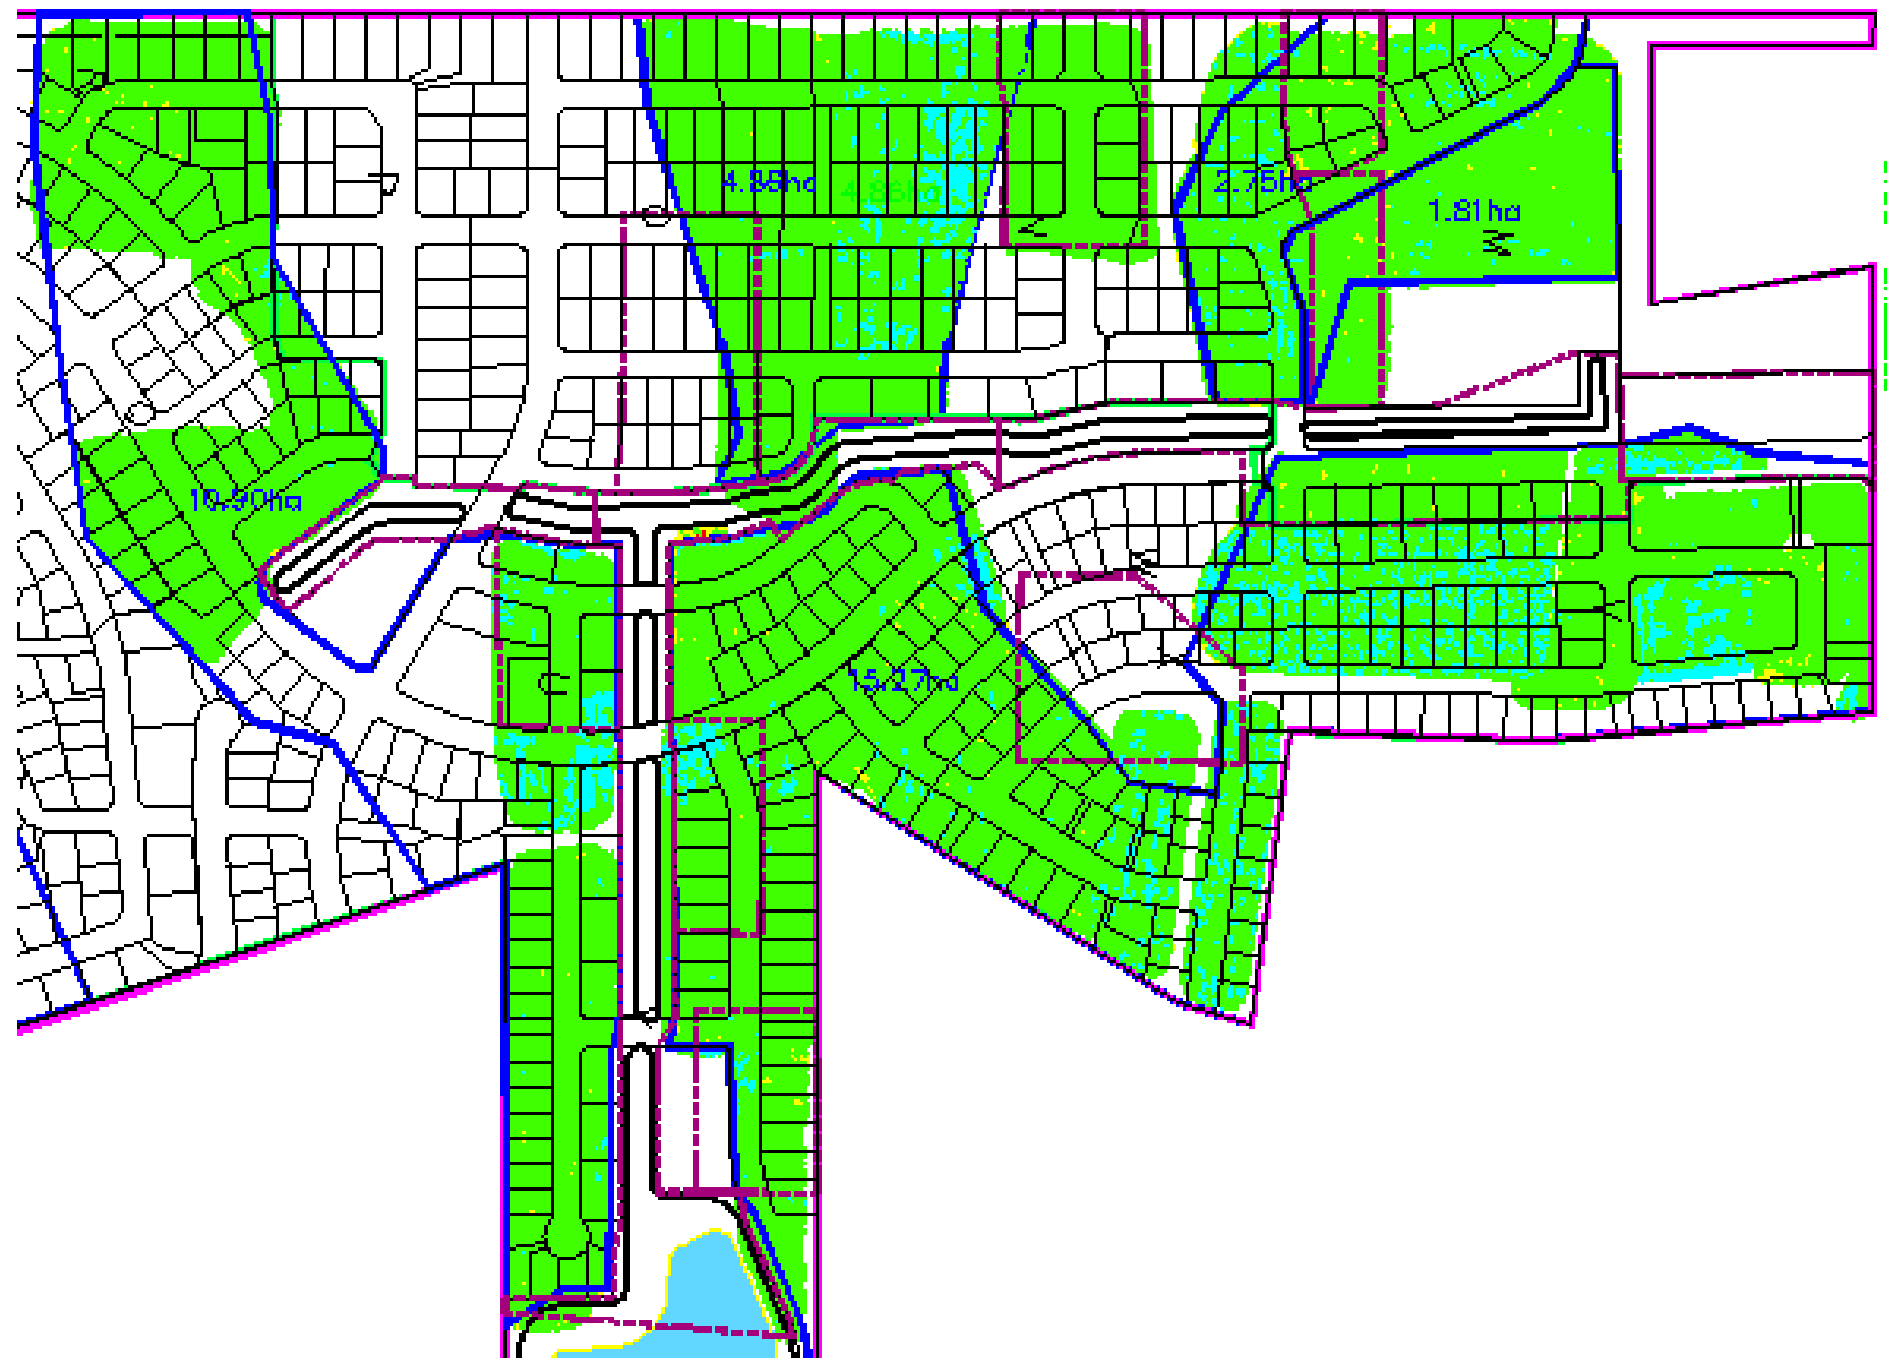

CIR SOIL RESPONSE

- **Low**
- **Medium**
- **High**
- **Very High**

Notes:

The CIR plot indicates the relative soil response to the dynamic loads imposed by the impact drums. The plot is derived from the recorded deceleration of the impact drums and the GPS locations of each impact point. High response values are typically a function of the sub-grade stiffness to a depth of the strain induced by the impact drums. The low and medium response values can be influenced by near surface soil conditions and do not necessarily indicate weaker sub-grade stiffness to a comparative depth. The low and medium response areas should be further investigated by a geotechnical engineer to confirm the suitability of the sub-grade.



PO BOX 132, Seven Hills, NSW 1730
(02) 9838 7044; 1300 237 045

Drawn: SD Date: 08/11/2015
Ckd: SD Date: 10/11/2015

This document is subject to the copyright of Landpac Technologies and its contents should not be used without written permission from Landpac

Project:
PRESTONS SOUTH

Drawing Title
FINAL CIR (Soil Response) Plot

Drg. No: Prestons-029

REV-A

