NOTES:
AS BUILT INFORMATION HAS BEEN SUPPLIED BY KBs CONTRACTING & QUARRIES LTD - JANUARY 2014
HEIGHTS ARE IN TERMS OF MEAN SEA LEVEL
ALL LATERALS ARE 100mmØ uPVC

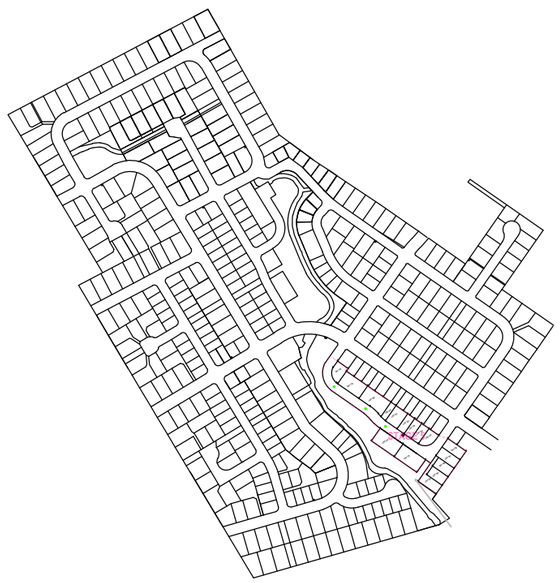

LOCATION PLAN

00/00/00

aurecon
www.aurecongroup.com

CLIENT	REV	DATE	REVISION DETAILS	APPROVED
	A	20.02.14	AS BUILTS ISSUED	

DRAWN	DESIGNED
A COLUMBUS	M CROWE
CHECKED	
D WATSON	
APPROVED	DATE
B TOMS	

PROJECT
STONEBROOK ROLLESTON

TITLE
STAGE 5
SEWER
AS BUILTS

AS BUILT

PROJECT No.	
224926	
SCALE	SIZE
1:1000	A3
DRAWING No.	REV
DW-LD-S2-AB-SS-01	A