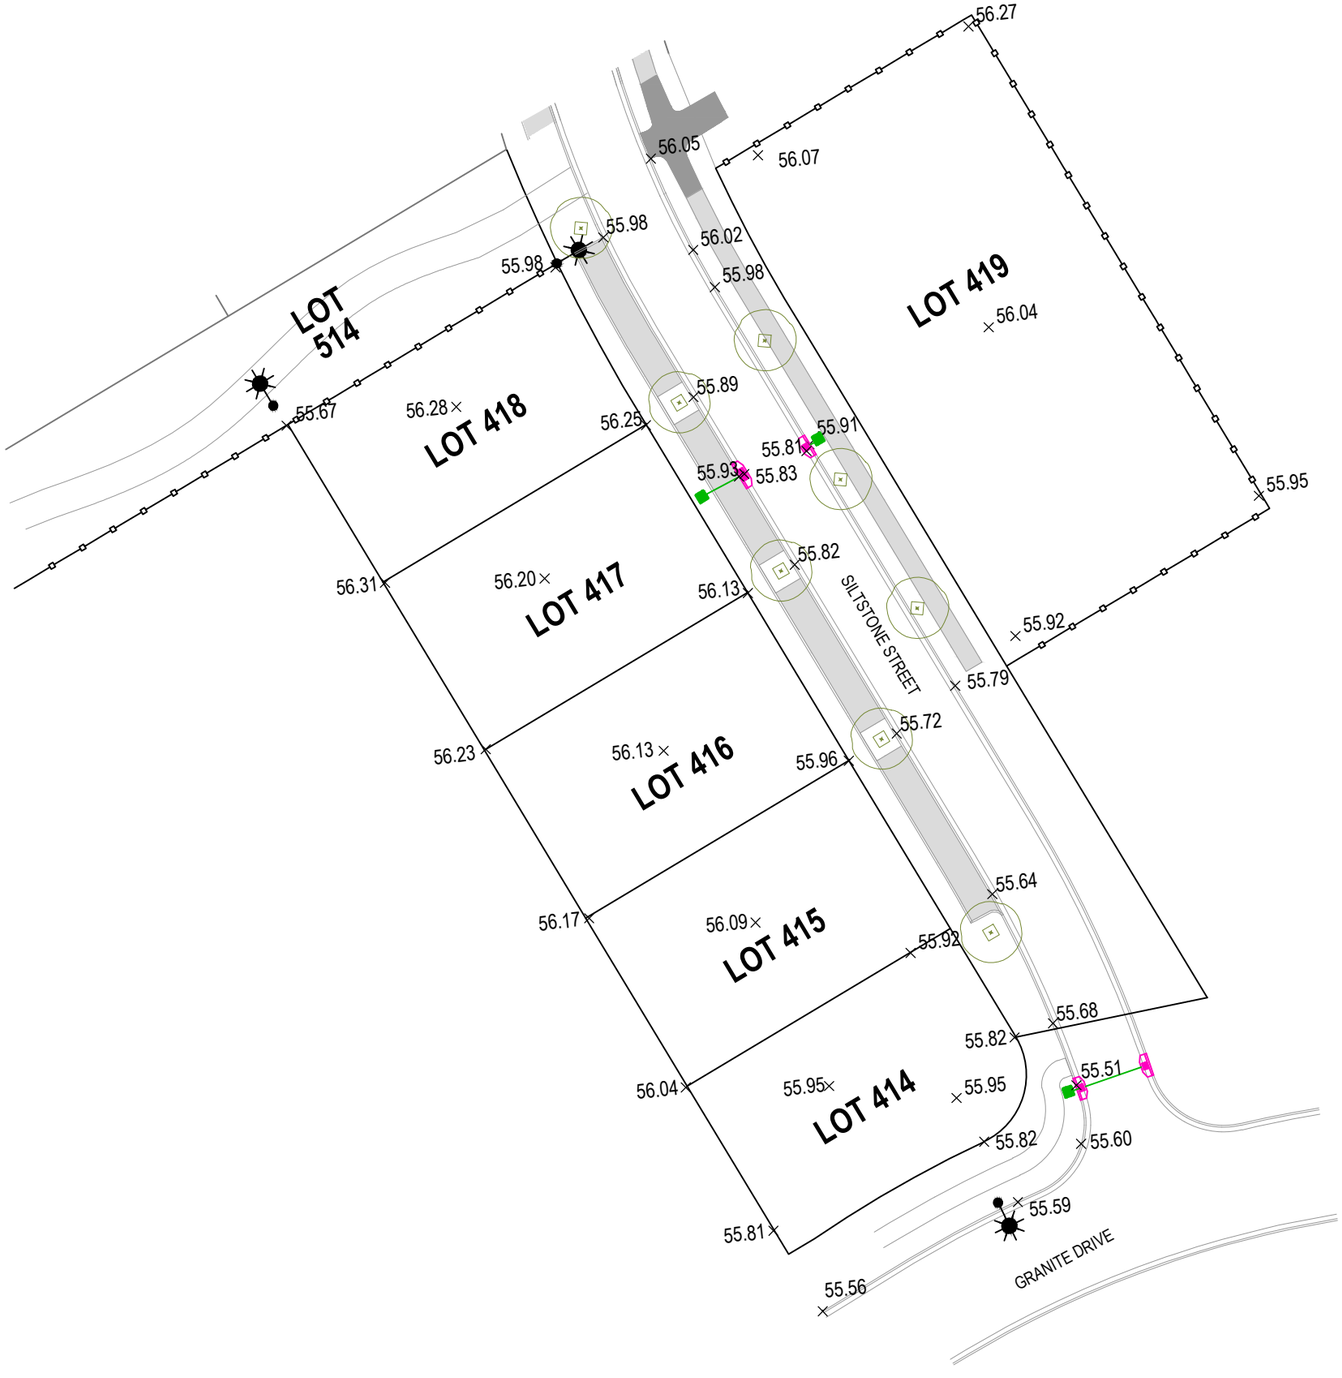

LEGEND

- STREET LIGHT
- PROPOSED TREE
- SUMP
- SOAK PIT

SURVEY ORIGIN DATA

VERTICAL ELEVATIONS ARE IN TERMS OF LYTTELTON VERTICAL DATUM 1937.
THE ORIGIN OF LEVELS IS ACE5 RL 57.679m.

HORIZONTAL COORDINATES ARE IN TERMS OF NZ GEODETIC DATUM 2000, MOUNT PLEASANT 2000 CIRCUIT.
THE ORIGIN OF SURVEY IS IS I DP361539
(798707.47mN 370018.15mE)

THE BOUNDARIES ON THIS PLAN SHOULD NOT BE RELIED UPON BY THEMSELVES, BUT MUST BE VERIFIED AGAINST THE LEGAL SURVEY PLAN BOUNDARIES TO CONFIRM THEIR ACCURACY.

10 0 20 40m
SCALE 1:1000

00/00/00

aurecon
www.aurecongroup.com

CLIENT
CDL LAND NEW ZEALAND LIMITED

REV	DATE	REVISION DETAILS	APPROVED
A	12.06.14	PRELIMINARY ISSUE	B.TOMS

DRAWN	DESIGNED
A.GRAY	M.CROWE

CHECKED: D.WATSON
APPROVED: B.TOMS DATE 12.06.14
B.TOMS

PROJECT: STONEBROOK ROLLESTON
TITLE: SITE LEVELS LOTS 414 - 418

AS BUILTS
PROJECT No.: 224926
SCALE: 1:500 SIZE: A3
DRAWING No.: DW-SU-12 REV: A