CDL STONEBROOK 24055.390.99

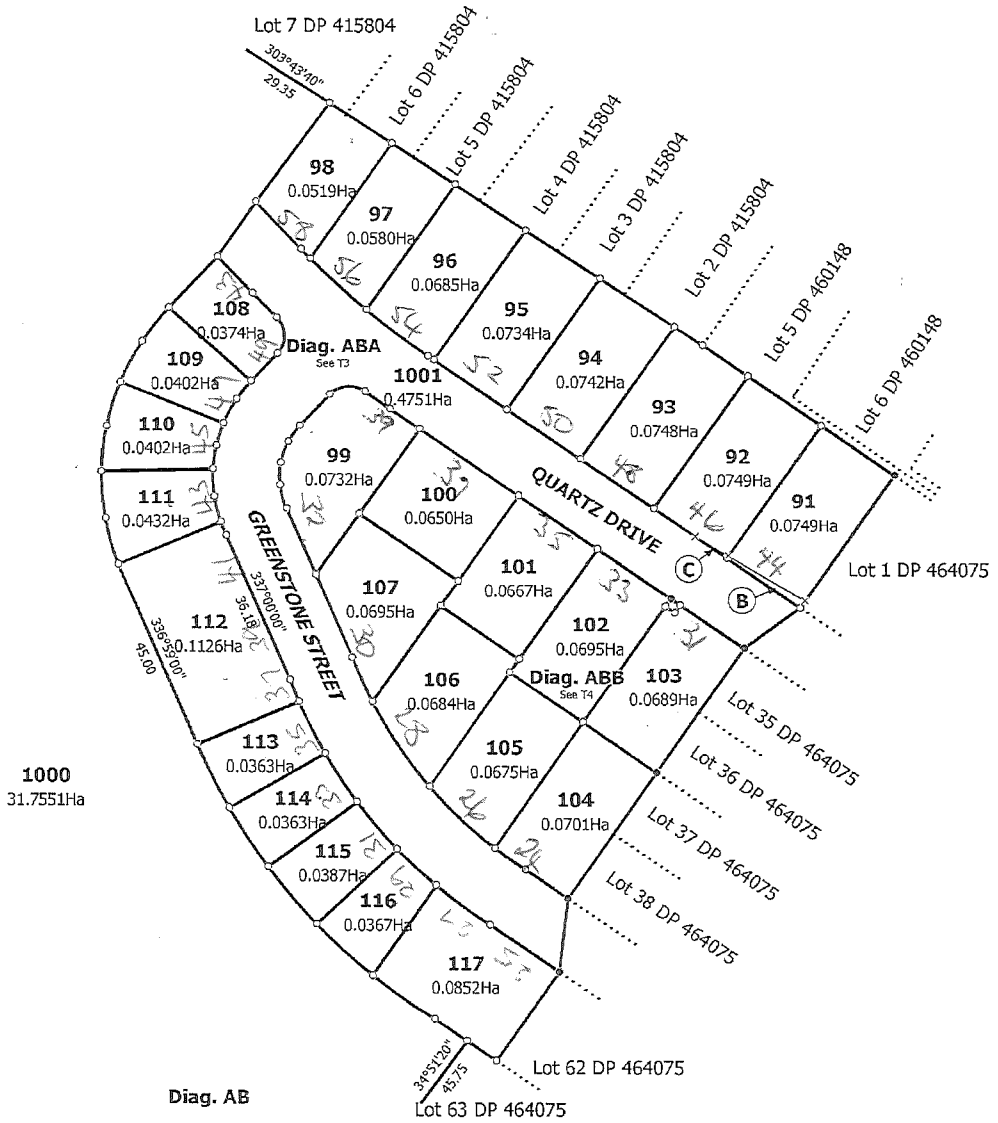

135261

STG 4

1090

9/1/13

27 RES LOTS

C/C . 4/12/13

Ref 224926-002

T 2/5

Land District Canterbury Digitally Generated Plan Generated on: 07/11/2013 09:44am Page 5 of 8	Lots 91 - 117, 1000 and 1001 being subdivision of Lot 1000 DP 464075	Surveyor: Melisa Jayne Crowe Firm: Aurecon (Christchurch)	Title Plan LT 470120 DRAFT